



New Bid Date and Time 3:00 PM, Wednesday, May 30, 2012

ADDENDUM 2

Project Name: **Hale Stadium Renovations
Tennessee State University**
Owner: **Tennessee Board of Regents**
Address: **Office of Facilities Development
Suite 664 (6th Floor, southwest) Genesco Office Park
1415 Murfreesboro Road
Nashville, TN 37217-2833**
City, State:
Project Number **SBC #166/002-02-2011
HFR# 2011171.00**
Date: **May 18, 2012**
From: **HFR Design, Inc.
7101 Executive Center Drive, Suite 300
Brentwood, TN 37027**



To: Prospective Bidders

This addendum forms part of the Contract Documents and modifies the original Bidding Documents dated April 25, 2012 and Addendum No 1, dated May 11, 2012, as noted below. Acknowledge receipt of this Addendum in the space provided on the Bid Form. Failure to do so may subject Bidder to disqualification.

This Addendum consists of 5 pages and the following attached Documents:

Bid Envelope Cover	1 page
Revised Specification Section: Document 005213 – Agreement	4 pages

Drawings (22"x34")(PLEASE NOTE THE DOCUMENTS LISTED BELOW REPLACE ORIGINAL DOCUMENTS UNLESS OTHERWISE NOTED):

- G0.00: (No Changes from Original Issued)
- G1.00
- C0.01: (No Changes from Original Issued)
- C0.02: (No Changes from Original Issued)

C0.03
C0.04
C1.00: (No Changes from Original Issued)
C1.01
C1.02
C2.00: (No Changes from Original Issued)
C2.01
C2.02
C2.03: (New Sheet)
C2.04: (New Sheet)
C2.05: (New Sheet)
C2.06: (New Sheet)
C2.07: (New Sheet)
C4.01: (No Changes from Original Issued)
C4.02
C4.03
C4.04
C4.05: (New Sheet)
A1.01
A1.02
A1.03: (No Changes from Original Issued)
A1.04: (No Changes from Original Issued)
M1.01
E0.00
E0.01
E0.02
E1.01
E2.01

CHANGES TO THE BIDDING REQUIREMENTS:

- 2-1. Invitation to Bid – Change the bid date and time to **3:00 PM, Wednesday, May 30, 2012.**
- 2-2. Bid Envelope cover - Attach onto sealed envelope and fill in appropriately.

CHANGES TO CONDITIONS OF THE CONTRACT:

- 2-3. Document 005213 – Agreement: Delete Document as originally issues and replace with the attached document.

CHANGES TO THE SPECIFICATONS:

- 2-4. Section 055000 – Metal Fabrications: Add the following Article:
“2.6 Signage Structure
A. Provide support structure for “TIGERS” sign as indicated on Drawings.
B. Steel shall be as specified in this Section except do not hot galvanize.
C. Prepare surface and prime per Section 101400.
D. Field finish sign structure according to Section 099000.”
- 2-5. Section 099000 – Paints and Coatings: Add the following to Article 3.9 Schedule Exterior Surfaces;
“B. Cold Galvanized Metal, Shop Primed – Gloss:
1. Touch up with Organic Zinc Primer as required.
2. Two coats of Alkyd, Exterior, Glass; finish coats. ”
- 2-6. Section 101400 – Signage: Modify as Follows: Reference Article 2.2.B - Change to read as follows: “Produce cast or cut units with smooth...”.
- 2-7. Section 101400 – Signage:
A. Delete Paragraph 2.2.B.2.
B. Reference Article 2.2.C – Delete items 2.2.C.2 and 2.2.C.3.
C. Reference Paragraph 2.5.C.2 – Change to read as follows: “Primer: Organic Zinc Rich Primer: Green or reddish-gray; lead and chromate free; 61% solids by volume minimum; 83% minimum metallic zinc content by weight in dry applied film; 2.68 maximum lbs/gal VOC; 2.5 mils minimum DFT.”
D. Add the following to Article 2.5.C Finishes, General;
“3. Field painted under Section 090000.”
- 2-8. Section 122413 – Roller Window Shades: Add Paragraph Article 3.4 Schedules, to read as follows: “A. Provide 3 shades to span width of storefront. (1) with nominal dimension of 6'-0" wide X 3'-10" high and (2) with nominal dimension of 4'-4" wide X 3'-10" high.”
- 2-9. Section 323223 – Segmental Retaining Walls: Delete the section in its entirety.

CHANGES TO THE DRAWINGS:

- 2-10. Drawing G1.00: Delete drawing G1.00 as originally issued and replace with attached drawing dated 5/17/12

- 2-11. Drawing C0.03: Delete note for removal of existing poles.
- 2-12. Drawing C0.04:
 - A. Add removal of pavement to driveway north of the east grandstand to accommodate electrical trenching and repair of pothole.
 - B. Add the removal of the existing 18" CMP in the bio-retention area.
- 2-13. Drawing C1.01:
 - A. Delete gate at top of access driveway, add post with chain per detail.
 - B. Add detail callout for stone column
 - C. Revised the detail callout for the removable bollards.
- 2-14. Drawing C1.02:
 - A. Add trench repair and asphalt overlay to driveway north of the east grandstand.
 - B. Add three trees to bio-retention area.
- 2-15. Drawing C2.01:
 - A. Connect 1" copper water line to ticket booth from existing water line.
 - B. Revise location of storm line connection for downspout.
- 2-16. Drawing C2.02: Revised limits, grading and added 12" perforated pipe for bio-retention area.
- 2-17. Drawing C2.03: Added sheet.
- 2-18. Drawing C2.04: Added sheet.
- 2-19. Drawing C2.05: Added sheet.
- 2-20. Drawing C2.06: Added sheet.
- 2-21. Drawing C2.07: Added sheet.
- 2-22. Drawing C4.02: Modified detail for handrail footing and paint requirements.
- 2-23. Drawing C4.03: Deleted detail for gate and replaced with detail for fence post with chain.
- 2-24. Drawing C4.04: Added detail for temporary construction entrance.
- 2-25. Drawing C4.05: Added sheet.

- 2-26. Drawing A1.01: Delete drawing A1.01 as originally issued and replace with attached drawing dated 5/17/12.
- 2-27. Drawing A1.02: Delete drawing A1.02 as originally issued and replace with attached drawing dated 5/17/12.
- 2-28. Drawing M1.01:
 - A. Revise location of through the wall unit per included drawing.
 - B. Add hose bib to south ticket booth.
- 2-29. Drawing E0.00: Revise all riser diagrams per included drawing.
- 2-30. Drawing E0.01: Revise electrical distribution to Ticket Booth, Scoreboard, and Concession Tent and revise light pole layout per included drawing.
- 2-31. Drawing E0.02: Revise electrical distribution to Ticket Booth, Scoreboard, and Concession Tent per included drawing.
- 2-32. Drawing E1.01: Revise specification of the E1A light pole per included drawing.
- 2-33. Drawing E2.01: Revise electrical receptacle for the air conditioner in the Ticket Booth per included drawing.

END OF ADDENDUM No. 2

Bid

to the

State of Tennessee

Tennessee Board of Regents

for

PROJECT: _____

Project Number: _____

Designer: _____

Time _____

Date _____



Any blank spaces may cause bid to be unacceptable and rejected.

Bidder Identification:

Bidder _____

Address _____

Tennessee Contractor License information:

Provide complete information if licensed, or check here ☐ if Bidder unlicensed.

License Number _____

License Classification applicable to Project _____

License expiration date _____ \$(_____)
Dollar Limit

If work is required for Electrical, Plumbing, HVAC, or Geothermal, Masonry, list subcontractor(s) that will perform that work. If Bidder will perform that work with Bidder's own forces, fill in Bidder's name as subcontractor. If there is no work in a category, write "None Required" in the space. If acceptance of alternate or combination of alternates changes subcontractor, so indicate. Provide state contractor license number, expiration date, and applicable classifications for bidder and listed subcontractors. If value of subcontractor's work is such that no license is required, and subcontractor is unlicensed, fill in "N/A" in the license number column, but still fill in name. Please provide all names in the same style as used for licensing and other legal transactions, without embellishment

Subcontractors to be used on this Project:

Provide the following for each listed subcontractor

	Name	License Number	Expires	Classification
Electrical				
Plumbing				
HVAC				
Geothermal				
Masonry				

This Bid Envelope approved for public opening _____

Signature of Designer or their representative



Agreement

Between Owner and Contractor

where the Basis of Payment is a
STIPULATED SUM

Use only with the coordinated documents identified in the current
Designers' Manual
for projects of the State Building Commission of Tennessee and the Tennessee Board of Regents

AGREEMENT

made as of the _____ day of _____ in the year of _____

BETWEEN the Owner: **STATE OF TENNESSEE**
via the Contracting Agency: **Tennessee Board of Regents**

and the Contractor:

the Project:

the Designer:

The Owner and the Contractor agree as set forth below.

ARTICLE 1

THE WORK AND THE CONTRACT DOCUMENTS

- 1.1** The Contractor shall perform all the Work required by the Contract Documents for the Project identified on page one.
- 1.2** The Contract Documents are identified in the Conditions of the Contract (General, Supplementary, and other Conditions). These form the Contract and constitute the entire agreement between the Owner and the Contractor, and are as fully a part of the Contract as if attached to this Agreement or repeated herein. An enumeration of the Contract Documents appears in paragraph 1.4.
- 1.3** Terms used in this Agreement which are defined in the Conditions of the Contract shall have the meanings designated in those Conditions.
- 1.4** The Contract Documents, except for Modifications issued after execution of this Agreement, are enumerated as follows:

ARTICLE 2
TIME OF COMMENCEMENT AND SUBSTANTIAL COMPLETION

- 2.1** The Work to be performed under this Contract shall be commenced on the date stipulated in the Notice to Proceed; and, subject to authorized adjustments, Substantial Completion shall be achieved
- 2.2** Liquidated Damages, as set forth in paragraph 9.12 of the Conditions of the Contract, are

ARTICLE 3
CONTRACT SUM

- 3.1** The Owner shall pay the Contractor in current funds for the performance of the Work, subject to additions and deductions by Change Order as provided in the Contract Documents, the Contract Sum of
- 3.2** The Contract Sum is determined as follows:
- 3.3** The following Unit Prices will be used as specified:

This Agreement entered into as of the day and year first written above as witnessed:

BY CONTRACTOR:

Signature: _____

Name: _____

Title: _____

**AND BY OWNER: STATE OF TENNESSEE
Tennessee Board of Regents**

APPROVED: _____

APPROVED: _____

APPROVED: _____

BY: _____

END of AGREEMENT FORM for the Project titled:

TENNESSEE BOARD of REGENTS

HALE STADIUM RENOVATIONS, NORTH AND SOUTH ENTRIES

for
TENNESSEE STATE UNIVERSITY

at
NASHVILLE, TENNESSEE

APRIL 25, 2012


SBC NO 166/ 001-02-2011

HFR PROJECT NO. 201171.00




CAMPUS MAP

NOT TO SCALE

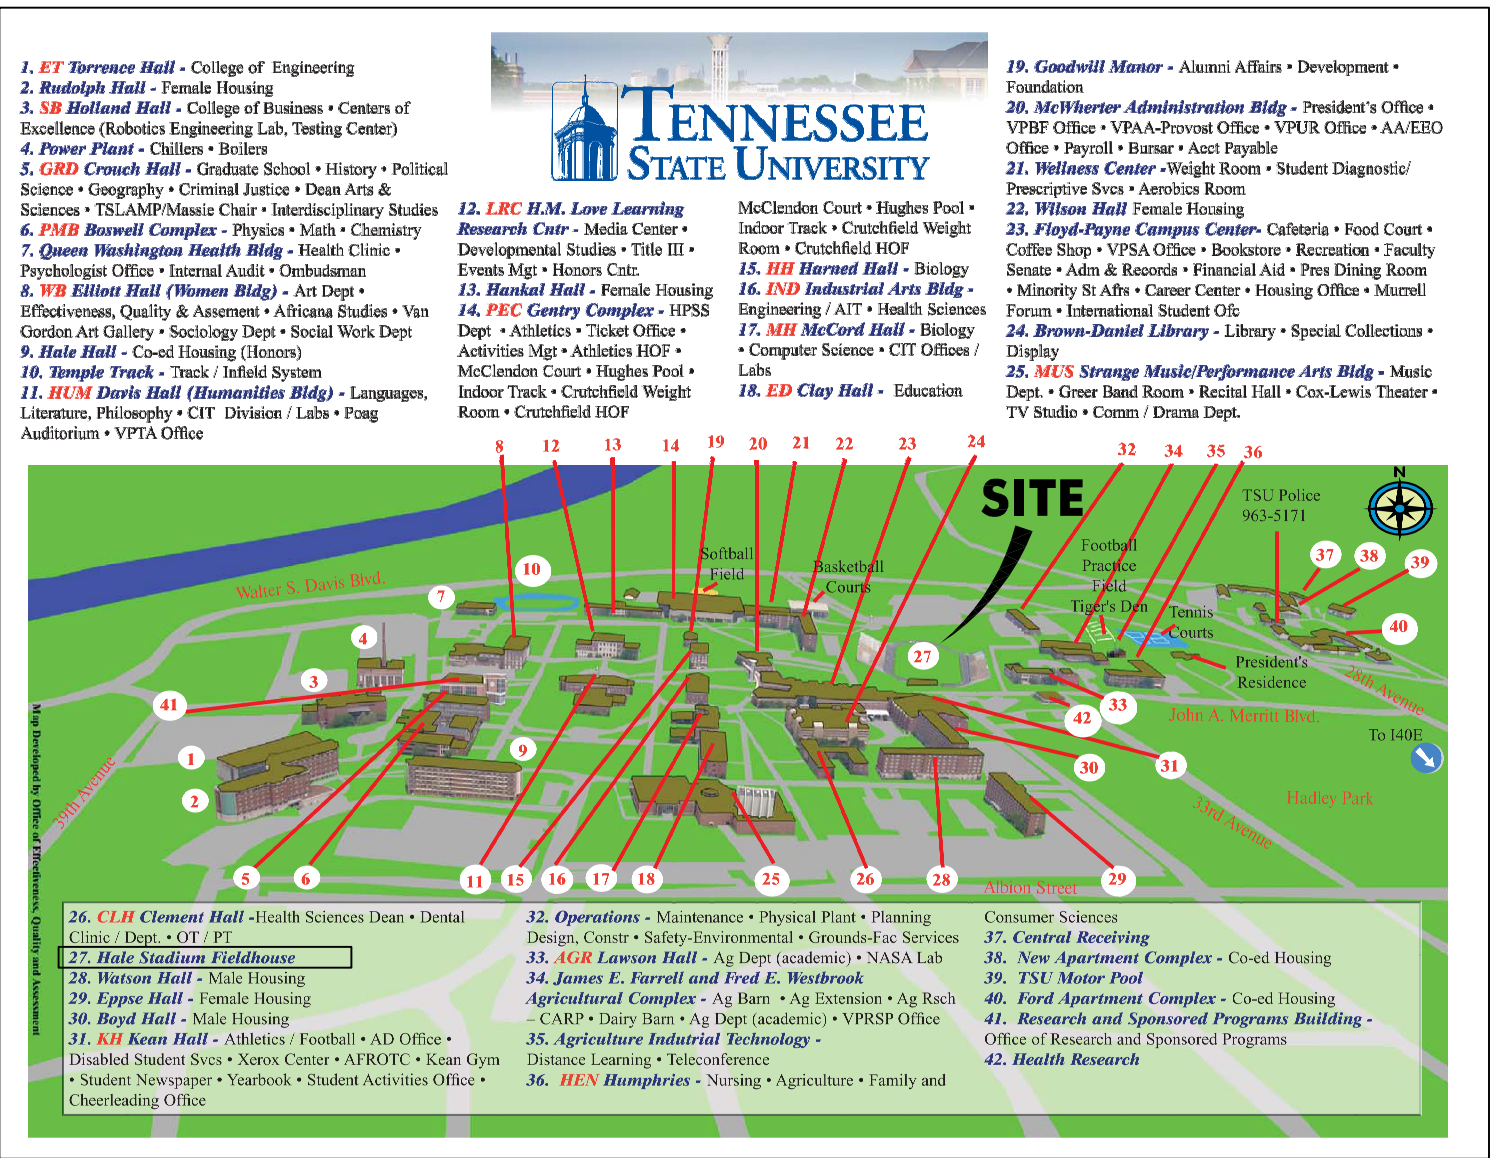

MATERIAL CONTAINING ASBESTOS OR PCB WILL NOT BE PERMITTED TO BE INCORPORATED INTO THIS PROJECT.

1. ALL DISTANCES WERE MEASURED WITH E.D.M. EQUIPMENT AND HAVE BEEN ADJUSTED FOR TEMPERATURE.
2. UTILITIES HAVE BEEN PLOTTED FROM SURFACE FEATURES AND MARKINGS FOUND AT THE TIME OF SURVEY AND AVAILABLE MAPS AND RECORDS. THERE MAY BE OTHER UTILITIES, THE EXISTENCE OF WHICH ARE NOT KNOWN TO THE UNDERSIGNED. SIZE AND LOCATION OF ALL UNDERGROUND UTILITIES MUST BE VERIFIED BY THE APPROPRIATE UTILITY COMPANY PRIOR TO ANY CONSTRUCTION.
- 3) ELEVATIONS AND CONTOURS WERE DERIVED USING RADIAL TRIGONOMETRY AND DTM METHODS. CONTOUR INTERVALS ARE ONE (1) FOOT. ELEVATIONS TIED TO NAVD 88.

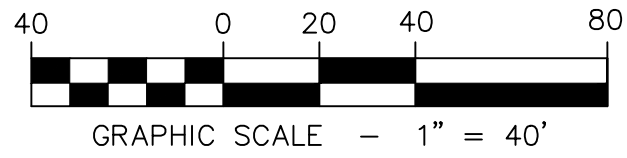


HFR DESIGN

ARCHITECTURE
ENGINEERING
PLANNING
INTERIORS

HART FREELAND ROBERTS, INC.
7101 Executive Center Drive
Suite 300
Brentwood, TN 37024

615.370.8500 phone
615.370.8530 fax
www.hfrdesign.com web

Nashville, Tennessee
Jackson, Tennessee
Kansas City, Missouri
Louisville, Kentucky

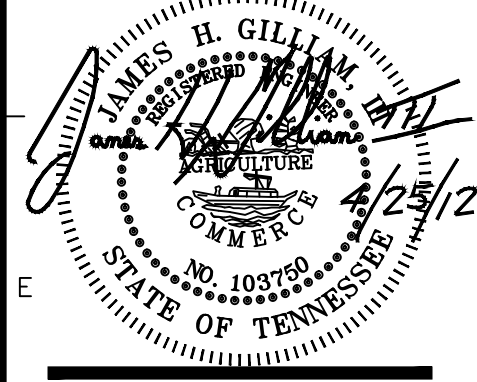

HALE STADIUM RENOVATIONS
NORTH AND SOUTH ENTRIES
TENNESSEE STATE UNIVERSITY
JOHN A MERRITT BLVD
NASHVILLE, TN
SBC# 166/001-02-2011

PROJ. NO.: 2011171

DATE: 25 APRIL 2012

EXISTING
CONDITIONS

C0.01

TREE TABLE

NO.	SIZE	TYPE
3	14"	PERSIMMON
4	18"	MAGNOLIA
5	12"	MAPLE
6	20"	TREE
7	14"	TREE
8	10"	TREE
9	8"	TREE
10	8"	TREE
11	8"	TREE

LEGEND

WATER VALVE
CLEAN-OUT
LANDSCAPE
GAS METER
WATER METER
FIRE HYDRANT
SIGN POST
CATCH BASIN
CURB INLET
MANHOLE
UTILITY POLE
LIGHT POLE
TREE
HANDICAP PARKING SPACE

C.O.
LS
HC

EDGE OF PAVEMENT
EDGE OF CONC.
CURB
WATER LINE
SEWER LINE
GAS LINE
STORM SEWER/CULVERT
EASEMENT LINE
FENCE
PARKING STRIPE
BUILDING LINE
OVERHEAD UTILITY
CONTOUR LINE

W
S
G
54" RCP
X
X
OH
475

DRAINAGE STRUCTURE TABLE

NO.	TYPE	T.C.	INV.
D1	CURB INLET (SIN)	446.6	442.4
D2	MANHOLE	448.0	412.3
D3	CATCH BASIN (SIN)	448.9	445.2
D4	MANHOLE STORM	448.3	434.5
D5	MANHOLE	447.7	435.6
D6	MANHOLE	446.1	435.1 OUT 411.8
D7	CURB INLET (DOU)	468.4	465.9
D8	CURB INLET (SIN)	468.2	466.1
D9	CATCH BASIN (SIN)	468.5	460.4
D10	CATCH BASIN (SIN)	468.7	464.7
D11	CURB INLET (SIN)	468.5	465.5
D12	CATCH BASIN (SIN)	468.0	465.3
D13	CATCH BASIN (SIN)	470.3	467.1
D14	MANHOLE STORM	468.9	444.8
D15	MANHOLE STORM	469.4	460.3
D16	CURB INLET (SIN)	468.9	464.9
D17	CURB INLET (SIN)	470.3	464.5
D18	CURB INLET (DOU)	468.5	466.0

DRAINAGE STRUCTURE TABLE

NO.	TYPE	T.C.	INV.
D19	CURB INLET (SIN)	471.9	469.4
D20	CURB INLET (SIN)	473.7	468.5
D21	MANHOLE	472.6	467.4
D22	MANHOLE	473.2	468.35
D23	CATCH BASIN (SIN)	476.0	471.7
D24	CATCH BASIN (SIN)	469.1	461.4
D25	INVERT 2" P.V.C.	N/A	468.9
D26	MANHOLE STORM	472.7	462.7
D27	CATCH BASIN (SIN)	473.8	467.8
D28	CATCH BASIN (SIN)	471.0	469.9
D29	MANHOLE	473.0	465.2(W) 465.1(N&S) 465.0(NE)OUT
D30	MANHOLE	472.5	466.4(S) 465.4(E) 466.3(N)OUT
D31	MANHOLE STORM	476.0	470.2
D32	CURB INLET (DOU)	475.5	471.5
D33	CURB INLET (SIN)	476.0	473.7
D34	MANHOLE	484.1	475.35(N) 475.3(S)OUT
D35	MANHOLE	485.8	481.1(NW) 480.9(S)OUT

DRAINAGE STRUCTURE TABLE

NO.	TYPE	T.C.	INV.
D36	MANHOLE VALVE	468.7	N/A
D37	MANHOLE VALVE	478.0	N/A
D38	INVERT 2" P.V.C.	N/A	468.7
D39	CATCH BASIN (SIN)	461.8	457.8
D40	CATCH BASIN (SIN)	464.8	461.1
D41	CATCH BASIN (SIN)	466.7	463.2
D42	CATCH BASIN (SIN)	461.1	459.0
D43	MANHOLE	455.3	450.4(W) 450.3(E)OUT
D44	MANHOLE	451.6	447.2(W) 445.8(E)OUT
D45	CATCH BASIN (DOU)	451.4	446.3
D46	MANHOLE VALVE	473.8	N/A
D47	MANHOLE VALVE	467.7	N/A
D48	CATCH BASIN (SIN)	451.3	445.4
D49	CATCH BASIN (SIN)	452.0	449.5
D50	INVERT 30" R.C.P.	N/A	447.7
D51	CATCH BASIN (SIN)	450.5	444.1
D52	CATCH BASIN (SIN)	450.8	447.2
D53	CATCH BASIN (SIN)	450.7	446.7

DRAINAGE STRUCTURE TABLE

NO.	TYPE	T.C.	INV.
D54	CATCH BASIN (SIN)	450.9	444.1
D55	CATCH BASIN (SIN)	450.8	448.0
D56	CATCH BASIN (SIN)	450.8	448.6
D57	CATCH BASIN (SIN)	450.8	449.2
D58	CATCH BASIN (SIN)	450.9	446.0
D59	CATCH BASIN (SIN)	450.7	445.2
D60	CATCH BASIN (SIN)	450.7	448.5
D61	CATCH BASIN (SIN)	450.6	447.8
D62	CATCH BASIN (SIN)	450.8	447.5
D63	CATCH BASIN (SIN)	450.6	446.8
D64	CATCH BASIN (SIN)	450.7	445.9
D65	CATCH BASIN (SIN)	450.0	444.8
D66	CATCH BASIN (SIN)	453.2	450.4
D67	INVERT 54" R.C.P.	N/A	429.7
D68	CATCH BASIN (SIN)	448.1	444.5
D69	CATCH BASIN (SIN)	450.7	450.7
D70	CATCH BASIN (SIN)	450.5	447.7
D71	CATCH BASIN (SIN)	450.5	447.7
D72	CATCH BASIN (SIN)	449.7	445.2

PLOT DATE: 5/19/2012 2:49:58 PM (GOODSON)
© COPYRIGHT 2012 - ALL RIGHTS RESERVED. NO PORTIONS OF THIS DOCUMENT MAY BE REPRODUCED WITHOUT THE EXPRESSED WRITTEN CONSENT OF HART FREELAND ROBERTS, INC.

- 1 | 2 | 3 | 4
- DEMOLITION NOTES
1. DEMOLITION AND REMOVAL OPERATIONS SHALL COMMENCE ONLY AFTER ALL EROSION AND SEDIMENTATION CONTROL MEASURES ARE IN PLACE AND FUNCTIONAL.
2. PROVIDE NEAT AND STRAIGHT SAW CUTS OF EXISTING PAVEMENT ALONG ALL LIMITS OF PAVEMENT DEMOLITION.
3. ALL DEMOLISHED MATERIALS BECOME THE PROPERTY OF THE CONTRACTOR UNLESS OTHERWISE DESIGNATED. DISPOSE OF OFF THE OWNER'S PROPERTY IN A LEGAL MANNER
4. ALL PAVEMENT BASE COURSES, SIDEWALK, CURBS, BUILDINGS, FOUNDATIONS, ETC. IN THE AREA TO BE REMOVED SHALL BE REMOVED TO FULL DEPTH. EXISTING BASE COURSE MATERIALS MAY BE WORKED INTO THE NEW PAVEMENT OR BUILDING SUBGRADE PROVIDED THAT THE GRADATION, CONSISTENCY, COMPACTION, SUBGRADE CONDITION, ETC. ARE IN ACCORDANCE WITH THE SPECIFICATIONS. BASE COURSE MATERIALS SHALL NOT BE WORKED INTO THE SUBGRADE OF AREAS TO RECEIVE PLANTING.
5. CONTRACTOR SHALL OBTAIN ALL PERMITS REQUIRED FOR EXECUTION OF THE WORK.
6. THE CONTRACTOR SHALL USE WATER SPRINKLING AND OTHER SUITABLE METHODS AS NECESSARY TO CONTROL DUST AND DIRT CAUSED BY THE DEMOLITION WORK.
7. ALL ITEMS OF CONSTRUCTION REMAINING AND SPECIFICALLY MENTIONED THAT INTERFERE WITH THE NEW CONSTRUCTION SHALL BE IMMEDIATELY BROUGHT TO THE ATTENTION OF THE DESIGNER.
8. CONTRACTOR SHALL PROVIDE PROTECTION TO ALL STREETS, FENCES, TREES, UTILITIES AND STRUCTURES THAT ARE TO REMAIN. CONTRACTOR-CAUSED DAMAGE SHALL BE REPAIRED TO MATCH EXISTING AT NO ADDITIONAL COST TO THE OWNER.
9. CAVITIES LEFT BY STRUCTURE REMOVAL SHALL BE BACKFILLED WITH SATISFACTORY MATERIAL AND COMPACTED TO 98% OF MAXIMUM DENSITY PER ASTM D698.
10. CONTRACTOR SHALL LOCATE AND MARK ALL EXISTING UTILITIES PRIOR TO COMMENCING WORK. COORDINATE WITH LOCAL UTILITY COMPANIES PRIOR TO UTILITY DISCONNECT.
11. NOTIFY LOCAL UTILITY LOCATOR SERVICE OF INTENDED DEMOLITION OPERATIONS. SEE GENERAL UTILITY NOTE #4 ON SHEET C0.02 FOR PHONE NUMBER.
12. EXISTING INFORMATION/TOPOGRAPHIC SURVEY WAS PREPARED BY HART FREELAND ROBERTS, INC. ON 12/22/2011.
13. PAVEMENT MARKINGS TO BE REMOVED SHALL BE PAINTED OVER TO MATCH PAVEMENT OR REMOVED WITH WIRE BRUSHING.
14. EXCEPT AS SHOWN, NO TREES SHALL BE REMOVED AND/OR VEGETATION DISTURBED WITHOUT APPROVAL OF THE DESIGNER.

- LAYOUT & PAVING NOTES
1. THE CONTRACTOR SHALL CHECK EXISTING GRADES, DIMENSIONS, AND INVERTS IN THE FIELD AND REPORT ANY DISCREPANCIES TO THE DESIGNER PRIOR TO BEGINNING WORK.
2. THE CONTRACTOR SHALL VERIFY THE EXACT LOCATION OF ALL EXISTING UTILITIES, INCLUDING IRRIGATION LINES. TAKE CARE TO PROTECT UTILITIES THAT ARE TO REMAIN, AND REPAIR CONTRACTOR-CAUSED DAMAGE ACCORDING TO CURRENT LOCAL STANDARDS AND AT THE CONTRACTOR'S EXPENSE. COORDINATE ALL CONSTRUCTION WITH THE APPROPRIATE UTILITY COMPANY. RELOCATE IRRIGATION LINES AS NECESSARY FOR CONSTRUCTION.
3. THE CONTRACTOR SHALL COMPLY WITH ALL LOCAL CODES, OBTAIN ALL PERMITS AND PAY ALL FEES PRIOR TO BEGINNING WORK.
4. PROVIDE A SMOOTH TRANSITION BETWEEN EXISTING PAVEMENT AND NEW PAVEMENT. FIELD ADJUSTMENT OF FINAL GRADES MAY BE NECESSARY. INSTALL ALL UTILITIES PRIOR TO INSTALLATION OF PAVEMENT.
5. THE CONTRACTOR SHALL PROTECT ALL TREES TO REMAIN IN ACCORDANCE WITH THE SPECIFICATIONS. DO NOT OPERATE OR STORE HEAVY EQUIPMENT, NOR HANDLE OR STORE MATERIALS, WITHIN THE DRIPLINES OF TREES OR OUTSIDE THE LIMIT OF GRADING.
6. CONCRETE WALKS AND PADS SHALL HAVE A BROOM FINISH UNLESS OTHERWISE NOTED. ALL CONCRETE SHALL BE 4,000 P.S.I. UNLESS OTHERWISE NOTED, CURB RAMPS, SIDEWALK SLOPES, AND DRIVEWAY RAMPS SHALL BE CONSTRUCTED IN ACCORDANCE WITH ALL CURRENT LOCAL REQUIREMENTS. IF APPLICABLE, THE CONTRACTOR SHALL REQUEST INSPECTION OF SIDEWALK AND RAMP FORMS PRIOR TO PLACEMENT OF CONCRETE.
7. ALL DAMAGE TO EXISTING ASPHALT PAVEMENT TO REMAIN WHICH RESULTS FROM NEW CONSTRUCTION SHALL BE REPLACED WITH LIKE MATERIALS AT CONTRACTOR'S EXPENSE.
8. DIMENSIONS ARE TO THE FACE OF CURB, EDGE OF CONCRETE, OR TO THE FACE OF BUILDING UNLESS OTHERWISE NOTED.
9. COORDINATES ARE FOR FACE OF BUILDING, CENTER LINES OF DRIVEWAYS, CENTER OF SANITARY SEWER MANHOLES, AND CENTER AT FACE OF CURB ON CURB INLETS, UNLESS OTHERWISE NOTED.
10. EXCESS MATERIAL SHALL BE DISPOSED OF BY THE CONTRACTOR OFF THE OWNER'S PROPERTY AT NO ADDITIONAL COST, IN A LEGAL MANNER.
11. MAINTAIN ONE SET OF AS-BUILT DRAWINGS ON THE JOB SITE FOR DISTRIBUTION TO THE DESIGNER UPON COMPLETION.
12. PARKING STRIPES SHALL BE 4-INCH WHITE PAVEMENT PAINT.
13. CONTRACTION JOINTS SHALL BE HAND TROWELED TO A DEPTH OF AT LEAST ¼ THE CONCRETE THICKNESS AND SHALL DIVIDE CONCRETE AS INDICATED ON PLANS.
14. CONTRACTOR SHALL PROVIDE AS-BUILT ELEVATION SURVEY FOR ALL NEW SIDEWALK RAMPS.

STORMWATER POLLUTION PREVENTION NOTES

1. THE OWNER AND THE CONTRACTOR ARE REQUIRED TO SUBMIT A NOTICE OF INTENT (NOI) APPLICATION TO DISCHARGE CONSTRUCTION-ACTIVITY STORMWATER TO THE LOCAL TENNESSEE ENVIRONMENTAL ASSISTANCE CENTER AT LEAST 30 DAYS PRIOR TO BEGINNING CONSTRUCTION. THE CONTRACTOR AND OWNER SHALL PROVIDE (WITH THE NOI FOR THIS PROJECT) EXISTING NPDES PERMIT TRACKING NUMBERS FOR SITES WHERE BORROW MATERIAL MAY BE OBTAINED AND WHERE SPOIL MATERIAL MAY BE PLACED. SHOULD PERMITS NOT EXIST FOR BORROW AND SPOIL SITES, SEPARATE NOI'S SHALL BE PROVIDED BY THE OWNER AND CONTRACTOR.
2. THE NOTICE OF COVERAGE (NOC) OF THE PERMIT TO DISCHARGE CONSTRUCTION-ACTIVITY STORMWATER SHALL BE POSTED AT THE CONSTRUCTION ENTRANCE. THE CONTRACTOR SHALL HAVE A SET OF APPROVED EROSION CONTROL PLANS ON SITE DURING ALL CONSTRUCTION.
3. THE CONSTRUCTION ACTIVITY ANTICIPATED ON THIS PROJECT INCLUDES CLEARING, GRUBBING, GRADING, TOPSOIL PLACEMENT, AND SEEDING.
4. THE APPROXIMATE TOTAL AREA OF GRADING PROPOSED IS 1.10 ACRES.
5. THE ANTICIPATED FILL MATERIAL WILL CONSIST OF ON-SITE SOIL AND/OR SHOT ROCK MATERIALS.
6. THE RECEIVING WATER/STORM SEWER OPERATOR IS METRO NASHVILLE, TENNESSEE.
7. CONSTRUCTION SHALL BE SEQUENCED TO MINIMIZE EXPOSURE TIME OF CLEARED SURFACE AREA. EROSION AND SEDIMENT CONTROL MEASURES SHALL BE IN PLACE AND FUNCTIONAL PRIOR TO EARTH MOVING OPERATIONS. ALL CONTROL MEASURES SHALL BE CHECKED AND REPAIRED AS NECESSARY, AT MAXIMUM 7 CALENDAR DAYS IN DRY PERIODS, AND WITHIN 24 HOURS OF ANY RAINFALL EXCEEDING 0.25 INCH PER 24 HOUR PERIOD.
8. THE CONTRACTOR SHALL DESIGNATE IN WRITING THE NAME AND PHONE NUMBER OF THE INDIVIDUAL RESPONSIBLE FOR EROSION AND SEDIMENT CONTROLS.
9. PRE-CONSTRUCTION VEGETATIVE GROUND COVER SHALL NOT BE REMOVED MORE THAN 20 CALENDAR DAYS PRIOR TO GRADING. ALL GRADED AREAS EXPECTED TO REMAIN UNFINISHED AND UNWORKED FOR MORE THAN 7 CALENDAR DAYS SHALL BE COVERED WITH TEMPORARY GRASS, SOD, STRAW, MULCH OR FABRIC MATERIAL. PERMANENT SOIL STABILIZATION SHALL BE INSTALLED WITHIN 15 CALENDAR DAYS OF FINAL GRADING.
10. THE CONTRACTOR SHALL MAINTAIN RECORDS OF EROSION CONTROL INSPECTIONS AND REPAIRS FOR A MINIMUM OF 3 YEARS AFTER COMPLETION OF CONSTRUCTION.
11. TEMPORARY SEEDING FOR TENNESSEE PROJECTS INCLUDE THE FOLLOWING OPTIONS;

JAN 1-MAY 1 ITALIAN RYE/KOREAN LESPEDEZA/SUMMER OATS

MAY 1-JULY 15 SUDAN OR STARR MILLET

JULY 15-JAN 1 BALBOA RYE/ITALIAN RYE
12. MULCHING SHALL CONSIST OF LOOSE HAY OR STRAW APPLIED AT THE RATE OF 2 TONS/ACRE.
13. THE CONTRACTOR SHALL REMOVE SEDIMENT FROM TRAPS, SILT, FENCES, SEDIMENT PONDS, ETC. AS NECESSARY AND WHEN CAPACITY HAS BEEN REDUCED BY 50%.
14. STOCKPILES SHALL BE STABILIZED AND PROTECTED FROM EROSION.
15. UPON COMPLETION OF SITE STABILIZATION, THE OWNER AND CONTRACTOR SHALL PROVIDE A NOTICE OF TERMINATION (NOT) FOR THE PROJECT TO THE LOCAL ENVIRONMENTAL ASSISTANCE CENTER. A COPY OF THE NOT SHALL BE PROVIDED TO THE DESIGNER.
16. I CERTIFY UNDER PENALTY OF LAW THAT THESE STORMWATER POLLUTION PREVENTION PLANS WERE PREPARED UNDER MY DIRECTION OR SUPERVISION, AND BY QUALIFIED PERSONNEL WHO PROPERLY GATHERED AND EVALUATED THE INFORMATION SUBMITTED. THE INFORMATION SUBMITTED IS, TO THE BEST OF MY KNOWLEDGE AND BELIEF, TRUE, ACCURATE AND COMPLETE. I AM AWARE THAT THERE ARE SIGNIFICANT PENALTIES FOR SUBMITTING FALSE INFORMATION, INCLUDING THE POSSIBILITY OF FINE AND IMPRISONMENT.

- GENERAL UTILITY NOTES
1. WATER AND SEWER CONSTRUCTION SHALL BE PERFORMED IN ACCORDANCE WITH ALL LOCAL CODES AND SPECIFICATIONS.
2. THE CONTRACTOR SHALL PAY ALL FEES AND OBTAIN ALL PERMITS.
3. ALL EXISTING UNDERGROUND UTILITY LOCATIONS ARE APPROXIMATE AND ARE BASED ON TOPOGRAPHIC SURVEYS AND RECORD DRAWINGS FROM THE FACILITY. ADDITIONAL UTILITIES MAY BE PRESENT. SHOULD UNCHARTED UTILITIES BE ENCOUNTERED DURING EXCAVATION OPERATIONS, THE CONTRACTOR SHALL NOTIFY THE DESIGNER AS SOON AS POSSIBLE FOR INSTRUCTIONS.
4. THE CONTRACTOR SHALL NOTIFY THE TENNESSEE ONE-CALL SYSTEM, INC. (TOCS) AT 811 AND ANY NON-TOCS MEMBER UTILITY INDIVIDUALLY AT LEAST 3 WORKING DAYS PRIOR TO ANY EXCAVATION AND/OR DEMOLITION.
5. MAINTAIN 10-FOOT HORIZONTAL AND 18-INCH VERTICAL SEPARATION BETWEEN SANITARY SEWER AND WATER SUPPLY LINES.
6. CONTRACTOR SHALL VERIFY THE EXACT LOCATION OF ALL EXISTING UTILITIES INCLUDING IRRIGATION. TAKE CARE TO PROTECT UTILITIES THAT ARE TO REMAIN. REPAIR DAMAGE ACCORDING TO LOCAL STANDARDS AND AT THE CONTRACTOR'S EXPENSE. COORDINATE ALL CONSTRUCTION WITH THE APPROPRIATE UTILITY COMPANY. RELOCATE IRRIGATION LINES AS NECESSARY FOR CONSTRUCTION.
7. THE CONTRACTOR SHALL BE RESPONSIBLE FOR COORDINATING THE SEQUENCING OF CONSTRUCTION FOR ALL UTILITY LINES SO THAT WATER LINES AND UNDERGROUND ELECTRIC DO NOT CONFLICT WITH SANITARY SEWERS OR STORM SEWERS. INSTALL UTILITIES PRIOR TO FINAL PAVEMENT CONSTRUCTION.
8. BACKFILL UTILITY TRENCHES UNDER PAVEMENT AREAS WITH CRUSHED STONE OR GRAVEL. BACKFILL UTILITY TRENCHES IN LAWN AREAS WITH SATISFACTORY FILL MATERIAL COMPACTED TO AT LEAST 98% OF MAXIMUM PER ASTM D698.
9. ADJUST ALL EXISTING CASTINGS TO PROPOSED FINISH GRADE.
10. THRUST BLOCK ALL WATERLINE FITTINGS WITH CONCRETE (2,500 P.S.I. MIN.) POURED AGAINST UNDISTURBED EARTH TO SUSTAIN 120% TEST PRESSURE SPECIFIED. FORM THRUST BLOCKING SO AS TO NOT EMBED JOINTS, BOLTS, VALVE BOXES OR OPERATING NUTS.
11. PROVIDE VENTS AT HIGH POINTS IN WATERLINE AS NECESSARY FOR EXPELLING AIR DURING FILLING OF WATER LINE. PROVIDE BRONZE CORPORATION STOP FOR CLOSING VENT DURING TESTING AND SERVICE. LEAVE VENT COMPONENTS PLUGGED AND ATTACHED TO PIPE AFTER SUCCESSFUL TEST.
12. EXCESS MATERIAL SHALL BE DISPOSED OF BY THE CONTRACTOR OFF THE OWNER'S PROPERTY AT NO ADDITIONAL COST IN A LEGAL MANNER.
13. ALL SANITARY SEWER PIPE SHALL BE CLASS SDR 35 PVC UNLESS NOTED OTHERWISE.
14. PROVIDE AS-BUILT DRAWINGS WHICH INCLUDE AT LEAST TWO DIMENSIONS TO EACH VALVE AND MANHOLE FROM KNOWN SITE FEATURES. DRAWINGS SHALL INCLUDE VERTICAL AND HORIZONTAL INFORMATION ON ALL NEW UTILITIES AS WELL AS EXISTING UTILITIES ENCOUNTERED.

- GRADING, DRAINAGE AND EROSION CONTROL NOTES
1. NO TREES SHALL BE REMOVED NOR VEGETATION DISTURBED EXCEPT AS NECESSARY FOR GRADING PURPOSES AND ONLY AS APPROVED BY THE DESIGNER.
2. IT IS THE OWNER'S INTENT TO PRESERVE ALL OF THE EXISTING SITE VEGETATION OUTSIDE THE LIMITS OF GRADING.
3. TOPSOIL SHALL BE STRIPPED FROM ALL CUT AND FILL AREAS, STOCKPILED AND REDISTRIBUTED OVER GRADED AREAS TO A MINIMUM DEPTH OF 6 INCHES. MAKE STOCKPILES FREE-DRAINING AND PROVIDE EROSION AND SEDIMENTATION CONTROLS AROUND STOCKPILES.
4. ALL GRADED AREAS SHALL BE SEEDED AND MULCHED WITHIN 15 DAYS AFTER GRADING IS COMPLETED.
5. CONSTRUCT TEMPORARY EROSION CONTROL AS SHOWN ON THE DRAWINGS PRIOR TO BEGINNING GRADING OPERATIONS.
6. ALL DRAINAGE STRUCTURES, PIPES WITHIN THE LIMITS OF CONSTRUCTION, AND DETENTION PONDS SHALL HAVE SEDIMENT REMOVED PRIOR TO FINAL ACCEPTANCE.
7. SILT BARRIERS SHALL BE CLEANED OF ACCUMULATED SEDIMENT WHEN APPROXIMATELY 50% FILLED.
8. ALL LOCATIONS OF TEMPORARY EROSION CONTROL DEVICES SHALL BE SUBJECT TO ADJUSTMENT AS DIRECTED BY THE DESIGNER.
9. WHEN THE TEMPORARY EROSION CONTROL DEVICES ARE NO LONGER REQUIRED FOR THE INTENDED PURPOSE (IN THE DESIGNER'S OPINION), THEY SHALL BE REMOVED.
10. REPLACE DAMAGED AND WORN OUT SILT BARRIERS AS DIRECTED BY THE DESIGNER.
11. THE CONTRACTOR SHALL PROTECT ALL TREES DESIGNATED TO REMAIN. DO NOT OPERATE OR STORE HEAVY EQUIPMENT, NOR HANDLE/STORE MATERIALS, WITHIN THE DRIPLINES OF TREES.
12. TOP OF GRATE ELEVATIONS FOR CURB INLETS ARE GIVEN TO THE CENTER OF THE INLETS AT THE FACE OF CURB. THE GRATES SHALL SLOPE LONGITUDINALLY WITH THE PAVEMENT GRADE. ADJUST THE CASTING TO FALL ALONG THE CURB LINE.
13. THE CONTRACTOR SHALL VERIFY THE EXACT LOCATION OF ALL EXISTING UTILITIES, PROTECT UTILITIES TO REMAIN, AND REPAIR CONTRACTOR-CAUSED DAMAGE ACCORDING TO LOCAL STANDARDS AT CONTRACTOR'S EXPENSE.
14. NOTIFY LOCAL UTILITY LOCATOR SERVICE BEFORE INTENDED EXCAVATION/UTILITY TRENCHING OPERATIONS. SEE GENERAL UTILITY NOTE #4 ON THIS SHEET FOR PHONE NUMBER.
15. IN THE EVENT OF ANY DISCREPANCIES FOUND IN THE DRAWINGS OR IF PROBLEMS ARE ENCOUNTERED DURING CONSTRUCTION, THE CONTRACTOR SHALL NOTIFY THE DESIGNER BEFORE PROCEEDING WITH THE WORK.
16. THE CONTRACTOR SHALL GIVE ALL NECESSARY NOTICE AND OBTAIN ALL PERMITS.
17. SPOT ELEVATIONS AND CONTOURS REPRESENT PROPOSED FINISHED GRADE AND TOP OF FINISHED PAVEMENT.
18. CONTRACTOR SHALL VERIFY EXISTING ELEVATIONS AND INVERTS PRIOR TO BEGINNING WORK.
19. EXCESS MATERIAL SHALL BE DISPOSED OF BY THE CONTRACTOR OFF THE OWNER'S PROPERTY AT NO ADDITIONAL COST IN A LEGAL MANNER.
20. CONTOUR LINES AND SPOT ELEVATIONS ARE THE RESULT OF A DETAILED ENGINEERING GRADING DESIGN AND REFLECT A PLANNED INTENT WITH REGARD TO DRAINAGE. SHOULD THE CONTRACTOR HAVE ANY QUESTIONS OF THIS INTENT OR ANY PROBLEMS WITH CONTINUITY OF GRADES, THE DESIGNER SHALL BE CONTACTED PRIOR TO BEGINNING WORK.
21. EXISTING MANHOLE CASTINGS TO REMAIN SHALL BE RESET TO MATCH NEW GRADE.
22. ALL CURBS AND SIDEWALKS SHALL BE BACKFILLED WITH TOPSOIL, SEEDED AND MULCHED, UNLESS OTHERWISE NOTED.
23. ALL PIPES UNDER PAVED AREAS SHALL BE BACK FILLED WITH CRUSHED STONE UNLESS NOTED OTHERWISE. ALL PIPES UNDER LAWN AREAS SHALL BE BACK FILLED WITH SATISFACTORY MATERIAL AND COMPACTED TO 98% OF MAXIMUM PER ASTM D698 UNLESS NOTED OTHERWISE.
24. ALL STORM DRAINAGE PIPE SHALL BE HDPE UNLESS OTHERWISE NOTED. PIPE LENGTHS SHOWN ARE APPROXIMATE.
25. ALL CUT AND FILL SLOPES TO BE 3:1 MAXIMUM UNLESS SPECIFICALLY STATED OTHERWISE.
26. SATISFACTORY TOPSOIL IS DEFINED AS SOIL BEING FREE OF CONTAMINANTS, SUBSOIL, CLAY CLUMP, STONES OR OTHER OBJECTS OVER 1 INCH IN DIAMETER.
27. AFTER STRIPPING TOPSOIL, PROOFROLL SUBGRADE WITH A LOADED DUMP TRUCK WITH A MINIMUM WEIGHT OF 20 TONS.
28. FINISH GRADE TOLERANCES ARE 0.10 FOOT ABOVE OR BELOW DESIGN ELEVATIONS.
29. PROVIDE TEMPORARY SEEDING ON STOCKPILES AND ALL OTHER AREAS OF THE SITE THAT WILL REMAIN UNDISTURBED FOR 30 DAYS OR MORE.
30. MAXIMUM SLOPES IN ALL DIRECTIONS OF HANDICAP PARKING SPACES/AISLES SHALL BE 2%.
31. EARTHWORK FILL SHALL INCLUDE STRIPPING TOPSOIL AND PLACING ENGINEERED FILL IN MAXIMUM 8" COMPACTED LIFTS WITH DENSITY OF 98% OF MAXIMUM PER ASTM D698.
32. I CERTIFY THAT THESE PLANS HAVE BEEN PREPARED BY ME AND/OR UNDER MY DIRECT SUPERVISION. THIS PROJECT IS PLANNED TO DISTURB MORE THAN ONE ACRE. IT THEREFORE FALLS UNDER THE TENNESSEE DIVISION OF WATER POLLUTION CONTROL'S GENERAL NPDES PERMIT TO DISCHARGE STORM WATER ASSOCIATED WITH CONSTRUCTION ACTIVITY. HART FREELAND ROBERTS WILL ASSIST THE CONTRACTOR IN SUBMITTING THE NOTICE OF INTENT (NOI) TO CONSTRUCT TO THE STATE AT LEAST 30 DAYS PRIOR TO BEGINNING LAND DISTURBANCE.




ARCHITECTURE
ENGINEERING
PLANNING
INTERIORS

C HART FREELAND ROBERTS, INC.
7101 Executive Center Drive
Suite 300
Brentwood, TN 37024

615.370.8500 phone
615.370.8530 fax
www.hfrdesign.com web

Nashville, Tennessee
Jackson, Tennessee
Kansas City, Missouri
Louisville, Kentucky

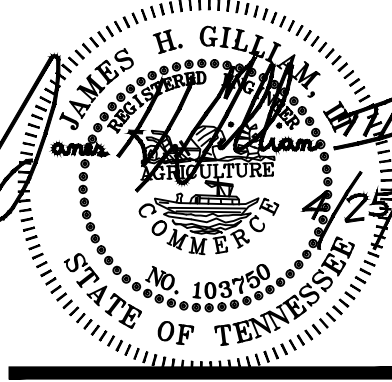

HALE STADIUM RENOVATIONS
NORTH AND SOUTH ENTRIES
TENNESSEE STATE UNIVERSITY

JOHN A MERRITT BLVD
NASHVILLE, TN
SBC# 166/001-02-2011

PROJ. NO.: 2011171

DATE: 25 APRIL 2012

GENERAL
NOTES

C0.02




PLOT DATE: 5/18/2012 2:50:11 PM (GOODSON)
©COPYRIGHT 2012 - ALL RIGHTS RESERVED. NO PORTIONS OF THIS DOCUMENT MAY BE REPRODUCED WITHOUT THE EXPRESSED WRITTEN CONSENT OF HART FREELAND ROBERTS, INC.
C:\301171\VC-Shts-2011171.dwg, 0004, 5/18/2012 2:50:08 PM, GDR:skm



ARCHITECTURE
ENGINEERING
PLANNING
INTERIORS

C HART FREELAND ROBERTS, INC.
7101 Executive Center Drive
Suite 300
Brentwood, TN 37024
615.370.8500 phone
615.370.8530 fax
www.hfrdesign.com web
Nashville, Tennessee
Jackson, Tennessee
Kansas City, Missouri
Louisville, Kentucky

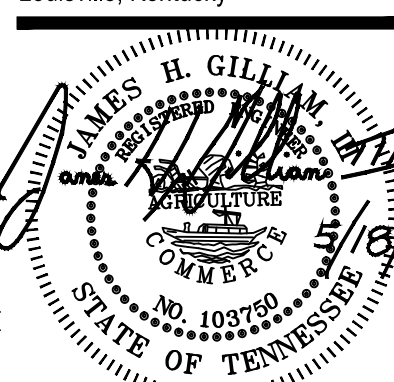

NO.	DATE	REVISION	ADDENDUM #2
1	5/18/12		
2			
3			

HALE STADIUM RENOVATIONS
NORTH AND SOUTH ENTRIES
TENNESSEE STATE UNIVERSITY
JOHN A MERRITT BLVD
NASHVILLE, TN
SBC# 166/001-02-2011

PROJ. NO.: 2011171
DATE: 25 APRIL 2012

SITE
DEMOLITION
PLAN
NORTH
ENTRY

C0.04

PLOT DATE: 5/10/2012 2:50:16 PM (GOODSON)
© COPYRIGHT 2012 - ALL RIGHTS RESERVED. NO PORTIONS OF THIS DOCUMENT MAY BE REPRODUCED WITHOUT THE EXPRESSED WRITTEN CONSENT OF HART FREELAND ROBERTS, INC.

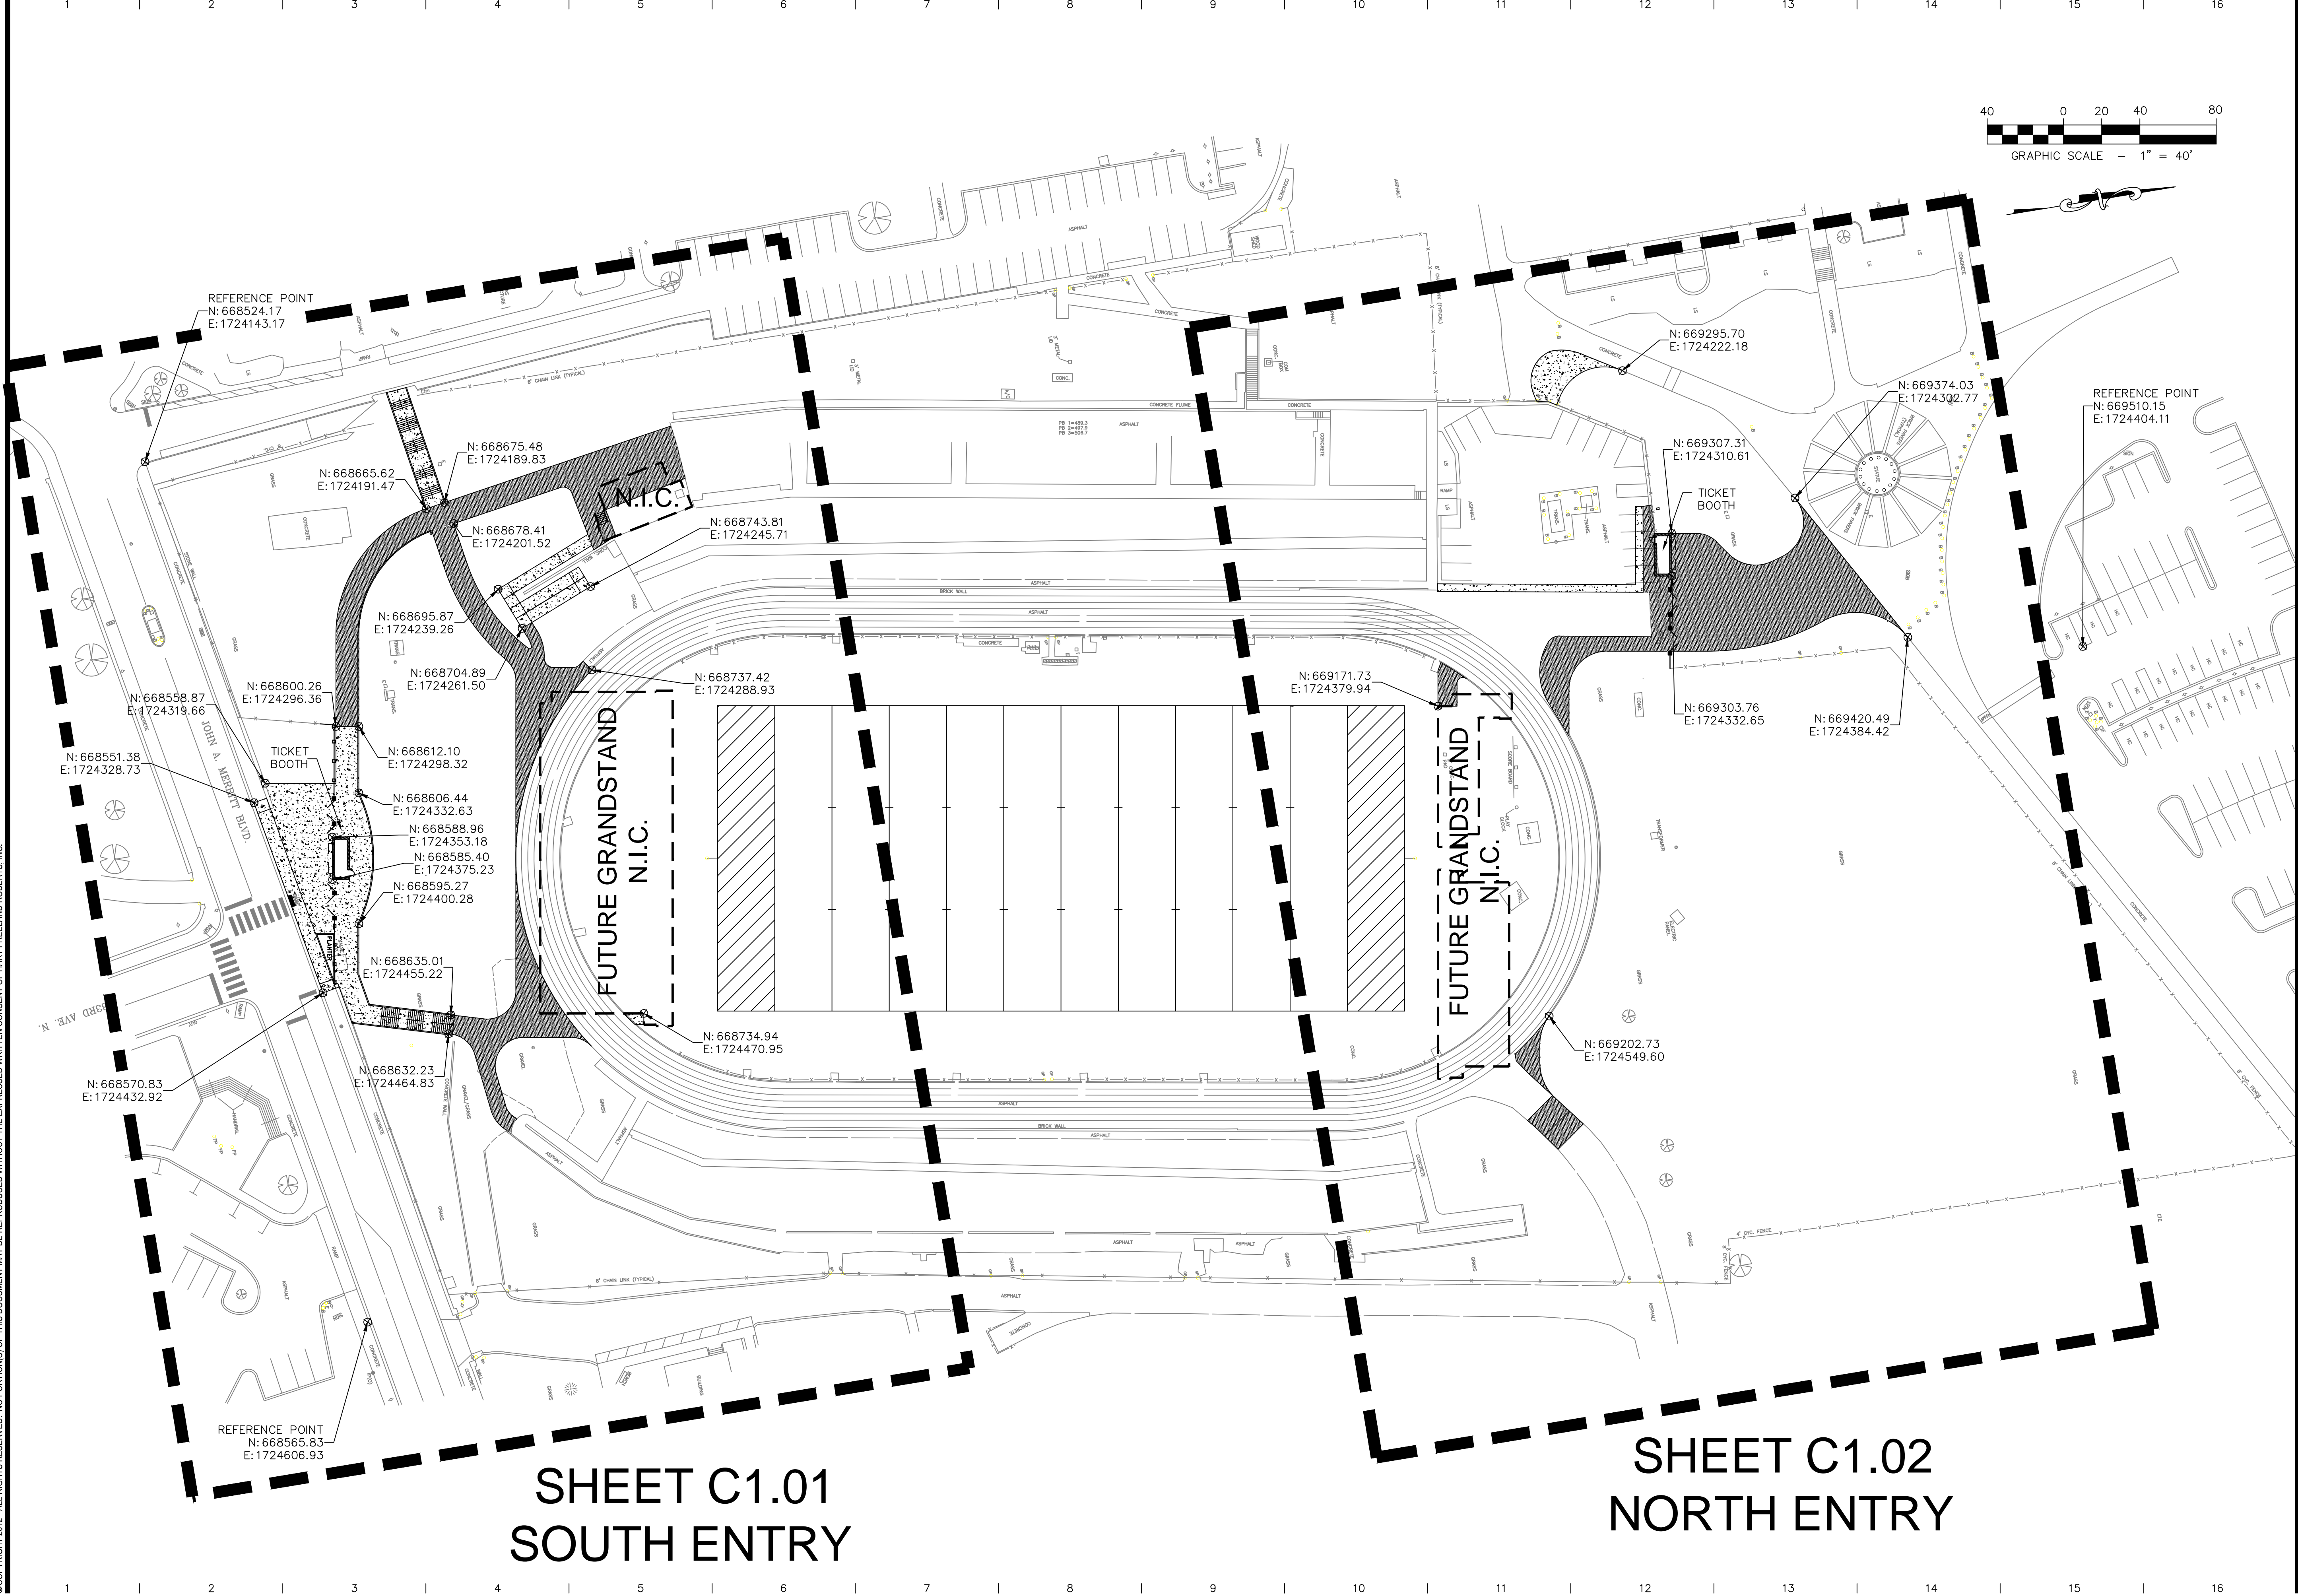

SHEET C1.01
SOUTH ENTRY

SHEET C1.02
NORTH ENTRY




ARCHITECTURE
ENGINEERING
PLANNING
INTERIORS

HART FREELAND ROBERTS, INC.
7101 Executive Center Drive
Suite 300
Brentwood, TN 37024

615.370.8500 phone
615.370.8530 fax
www.hfrdesign.com web

Nashville, Tennessee
Jackson, Tennessee
Kansas City, Missouri
Louisville, Kentucky

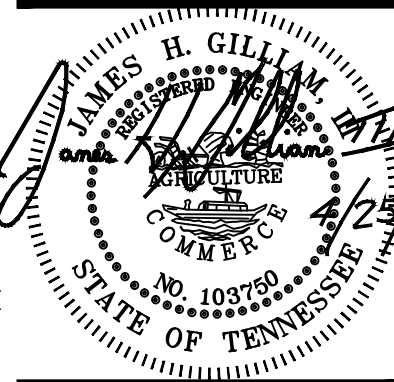



HALE STADIUM RENOVATIONS
NORTH AND SOUTH ENTRIES
TENNESSEE STATE UNIVERSITY

JOHN A MERRITT BLVD
NASHVILLE, TN
SBC# 166/001-02-2011

PROJ. NO.: 2011171
DATE: 25 APRIL 2012

OVERALL
SITE PLAN

C1.00

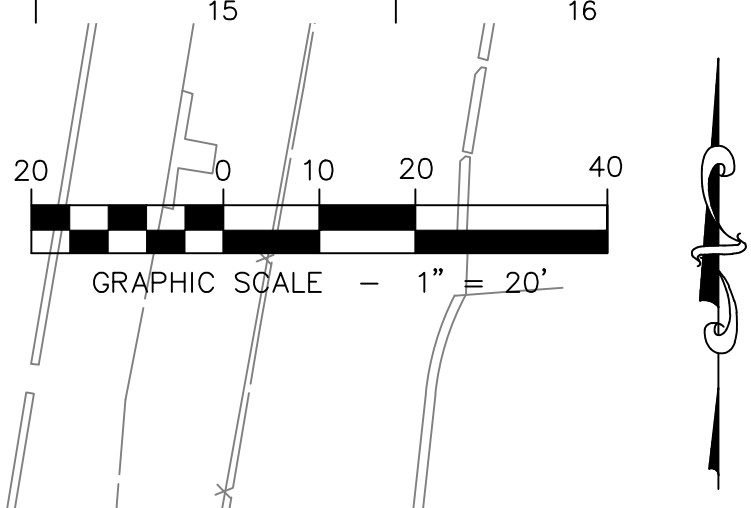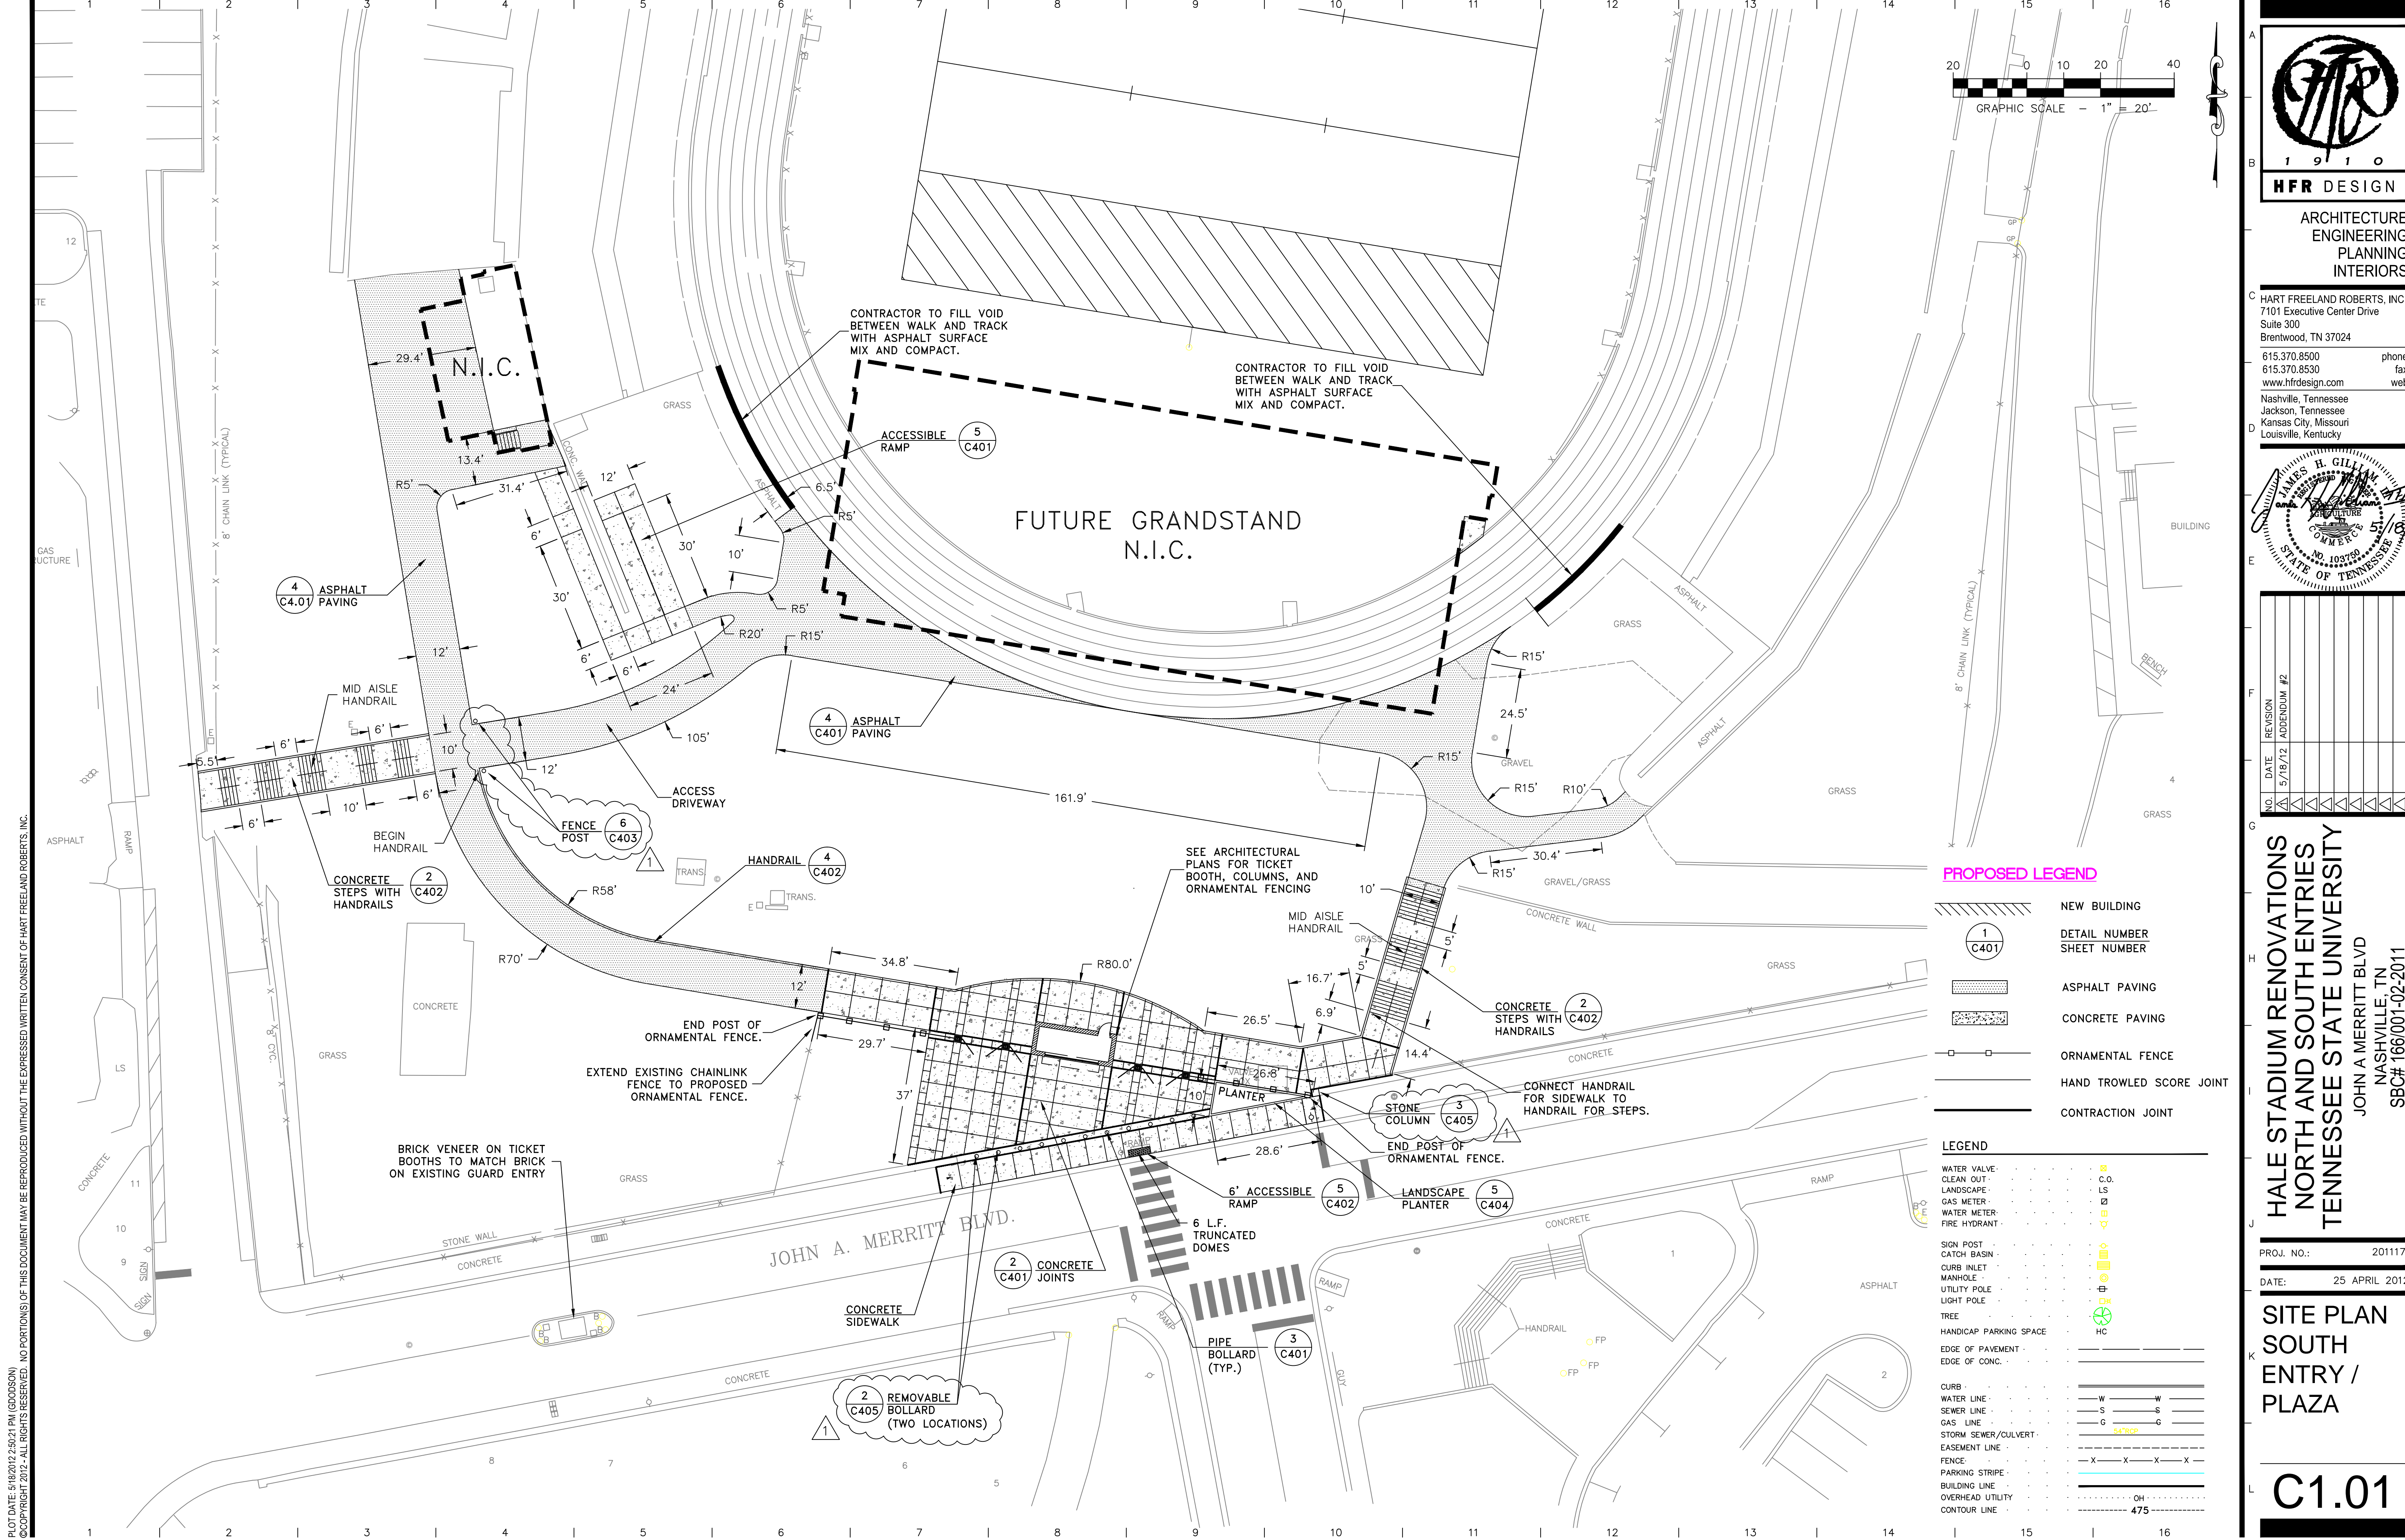


ARCHITECTURE
ENGINEERING
PLANNING
INTERIORS

HART FREELAND ROBERTS, INC.
7101 Executive Center Drive
Suite 300
Brentwood, TN 37024

615.370.8500 phone
615.370.8530 fax
www.hfrdesign.com web

Nashville, Tennessee
Jackson, Tennessee
Kansas City, Missouri
Louisville, Kentucky

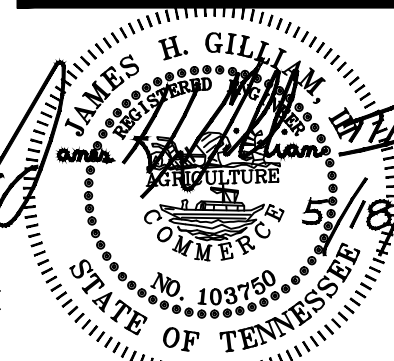

NO.	DATE	REVISION	ADDENDUM #2
1	5/18/12		
2			
3			
HALE STADIUM RENOVATIONS
NORTH AND SOUTH ENTRIES
TENNESSEE STATE UNIVERSITY

JOHN A. MERRITT BLVD
NASHVILLE, TN
SBC# 166/001-02-2011

PROJ. NO.: 2011171
DATE: 25 APRIL 2012



SITE PLAN
SOUTH
ENTRY /
PLAZA

C1.01

- PROPOSED LEGEND**
- NEW BUILDING
 - DETAIL NUMBER
 - SHEET NUMBER
 - ASPHALT PAVING
 - CONCRETE PAVING
 - ORNAMENTAL FENCE
 - HAND TROWLED SCORE JOINT
 - CONTRACTION JOINT
- LEGEND**
- WATER VALVE
 - CLEAN OUT
 - LANDSCAPE
 - GAS METER
 - WATER METER
 - FIRE HYDRANT
 - SIGN POST
 - CATCH BASIN
 - CURB INLET
 - MANHOLE
 - UTILITY POLE
 - LIGHT POLE
 - TREE
 - HANDICAP PARKING SPACE
 - EDGE OF PAVEMENT
 - EDGE OF CONC.
 - CURB
 - WATER LINE
 - SEWER LINE
 - GAS LINE
 - STORM SEWER/CULVERT
 - EASEMENT LINE
 - FENCE
 - PARKING STRIPE
 - BUILDING LINE
 - OVERHEAD UTILITY
 - CONTOUR LINE
- 475

PLOT DATE: 5/18/2012 2:50:21 PM (GOODSON)
©COPYRIGHT 2012 - ALL RIGHTS RESERVED. NO PORTIONS OF THIS DOCUMENT MAY BE REPRODUCED WITHOUT THE EXPRESSED WRITTEN CONSENT OF HART FREELAND ROBERTS, INC.

PLOT DATE: 5/18/2012 2:50:31 PM (GOODSON)
© COPYRIGHT 2012 - ALL RIGHTS RESERVED. NO PORTIONS OF THIS DOCUMENT MAY BE REPRODUCED WITHOUT THE EXPRESSED WRITTEN CONSENT OF HART FREELAND ROBERTS, INC.

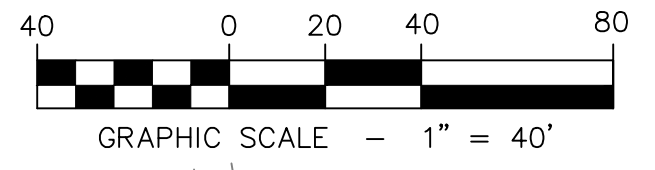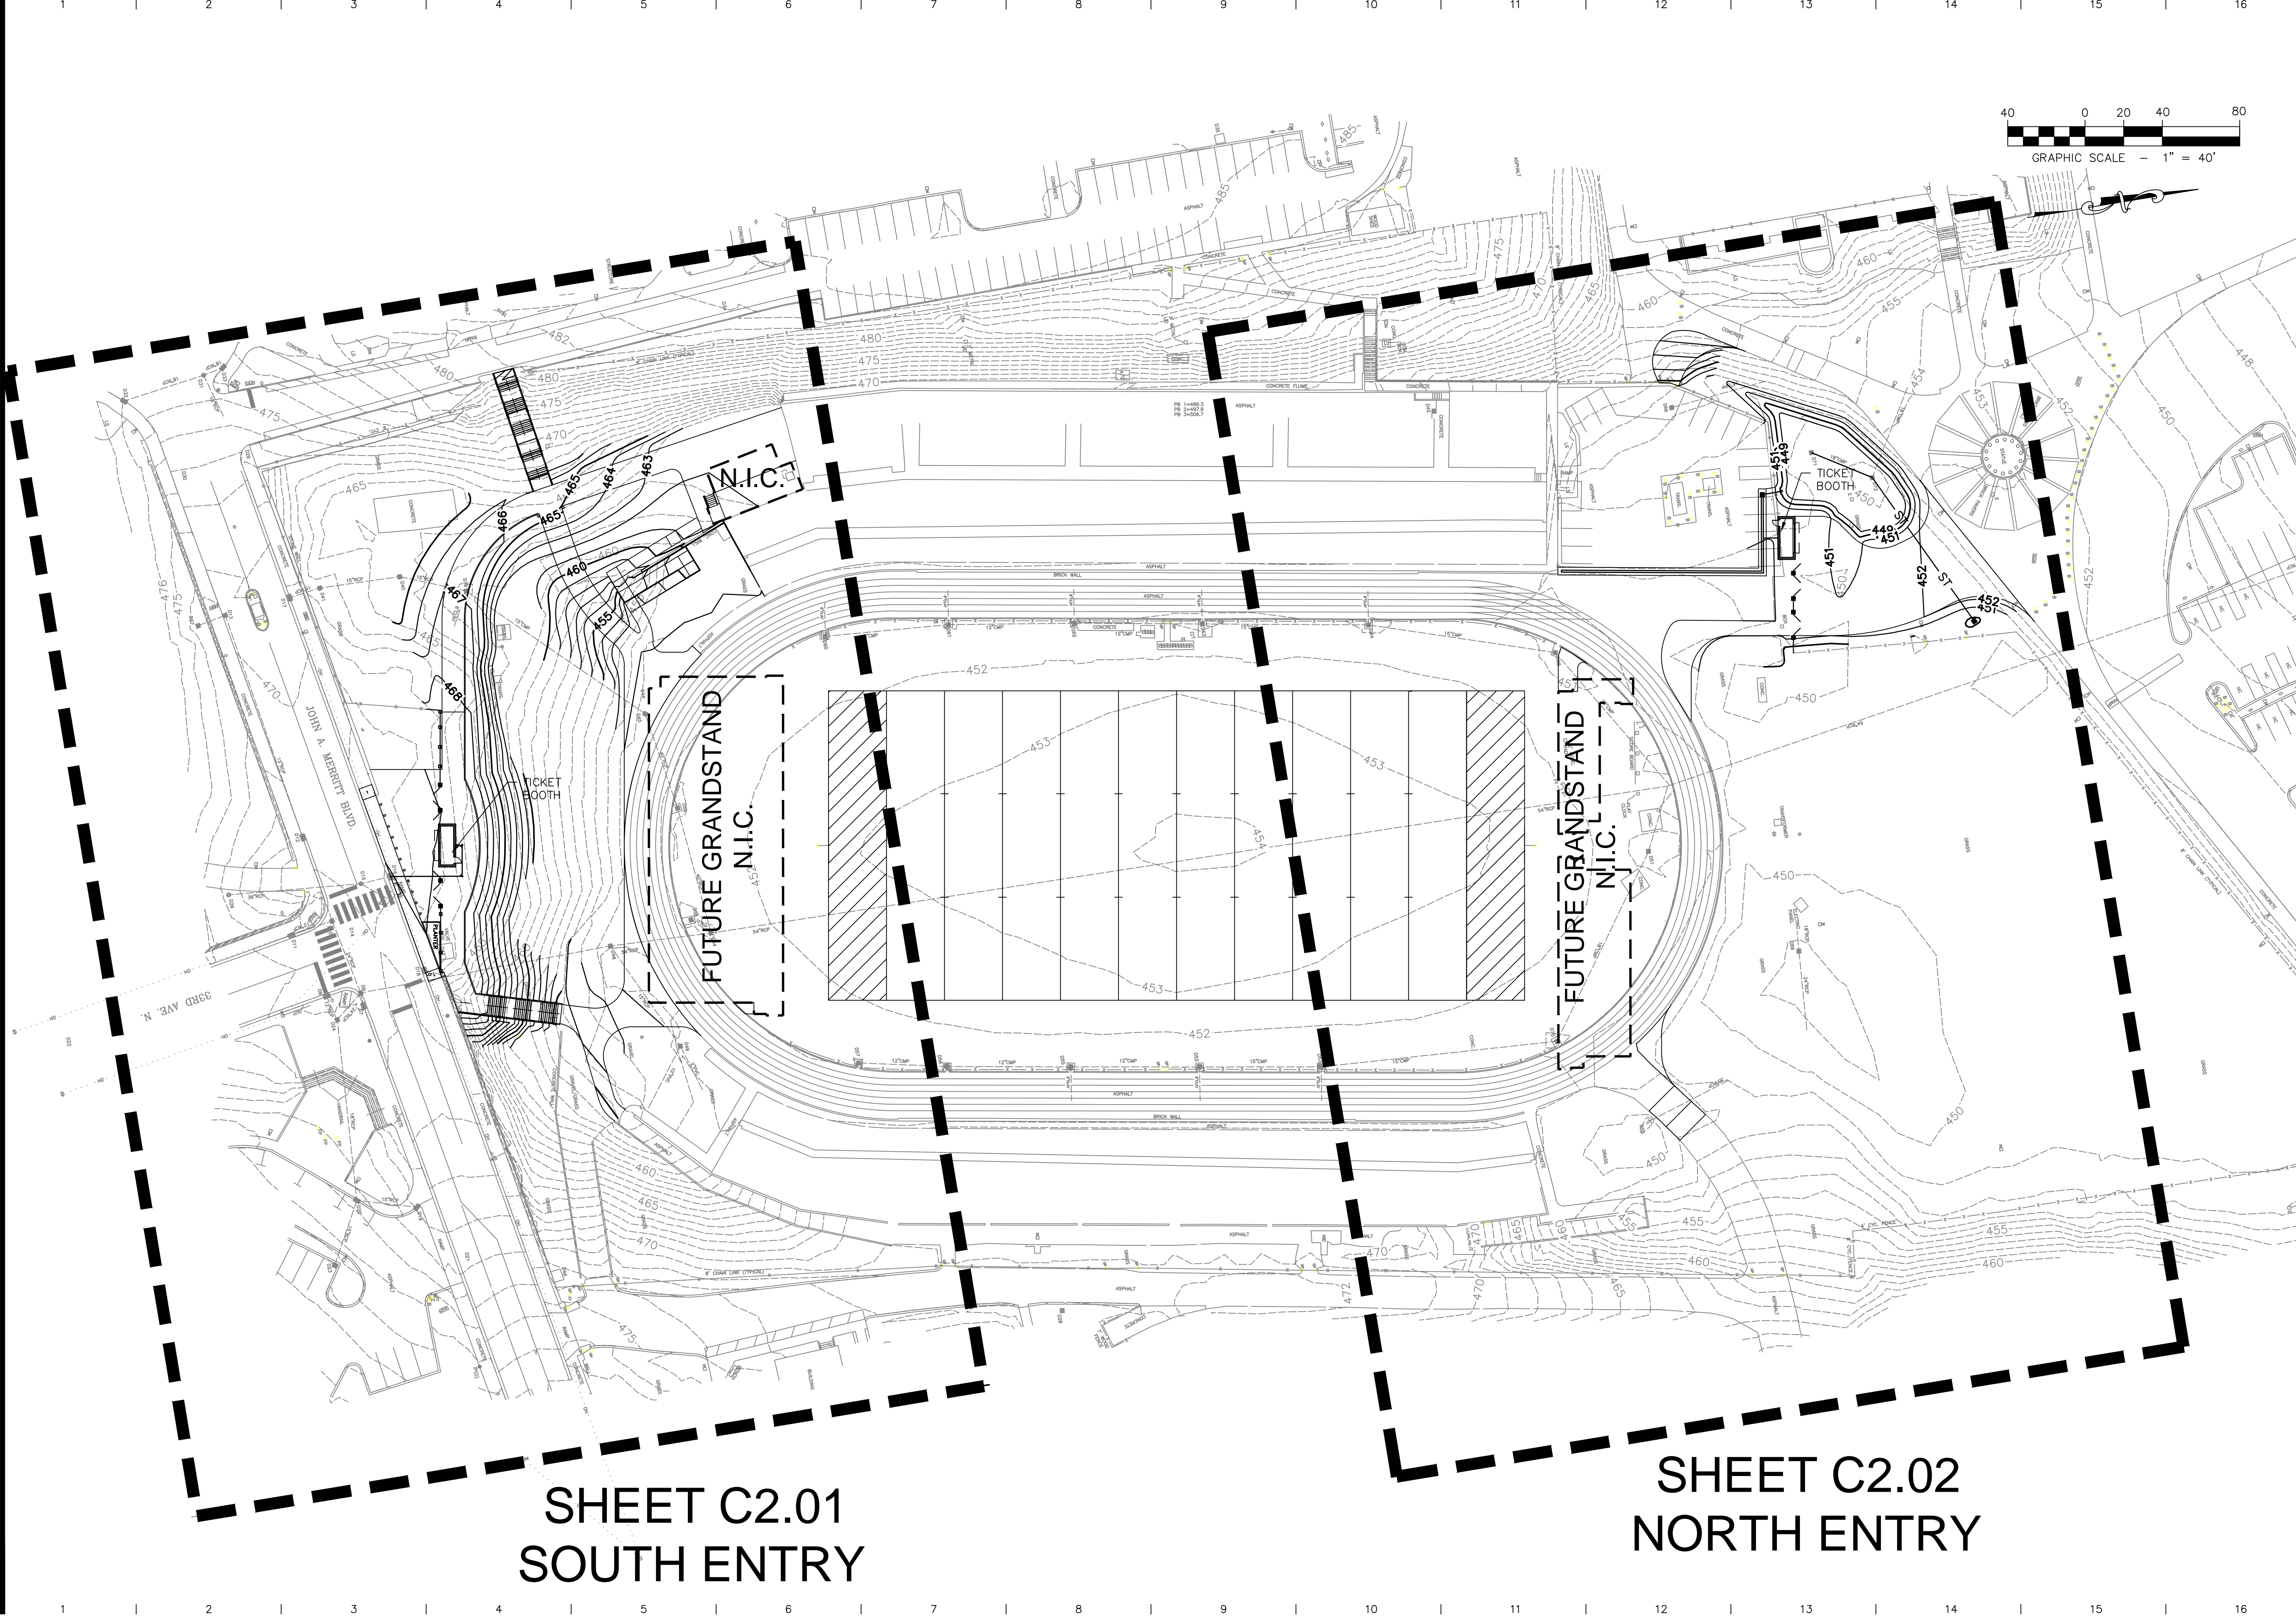


ARCHITECTURE
ENGINEERING
PLANNING
INTERIORS

HART FREELAND ROBERTS, INC.
7101 Executive Center Drive
Suite 300
Brentwood, TN 37024

615.370.8500 phone
615.370.8530 fax
www.hfrdesign.com web

Nashville, Tennessee
Jackson, Tennessee
Kansas City, Missouri
Louisville, Kentucky

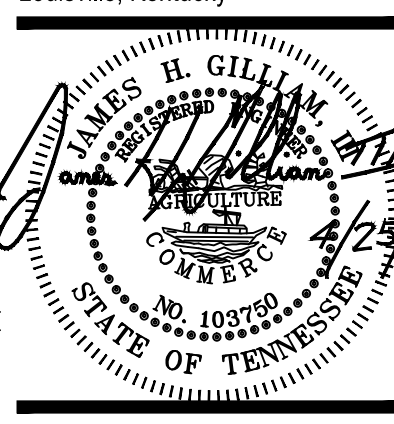

HALE STADIUM RENOVATIONS
NORTH AND SOUTH ENTRIES
TENNESSEE STATE UNIVERSITY
JOHN A MERRITT BLVD
NASHVILLE, TN
SBC# 166/001-02-2011

PROJ. NO.: 2011171


DATE: 25 APRIL 2012

OVERALL
GRADING
AND
DRAINAGE
PLAN

C2.00




PLOT DATE: 5/18/2012 2:50:36 PM (GDODSON)
©COPYRIGHT 2012 - ALL RIGHTS RESERVED.

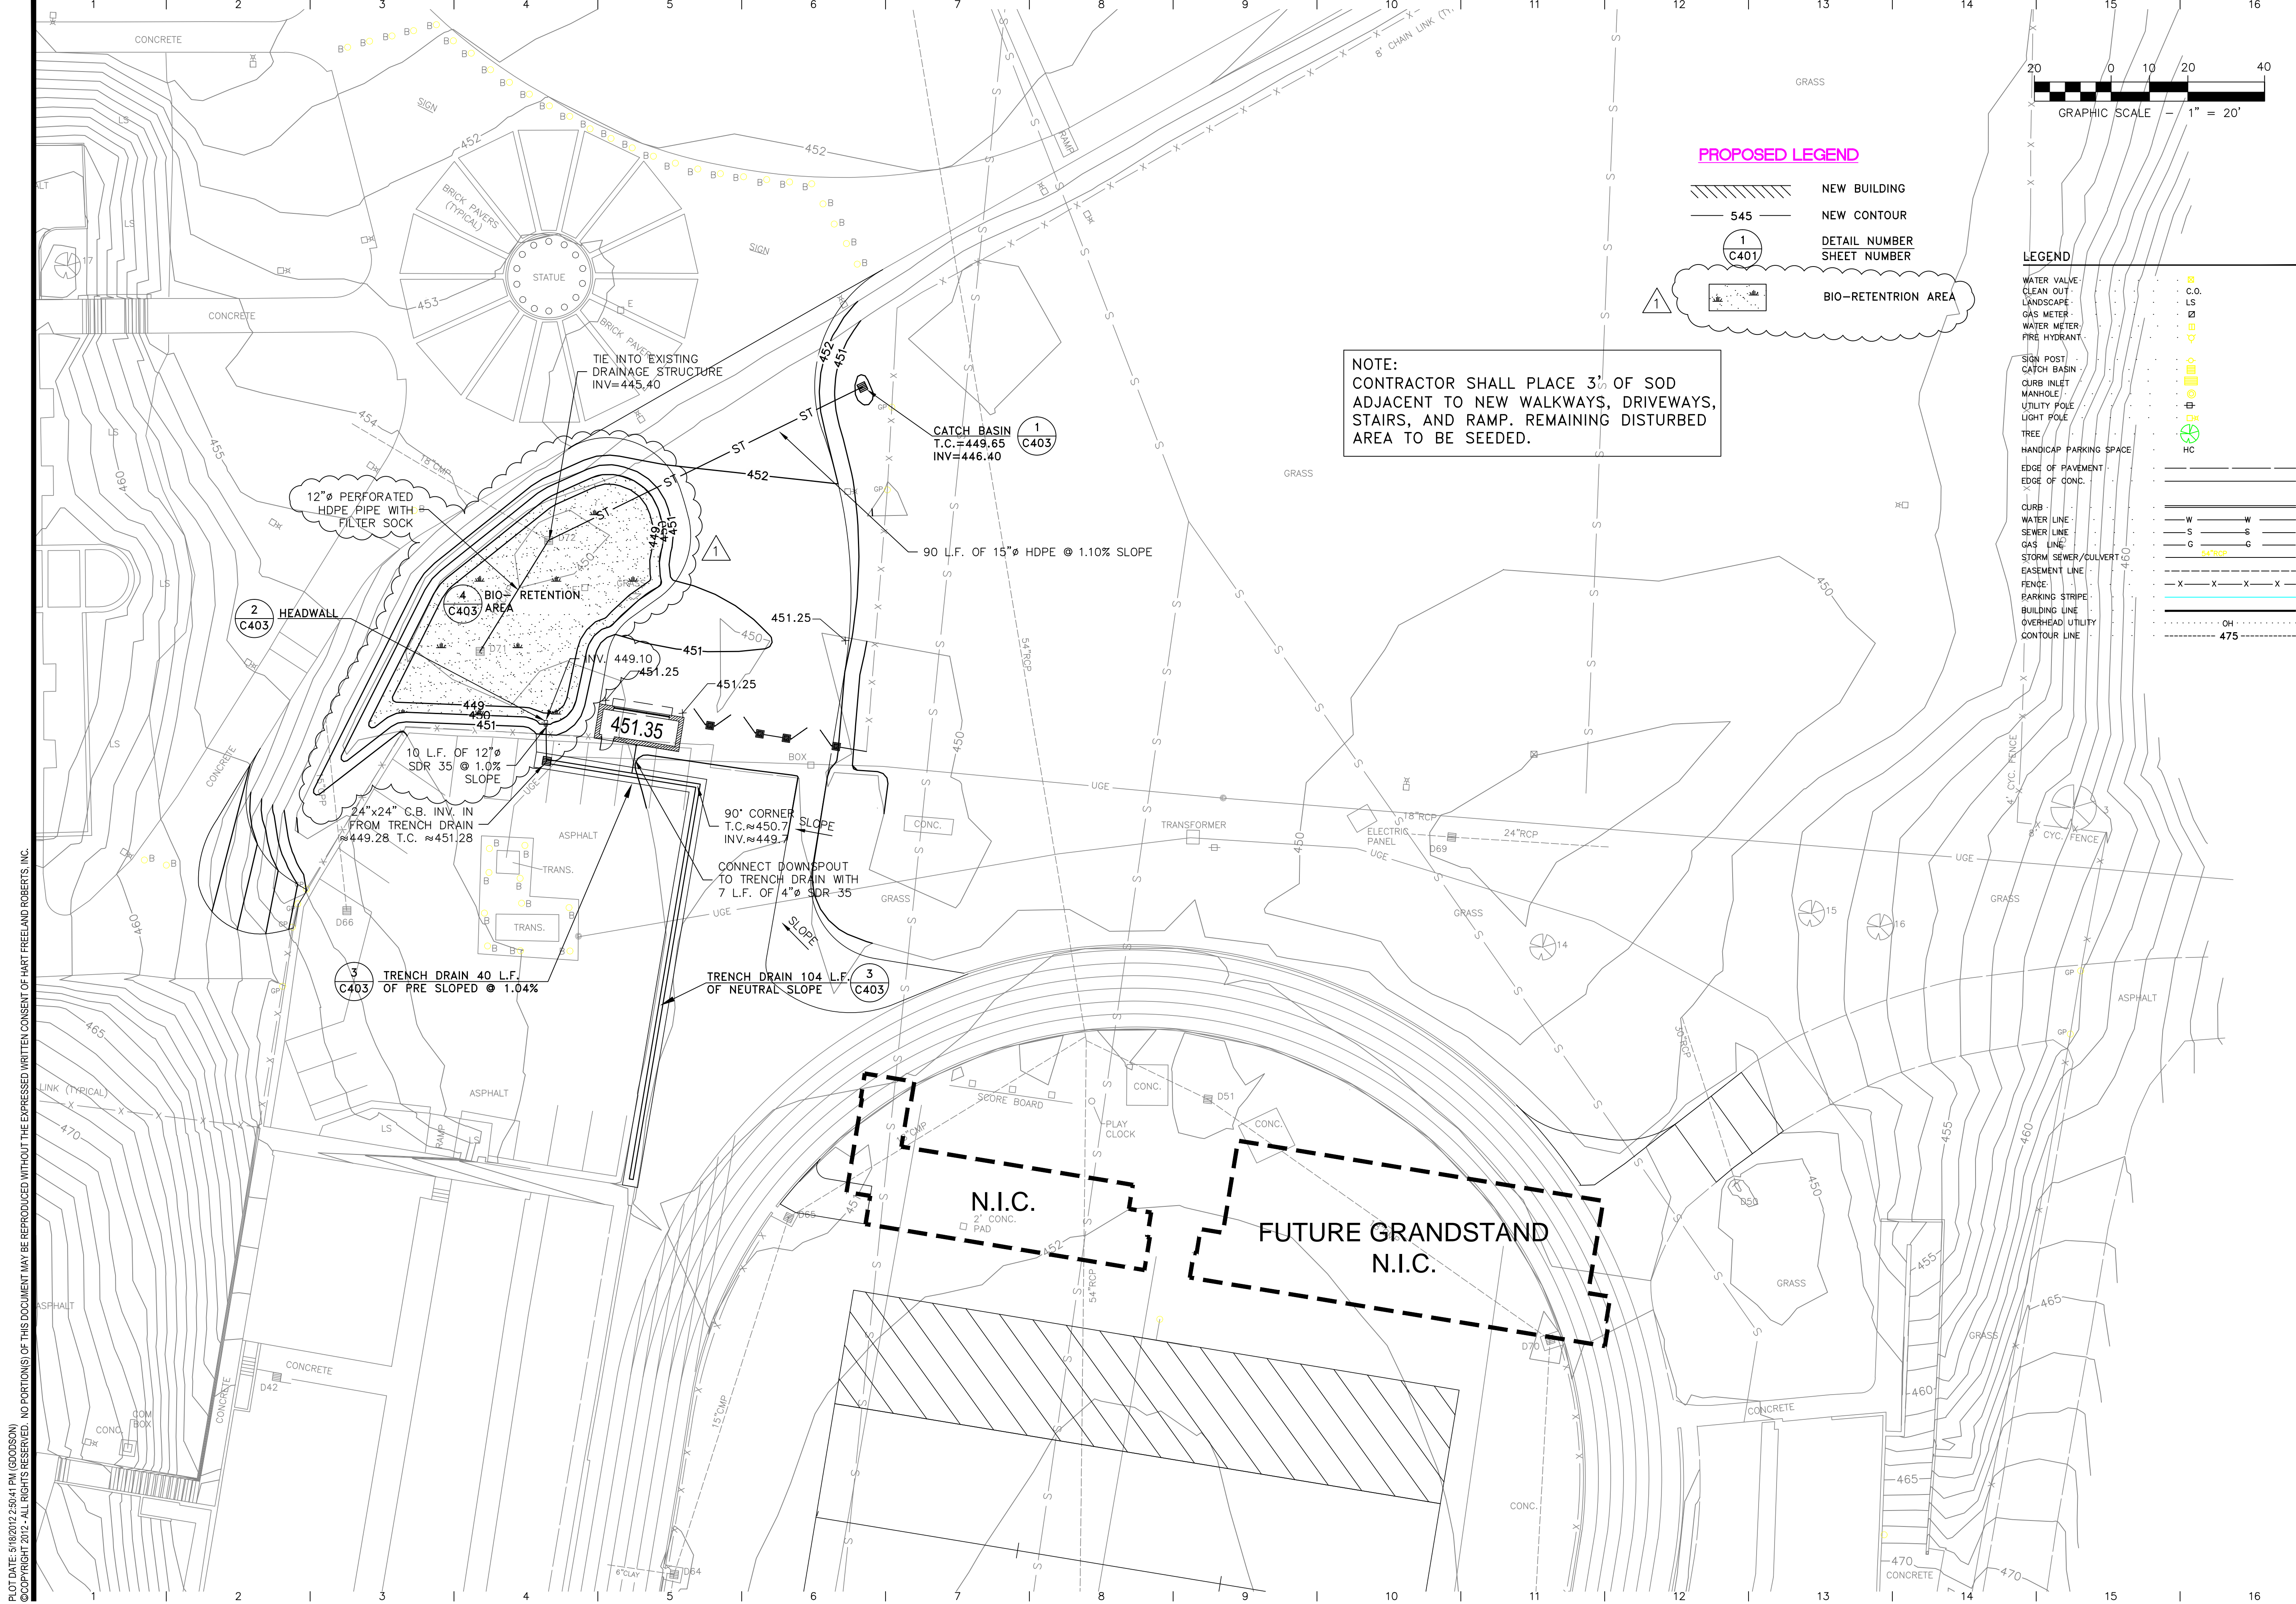

PROPOSED LEGEND

- NEW BUILDING
- NEW CONTOUR
- DETAIL NUMBER
- SHEET NUMBER
- BIO-RETENTION AREA

NOTE:
CONTRACTOR SHALL PLACE 3% OF SOD
ADJACENT TO NEW WALKWAYS, DRIVEWAYS,
STAIRS, AND RAMP. REMAINING DISTURBED
AREA TO BE SEEDED.

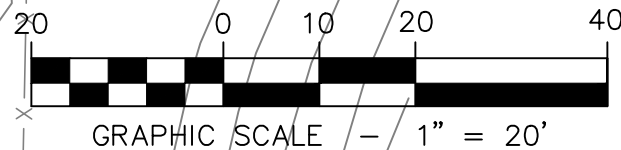


LEGEND

- WATER VALVE
- CLEAN OUT
- LANDSCAPE
- GAS METER
- WATER METER
- FIRE HYDRANT
- SIGN POST
- CATCH BASIN
- CURB INLET
- MANHOLE
- UTILITY POLE
- LIGHT POLE
- TREE
- HANDICAP PARKING SPACE
- EDGE OF PAVEMENT
- EDGE OF CONC.
- CURB
- WATER LINE
- SEWER LINE
- GAS LINE
- STORM SEWER/CULVERT
- EASEMENT LINE
- FENCE
- PARKING STRIPE
- BUILDING LINE
- OVERHEAD UTILITY
- CONTOUR LINE

PLOT DATE: 5/18/2012 2:50:41 PM (GOODSON)
© COPYRIGHT 2012 - ALL RIGHTS RESERVED. NO PORTIONS OF THIS DOCUMENT MAY BE REPRODUCED WITHOUT THE EXPRESSED WRITTEN CONSENT OF HART FREELAND ROBERTS, INC.
C:\2011\171\1\171\171.dwg C202 5/18/2012 2:50:38 PM GJadison



ARCHITECTURE
ENGINEERING
PLANNING
INTERIORS
HART FREELAND ROBERTS, INC.
7101 Executive Center Drive
Suite 300
Brentwood, TN 37024
615.370.8500 phone
615.370.8530 fax
www.hfrdesign.com web
Nashville, Tennessee
Jackson, Tennessee
Kansas City, Missouri
Louisville, Kentucky

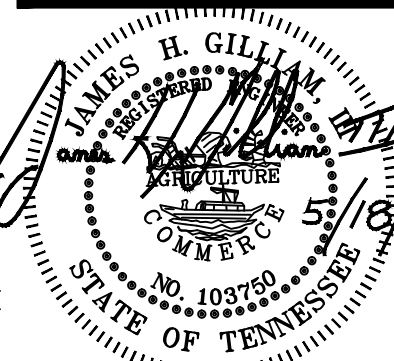

NO.	DATE	REVISION	ADDENDUM #2
1	5/18/12		
2			
3			


HALE STADIUM RENOVATIONS
NORTH AND SOUTH ENTRIES
TENNESSEE STATE UNIVERSITY
JOHN A MERRITT BLVD
NASHVILLE, TN
SBC# 166/001-02-2011

PROJ. NO.: 2011171
DATE: 25 APRIL 2012

GRADING &
DRAINAGE
PLAN NORTH
ENTRY

C2.02

PLOT DATE: 5/18/2012 2:50:46 PM (GOODSON)
©COPYRIGHT 2012 - ALL RIGHTS RESERVED. NO PORTIONS OF THIS DOCUMENT MAY BE REPRODUCED WITHOUT THE EXPRESSED WRITTEN CONSENT OF HART FREELAND ROBERTS, INC.

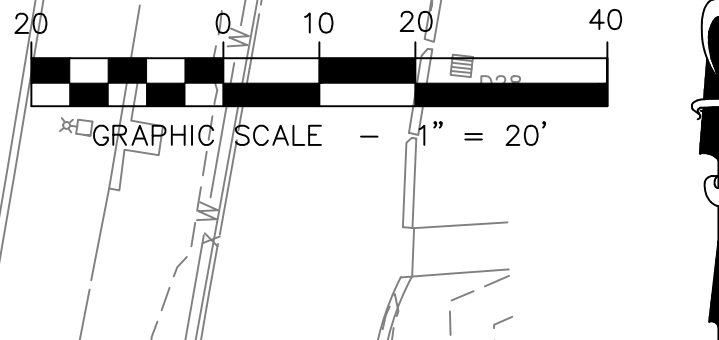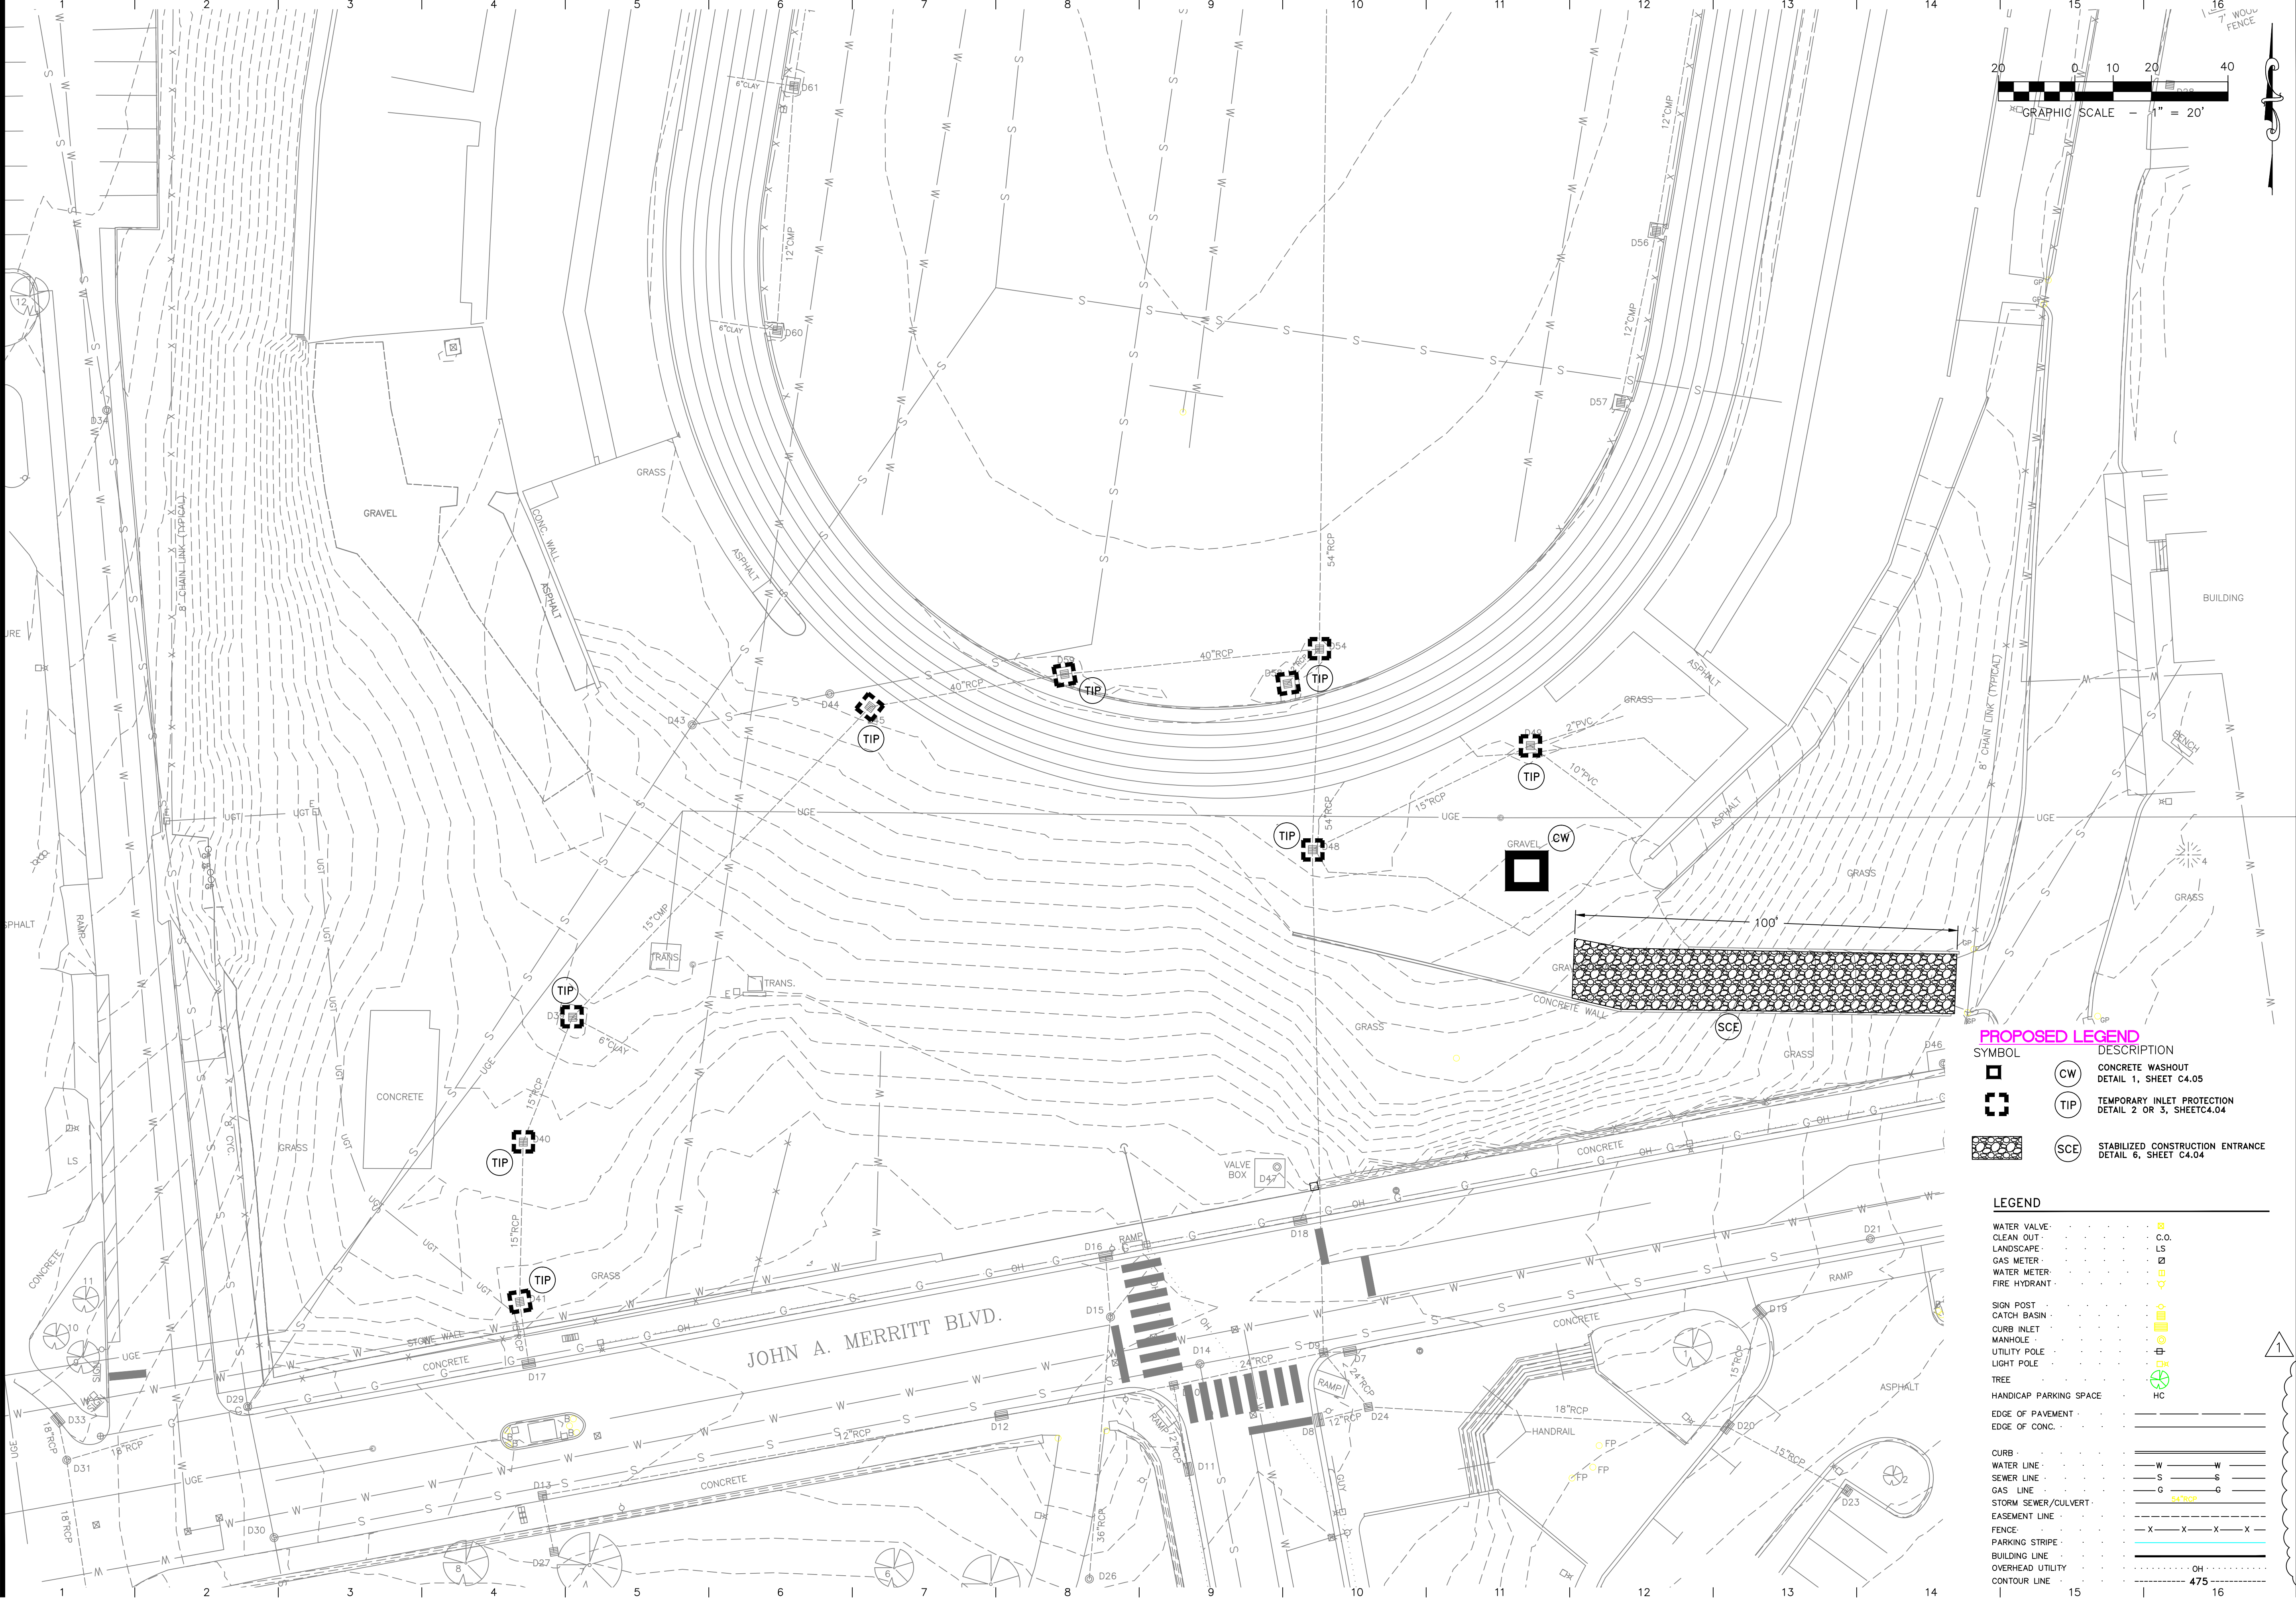




HFR DESIGN

ARCHITECTURE
ENGINEERING
PLANNING
INTERIORS

HART FREELAND ROBERTS, INC.
7101 Executive Center Drive
Suite 300
Brentwood, TN 37024
615.370.8500 phone
615.370.8530 fax
www.hfrdesign.com web
Nashville, Tennessee
Jackson, Tennessee
Kansas City, Missouri
Louisville, Kentucky

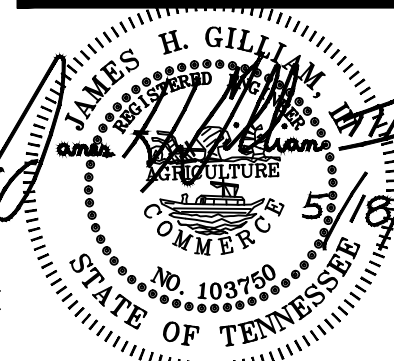

NO.	DATE	REVISION	ADDENDUM #2
1	5/18/12		
2			
3			
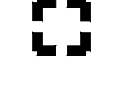
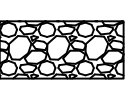
HALE STADIUM RENOVATIONS NORTH AND SOUTH ENTRIES TENNESSEE STATE UNIVERSITY


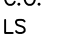


















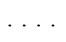
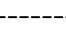



JOHN A MERRITT BLVD
NASHVILLE, TN
SBC# 166/001-02-2011



PROJ. NO.: 2011171
DATE: 25 APRIL 2012

INITIAL EROSION CONTROL PLAN SOUTH ENTRY PLAZA

C2.03

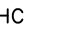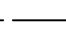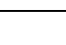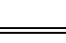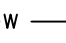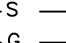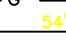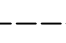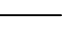PROPOSED LEGEND	
SYMBOL	DESCRIPTION
	CW CONCRETE WASHOUT DETAIL 1, SHEET C4.05
	TIP TEMPORARY INLET PROTECTION DETAIL 2 OR 3, SHEET C4.04
	SCE STABILIZED CONSTRUCTION ENTRANCE DETAIL 6, SHEET C4.04

LEGEND	
WATER VALVE	
CLEAN OUT	
LANDSCAPE	
GAS METER	
WATER METER	
FIRE HYDRANT	
SGN POST	
CATCH BASIN	
CURB INLET	
MANHOLE	
UTILITY POLE	
LIGHT POLE	
TREE	
HANDICAP PARKING SPACE	
EDGE OF PAVEMENT	
EDGE OF CONC.	
CURB	
WATER LINE	
SEWER LINE	
GAS LINE	
STORM SEWER/CULVERT	
EASEMENT LINE	
PARKING STRIPE	
BUILDING LINE	
OVERHEAD UTILITY	
CONTOUR LINE	

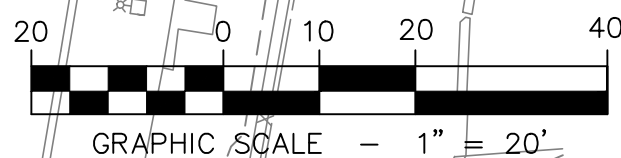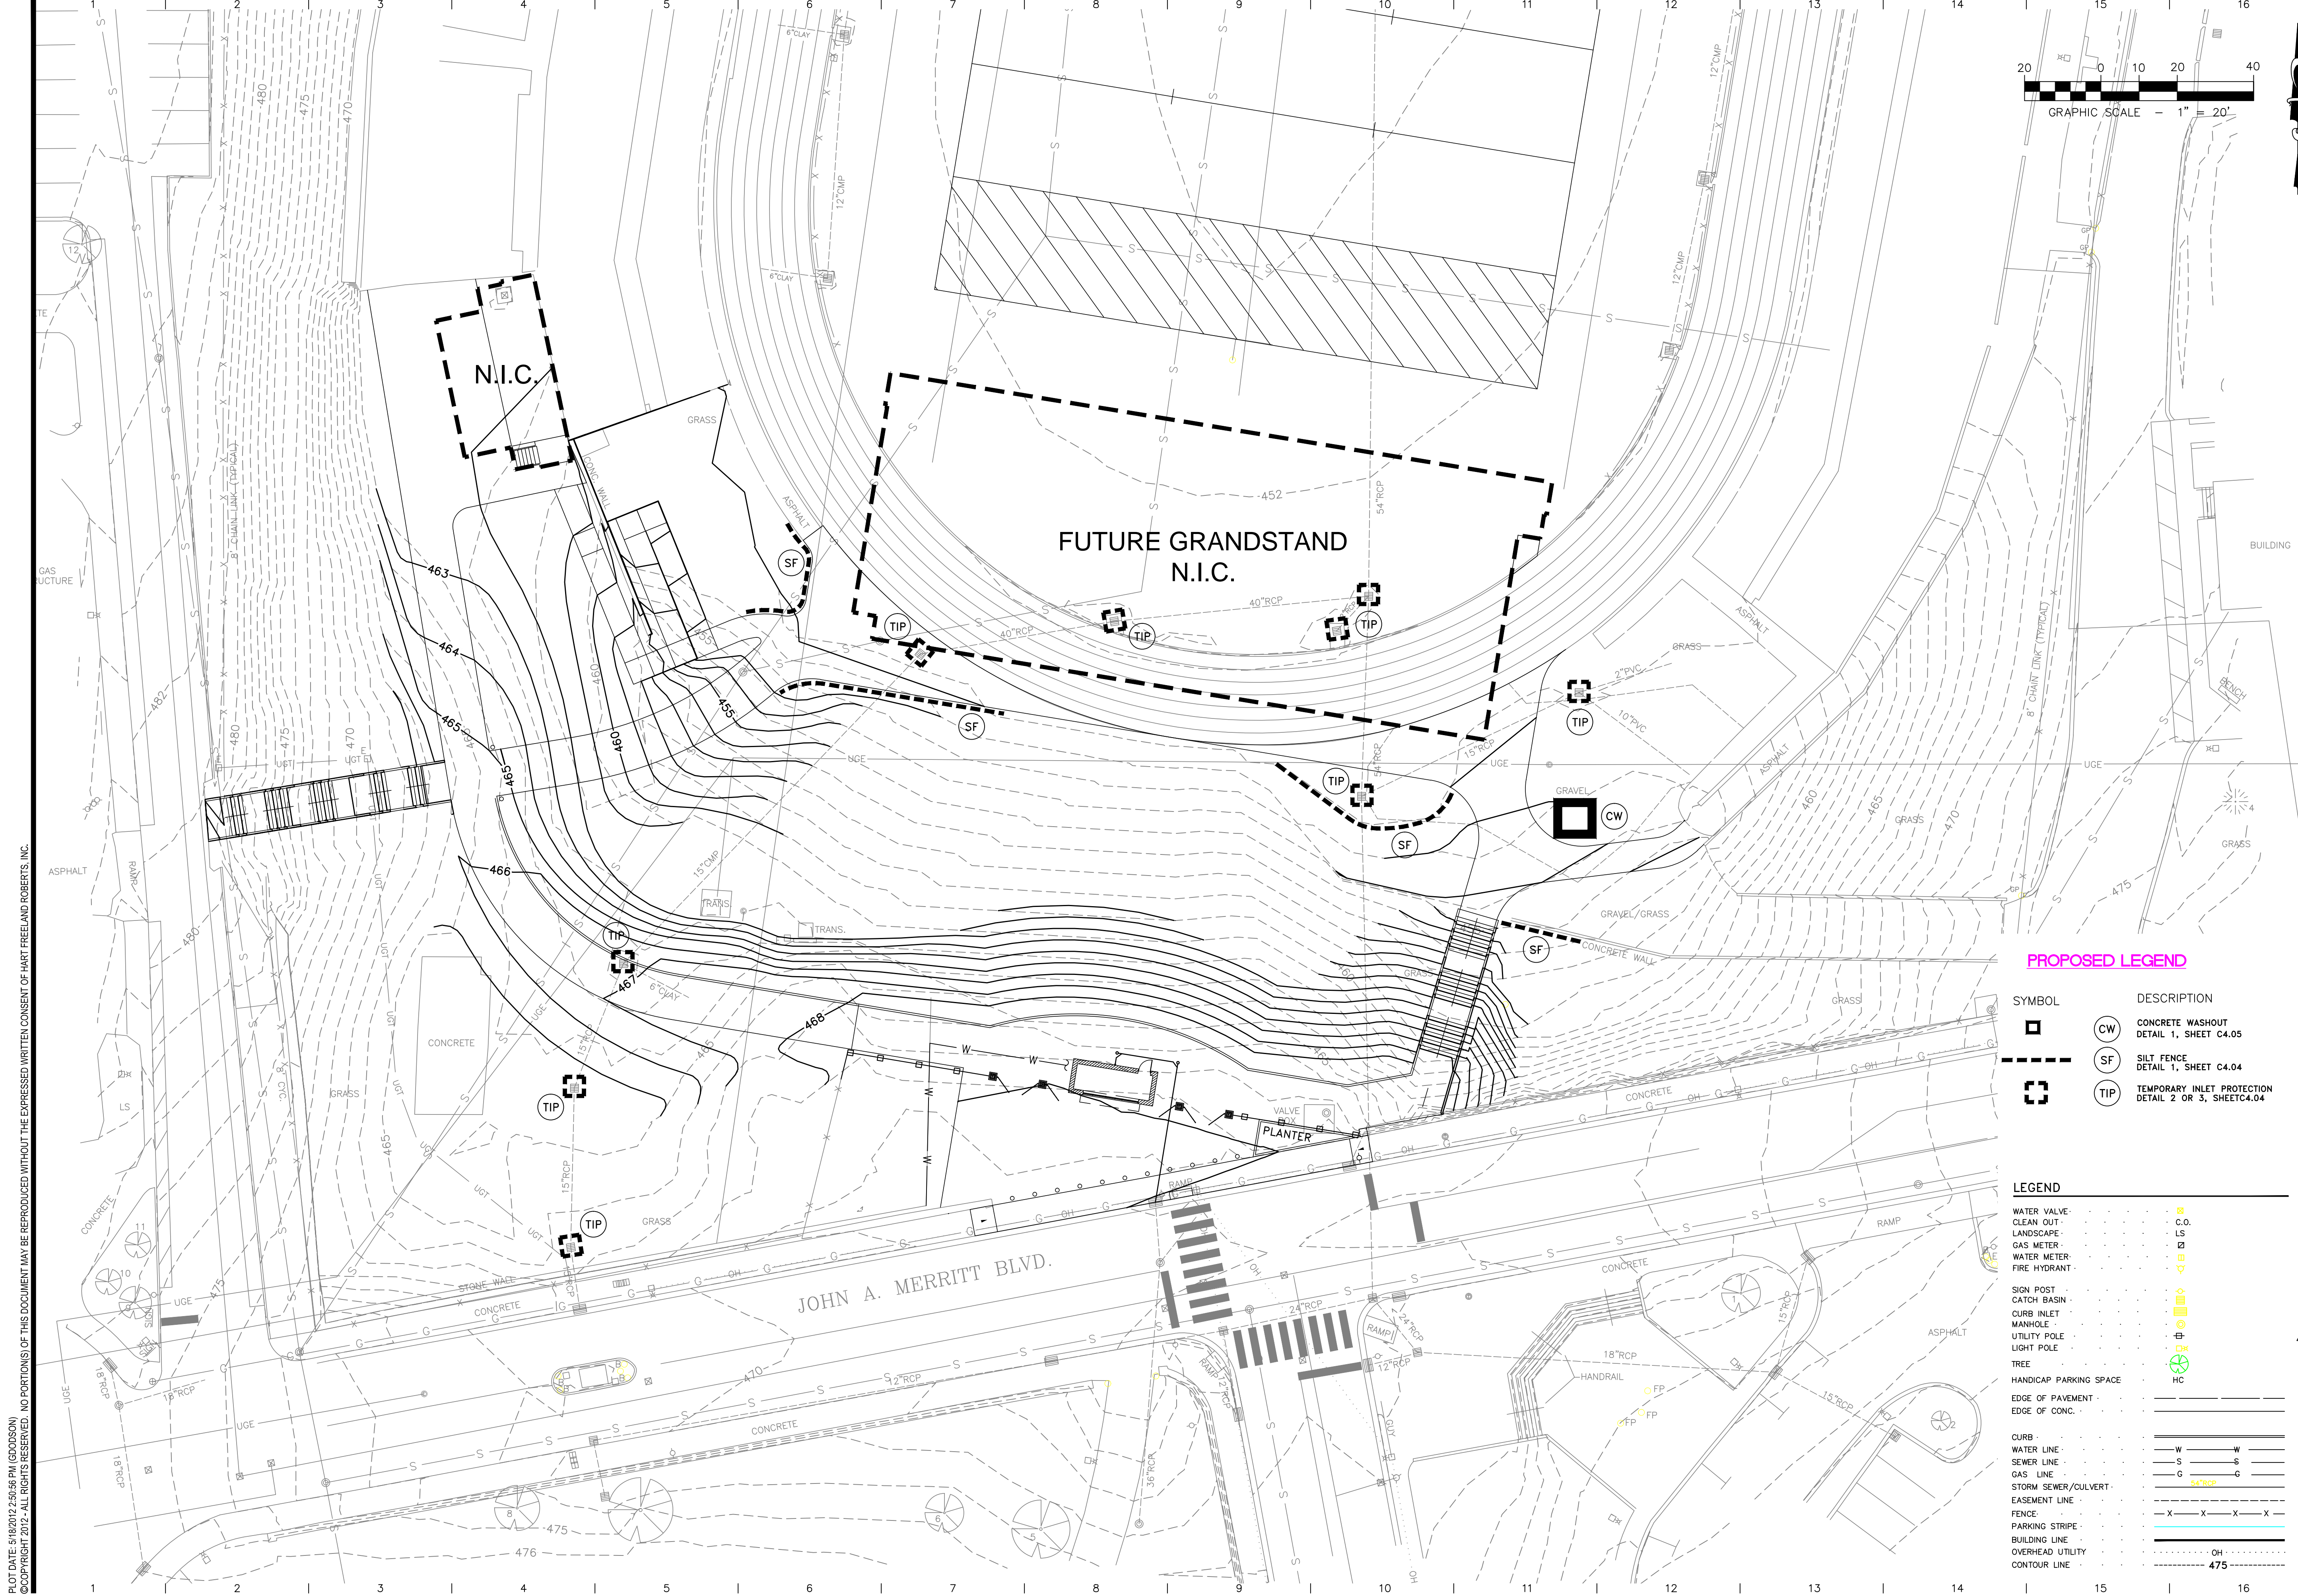




HFR DESIGN

ARCHITECTURE
ENGINEERING
PLANNING
INTERIORS

HART FREELAND ROBERTS, INC.
7101 Executive Center Drive
Suite 300
Brentwood, TN 37024
615.370.8500 phone
615.370.8530 fax
www.hfrdesign.com web
Nashville, Tennessee
Jackson, Tennessee
Kansas City, Missouri
Louisville, Kentucky

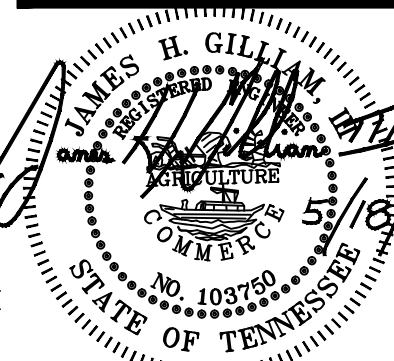




NO.	DATE	REVISION	ADDENDUM #2
1	5/18/12		
2			
3			
HALE STADIUM RENOVATIONS
NORTH AND SOUTH ENTRIES
TENNESSEE STATE UNIVERSITY
JOHN A MERRITT BLVD
NASHVILLE, TN
SBC# 166/001-02-2011

PROJ. NO.: 2011171
DATE: 25 APRIL 2012

CONSTRUCTION
EROSION
CONTROL
PLAN, SOUTH
ENTRY PLAZA

C2.05

SYMBOL	DESCRIPTION
	CW CONCRETE WASHOUT DETAIL 1, SHEET C4.05
	SF SILT FENCE DETAIL 1, SHEET C4.04
	TIP TEMPORARY INLET PROTECTION DETAIL 2 OR 3, SHEET C4.04


LEGEND	
WATER VALVE	C.O.
CLEAN OUT	LS
LANDSCAPE	LS
GAS METER	GM
WATER METER	WM
FIRE HYDRANT	FD
SIGN POST	SP
CATCH BASIN	CB
CURB INLET	CI
MANHOLE	MH
UTILITY POLE	UP
LIGHT POLE	LP
TREE	HC
HANDICAP PARKING SPACE	HP
EDGE OF PAVEMENT	EP
EDGE OF CONC.	EC
CURB	C
WATER LINE	W
SEWER LINE	S
GAS LINE	G
STORM SEWER/CULVERT	SS
EASEMENT LINE	EL
FENCE	F
PARKING STRIPE	PS
BUILDING LINE	BL
OVERHEAD UTILITY	OH
CONTOUR LINE	475

PLOT DATE: 5/18/2012 2:50:58 PM (GOODSON)
© COPYRIGHT 2012 - ALL RIGHTS RESERVED. NO PORTIONS OF THIS DOCUMENT MAY BE REPRODUCED WITHOUT THE EXPRESSED WRITTEN CONSENT OF HART FREELAND ROBERTS, INC.
C:\2011\TVC\Shs-2011171.dwg, C2.05, 5/18/2012 2:50:53 PM, C:\goodson

AS-BUILT INFORMATION TO INCLUDE:
 DRY PONDS (POND CONTOURS, OUTLET STRUCTURE DETAILS INCLUDING INLET
 AND OUTLET INVERTS).



Nashville, Tennessee
Jackson, Tennessee
Kansas City, Missouri
Louisville, Kentucky

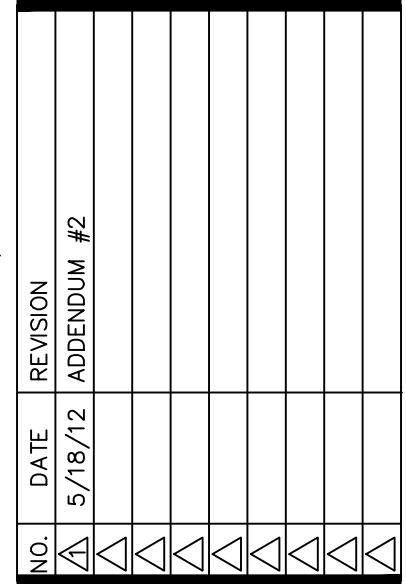

DATE: 25 APRIL 2012


C2.07

1. **BIORETENTION AREA** (Refer to PTP-03 Volume 4 Best Management Practices Stormwater Management Manual)


- Check banks and bottom surface of basin for erosion and correct as necessary.
- Check at least quarterly and after each extreme storm event; the facility should be cleaned of accumulated debris.
- This maintenance typically includes sediment, floatable, and debris removal from inlets and outlets.
- Pond vegetation needs to be trimmed or harvested as appropriate.
- Remove sediment when accumulation reaches 6 inches or if re-suspension is observed or probable.
- Some sediment may contain contaminants of which the Tennessee Department of Environment and Conservation (TDEC) require special disposal procedures. If there is any uncertainty about what the sediment contains or it is known to contain contaminants, then TDEC should be consulted and their disposal recommendations followed. The TDEC Division of Water Pollution Control can be contacted at (615) 532-0625. Generally, special attention or sampling should be given to large parking areas, or other areas where pollutants (other than clean soil) are suspected to accumulate and be conveyed by storm runoff.
- Some sediment collected may be innocuous (free of pollutants) and can be used as fill material cover or land spreading. It is important that this material not be placed in any way that will promote or allow re-suspension in storm runoff.

2. **STORM SYSTEM PIPES AND CATCH BASINS**

- These systems should be inspected and cleaned annually.

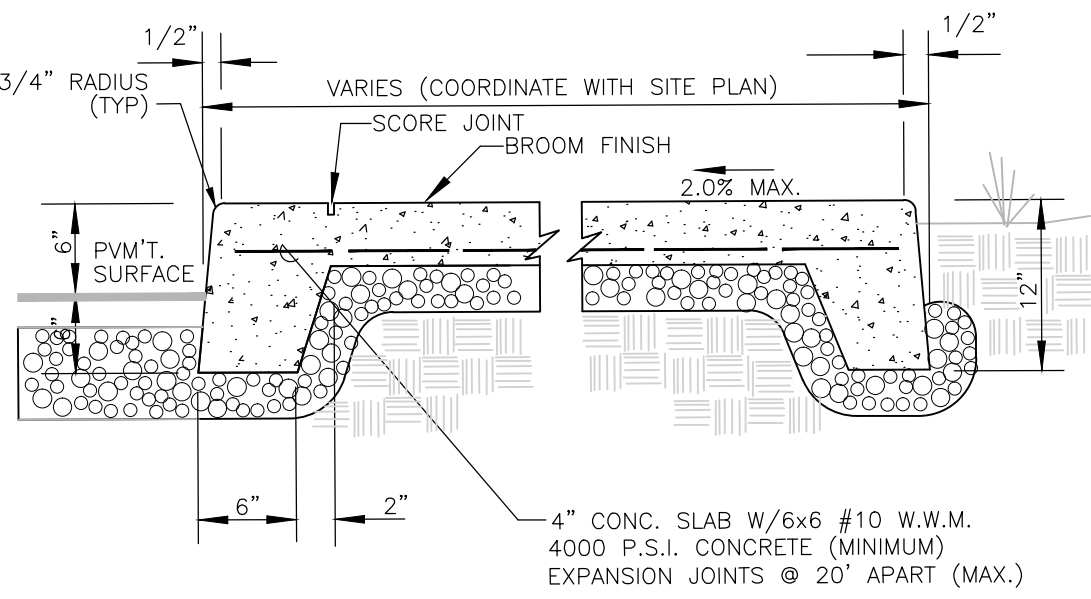

SIDEWALK AT PAVEMENT

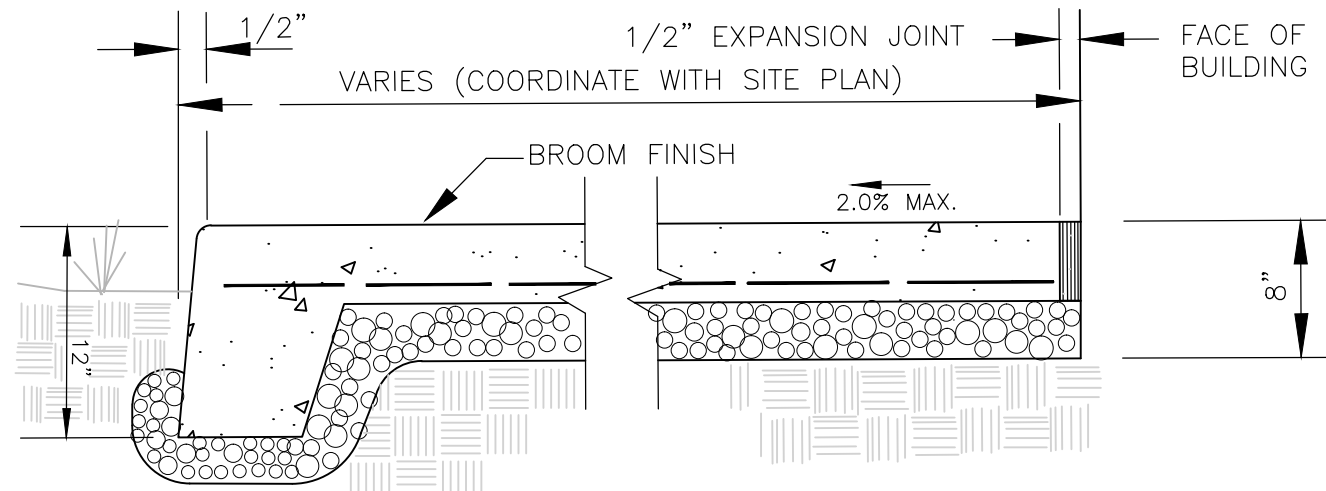


SIDEWALK AT BUILDING


NOTES:
SIDEWALKS SHALL BE 4" MIN. THICKNESS
WITH 4" CRUSHED STONE BASE.
WHERE ADJACENT TO A FIXED STRUCTURE
A 1/2" EXPANSION JOINT WITH FILLER
SHALL BE INSTALLED.
COORDINATE WITH JOINT DETAIL THIS SHEET.
WHERE WALK ABUTS ASPHALT, PROVIDE A
TOOLED JOINT 6" FROM FACE OF CURB.

1 CONCRETE SIDEWALK

NOT TO SCALE

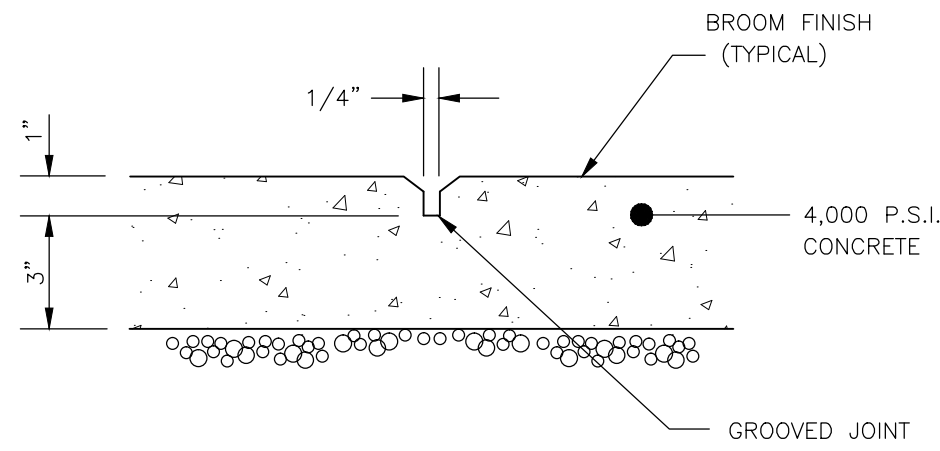


CONTROL JOINT

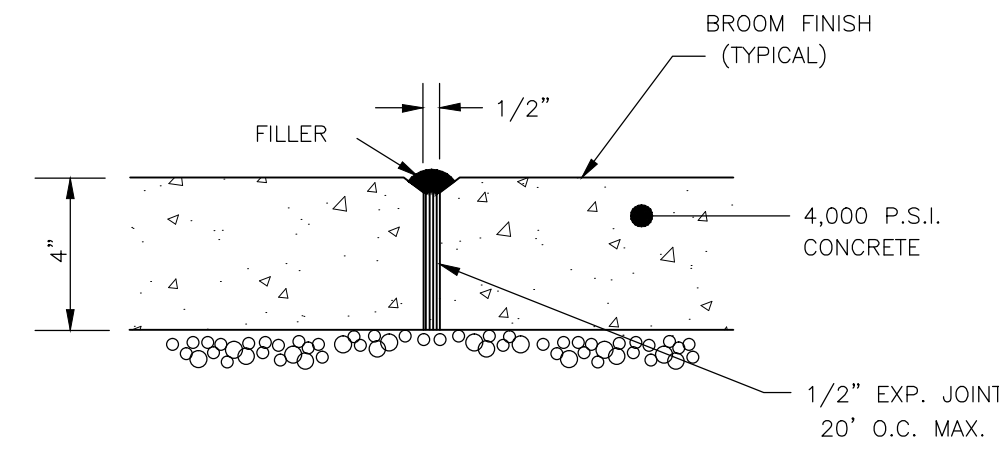

EXPANSION JOINT


2 CONCRETE JOINTS

NOT TO SCALE

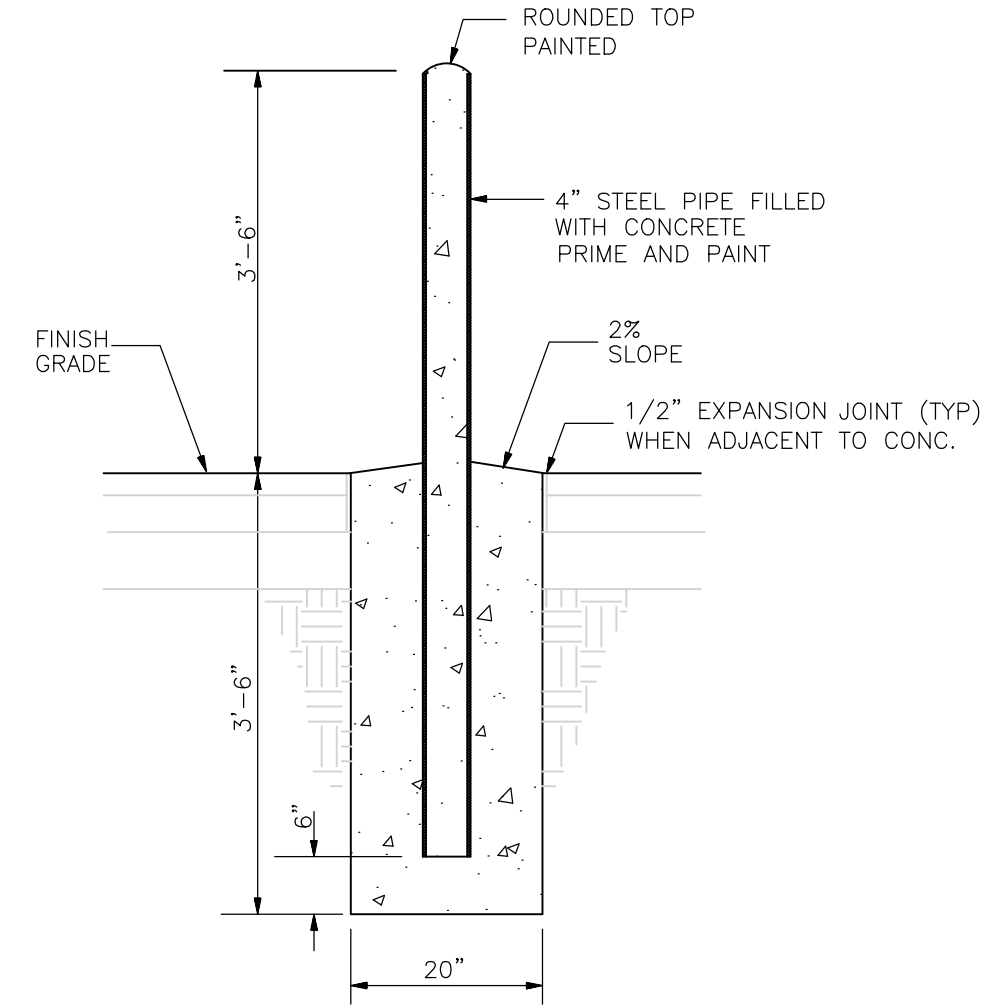

3 STEEL PIPE BOLLARD


NOT TO SCALE

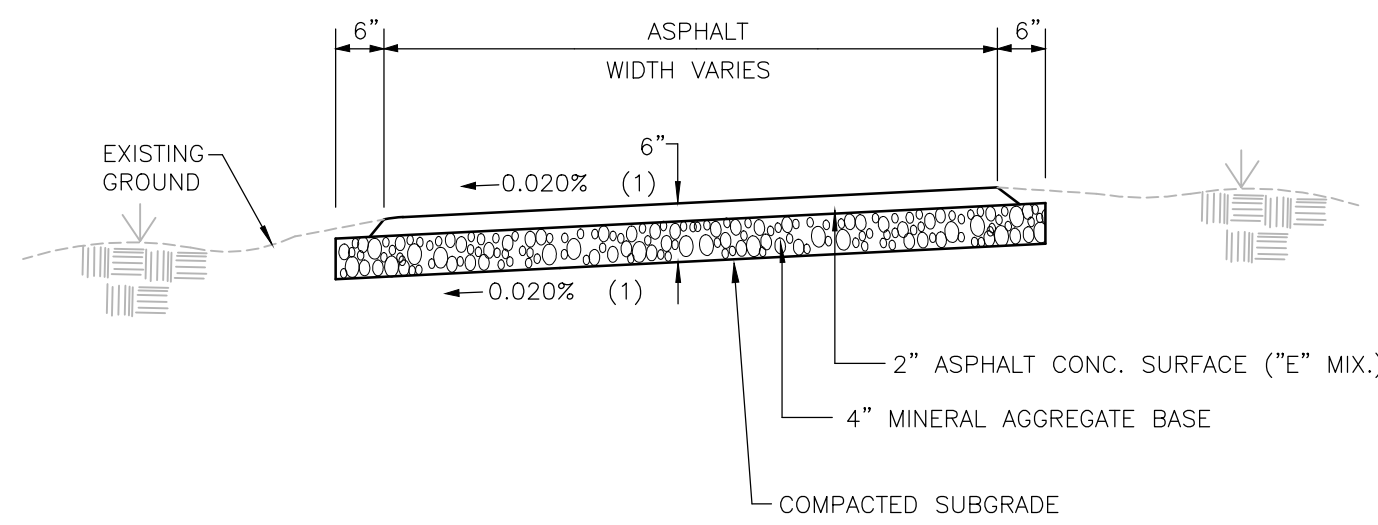

(1) CROSS SLOPE SHALL BE IN THE DIRECTION
OF THE SLOPE OF EXISTING GROUND.

4 ASPHALT PAVING

NOT TO SCALE

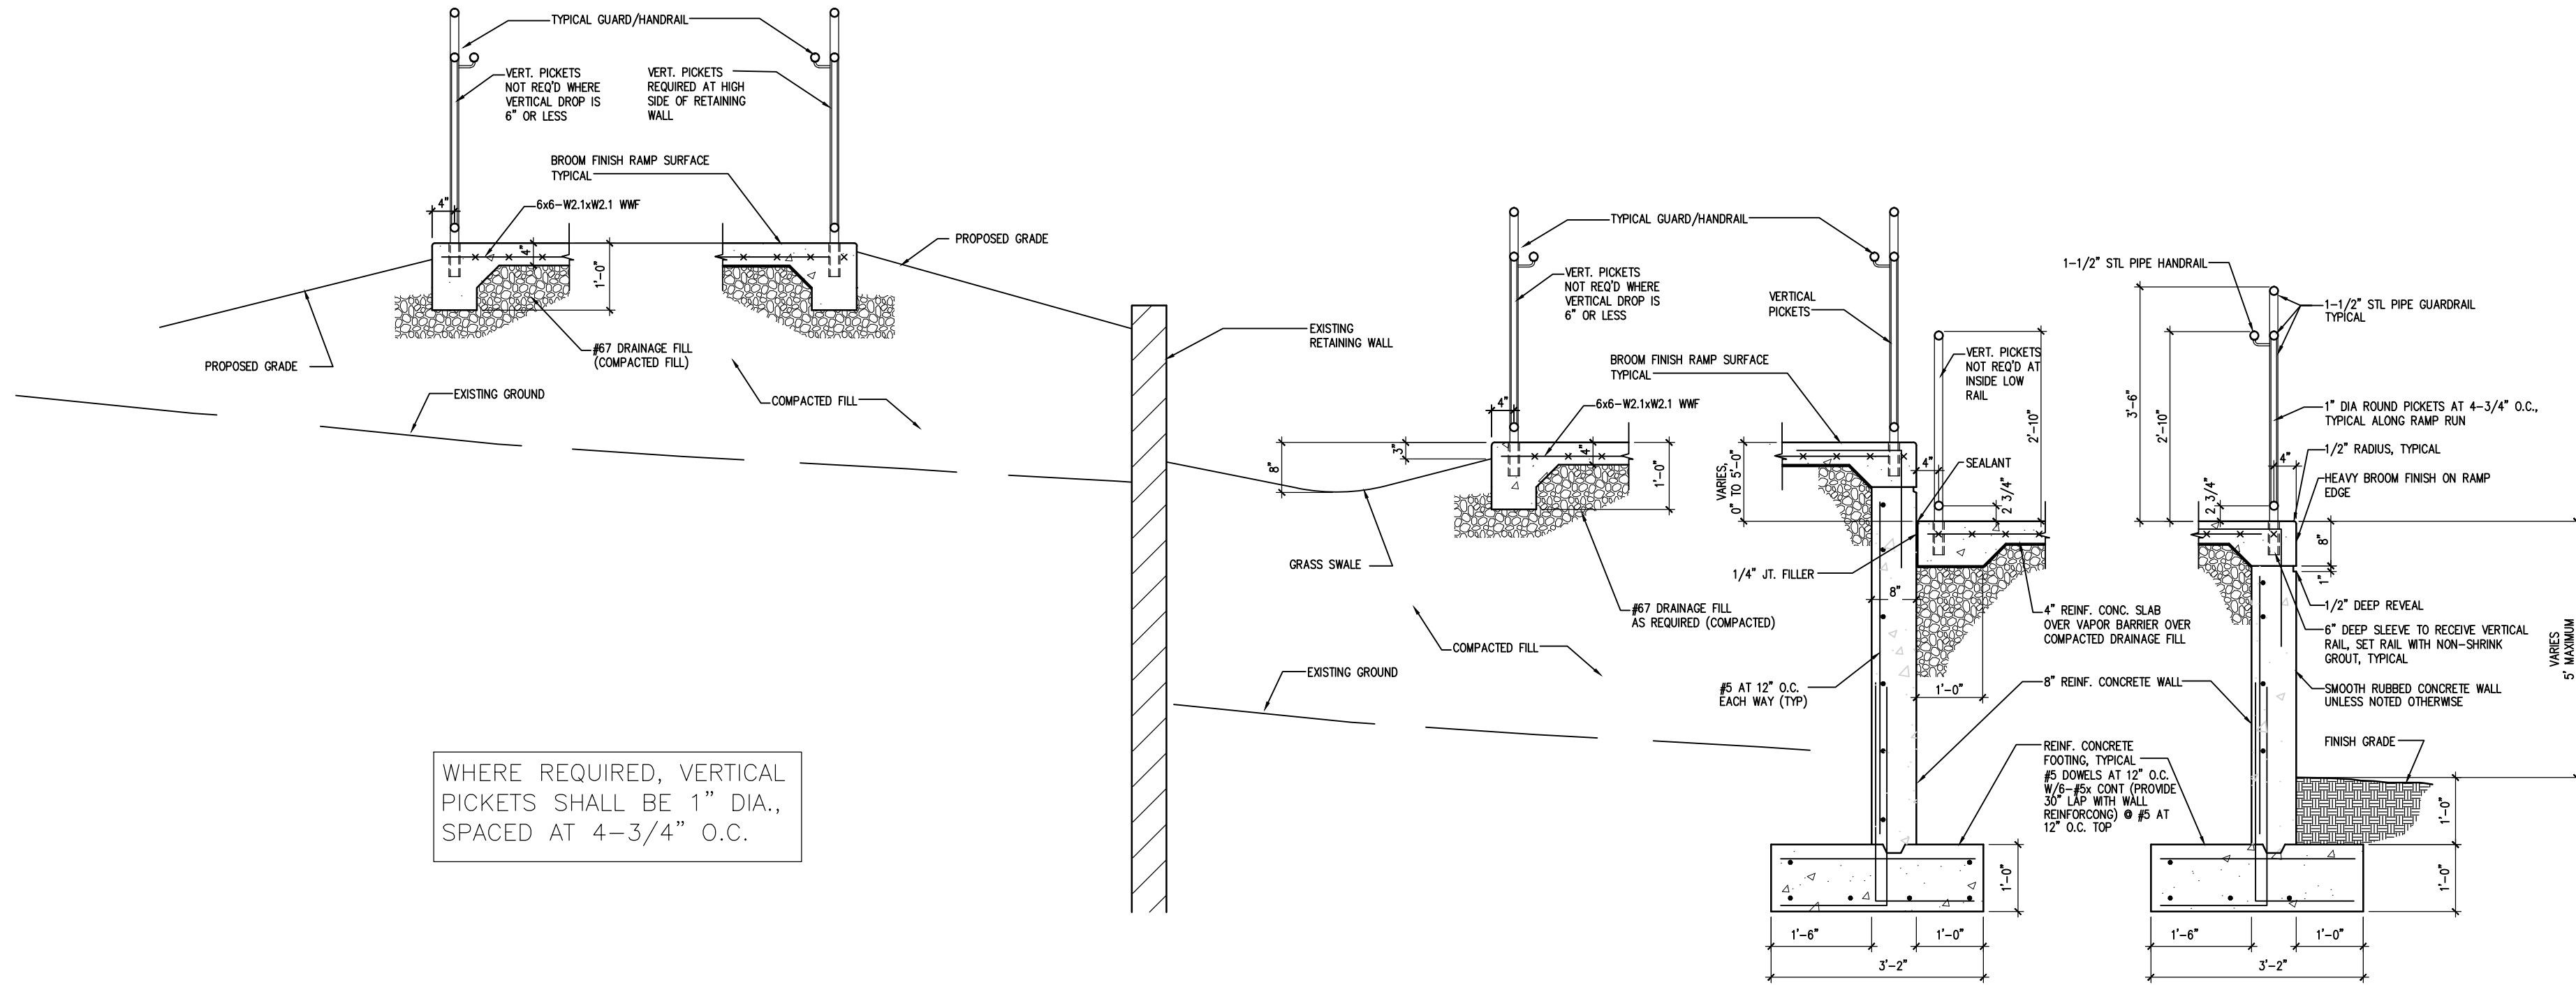

WHERE REQUIRED, VERTICAL
PICKETS SHALL BE 1" DIA.,
SPACED AT 4-3/4" O.C.


5 ACCESSIBLE RAMP

NOT TO SCALE



ARCHITECTURE
ENGINEERING
PLANNING
INTERIORS

HART FREELAND ROBERTS, INC.
7101 Executive Center Drive
Suite 300
Brentwood, TN 37024
615.370.8500 phone
615.370.8530 fax
www.hfrdesign.com web
Nashville, Tennessee
Jackson, Tennessee
Kansas City, Missouri
Louisville, Kentucky

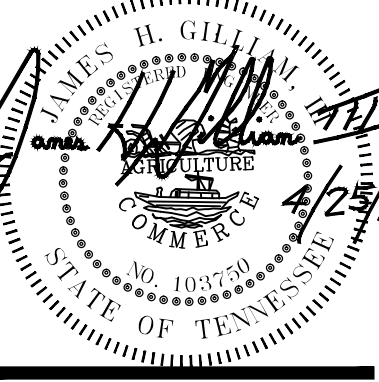


HALE STADIUM RENOVATIONS
NORTH AND SOUTH ENTRIES
TENNESSEE STATE UNIVERSITY
JOHN A MERRITT BLVD
NASHVILLE, TN
SBC# 166/001-02-2011


PROJ. NO.: 2011171
DATE: 25 APRIL 2012

SITE
DETAILS


C4.01

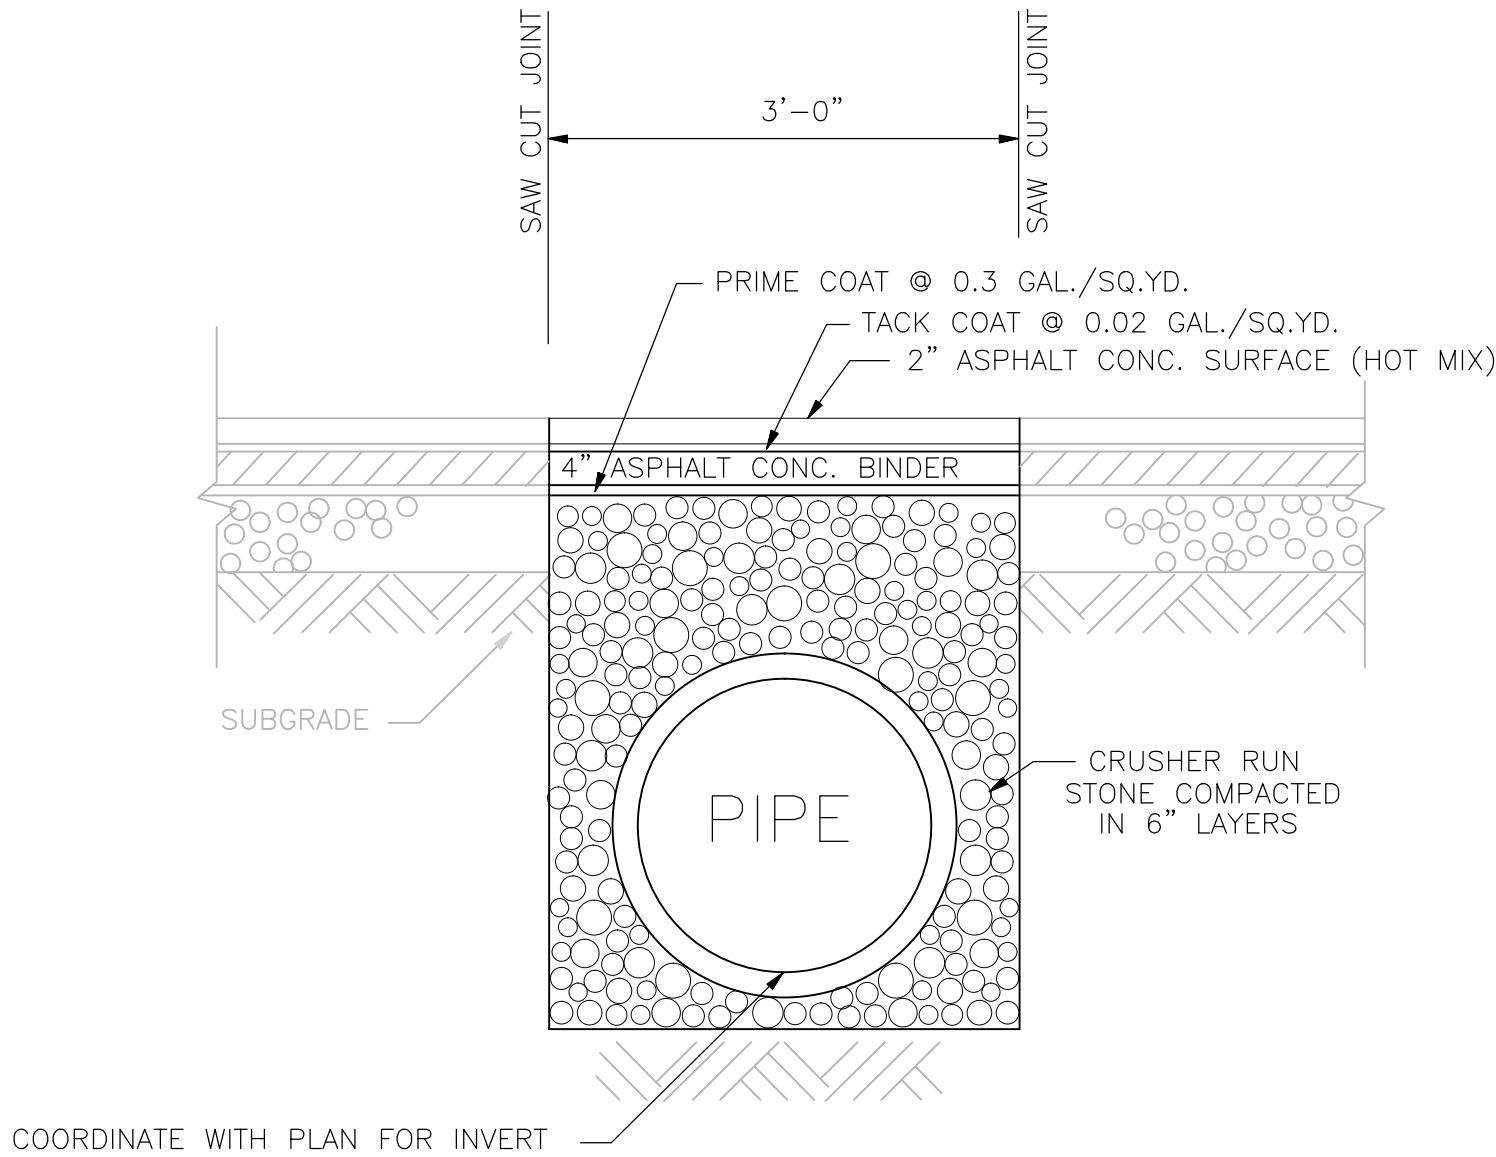


1 TRENCH REPAIR
NOT TO SCALE

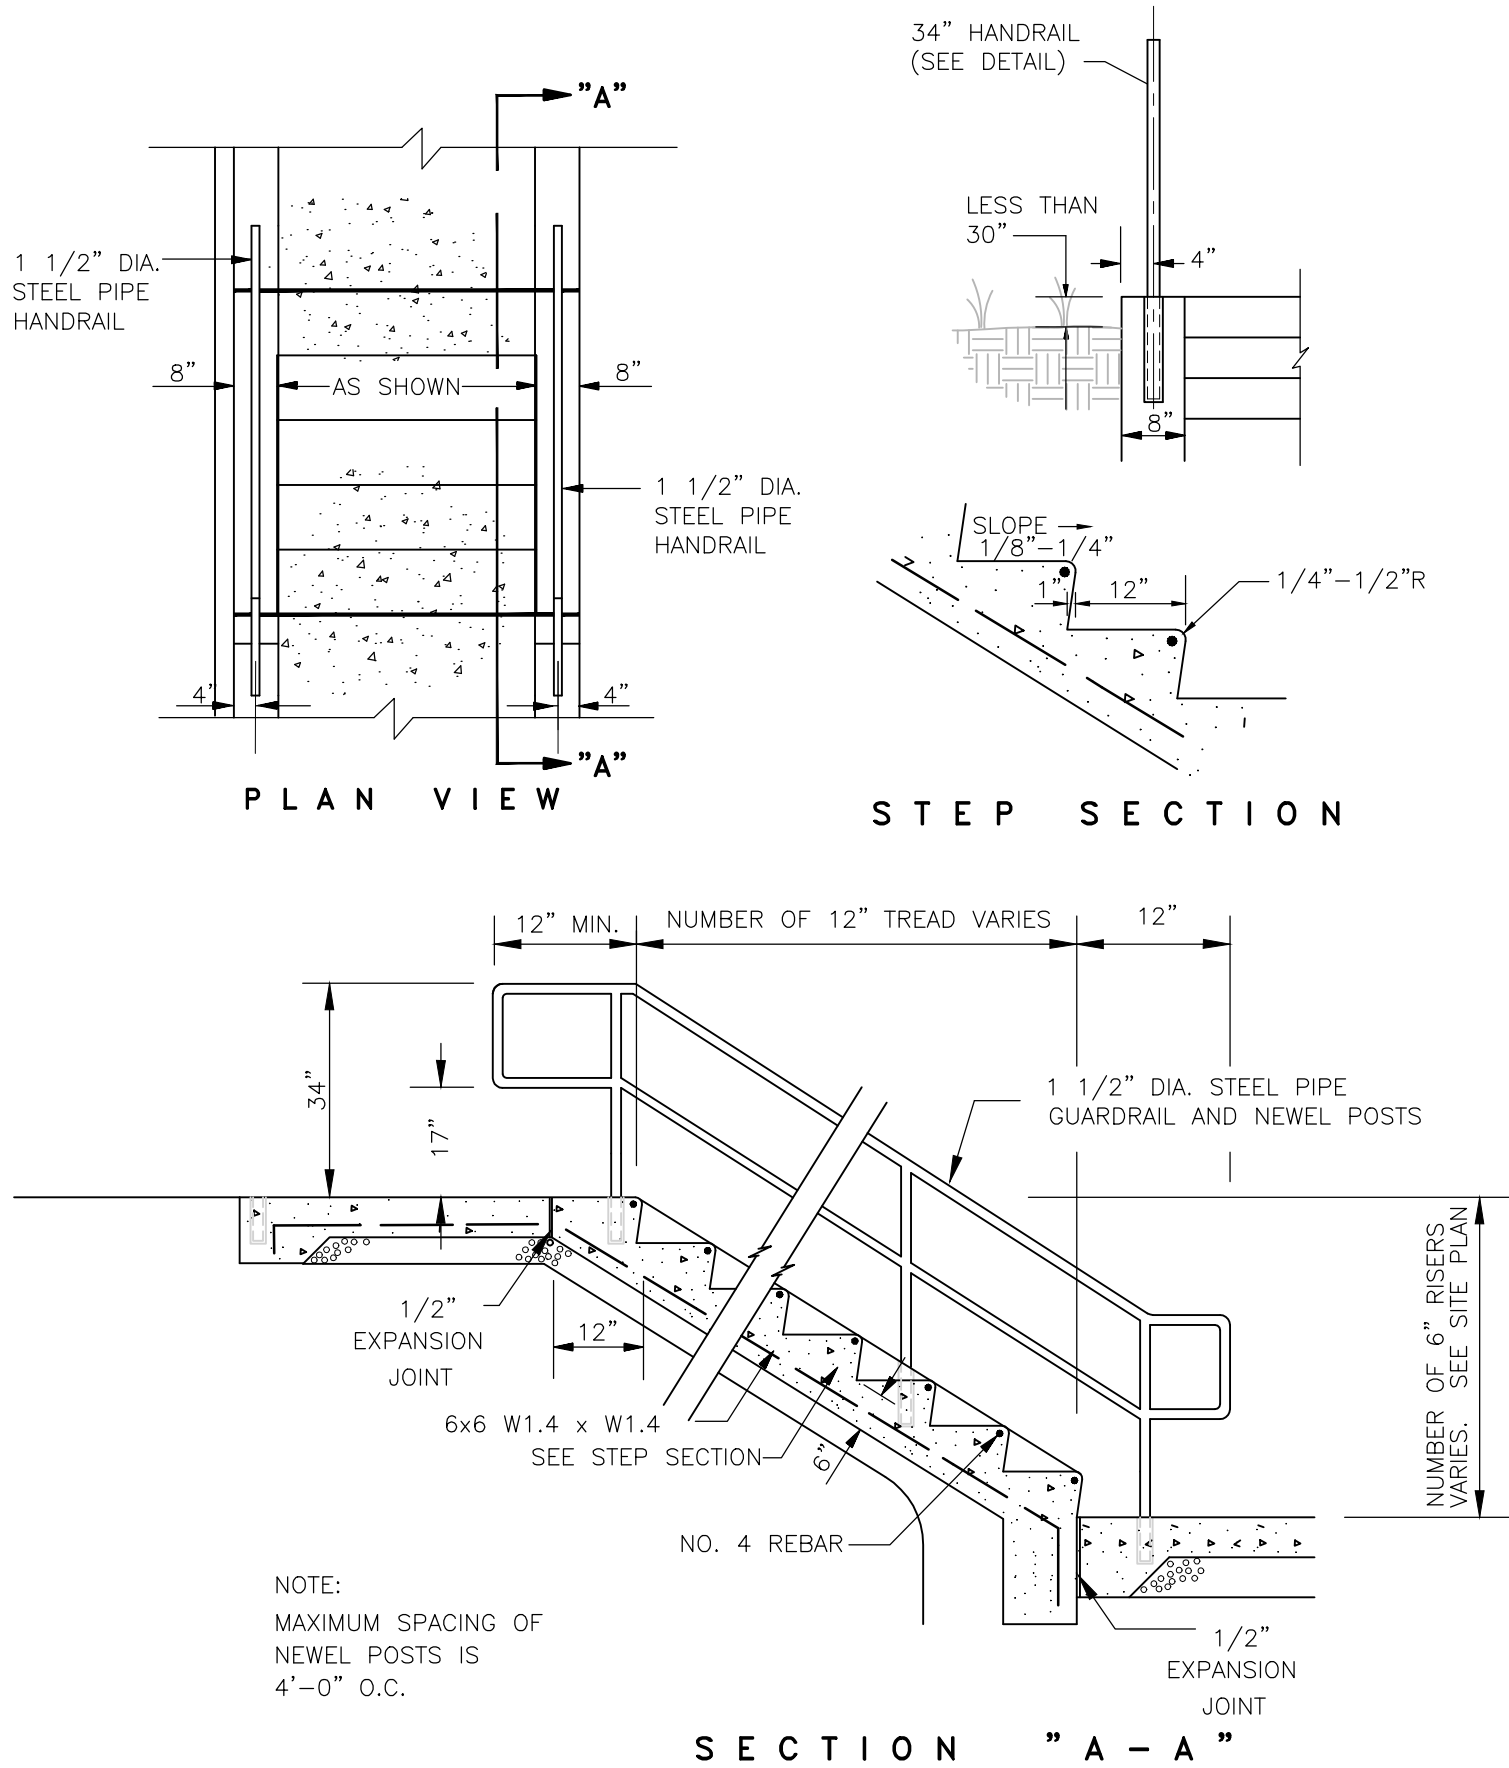


2 CONCRETE STEPS
NOT TO SCALE

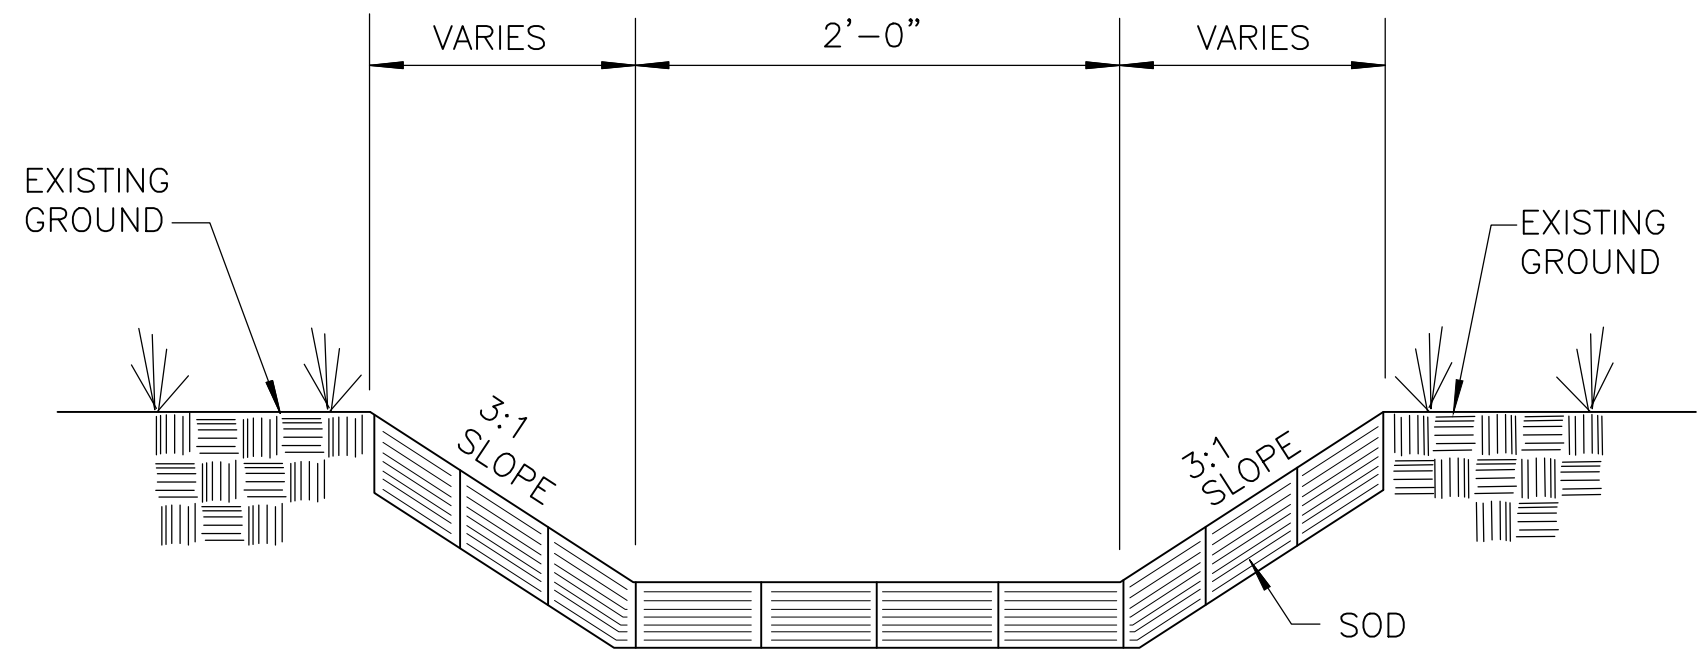


3 SODDED DITCH
NOT TO SCALE

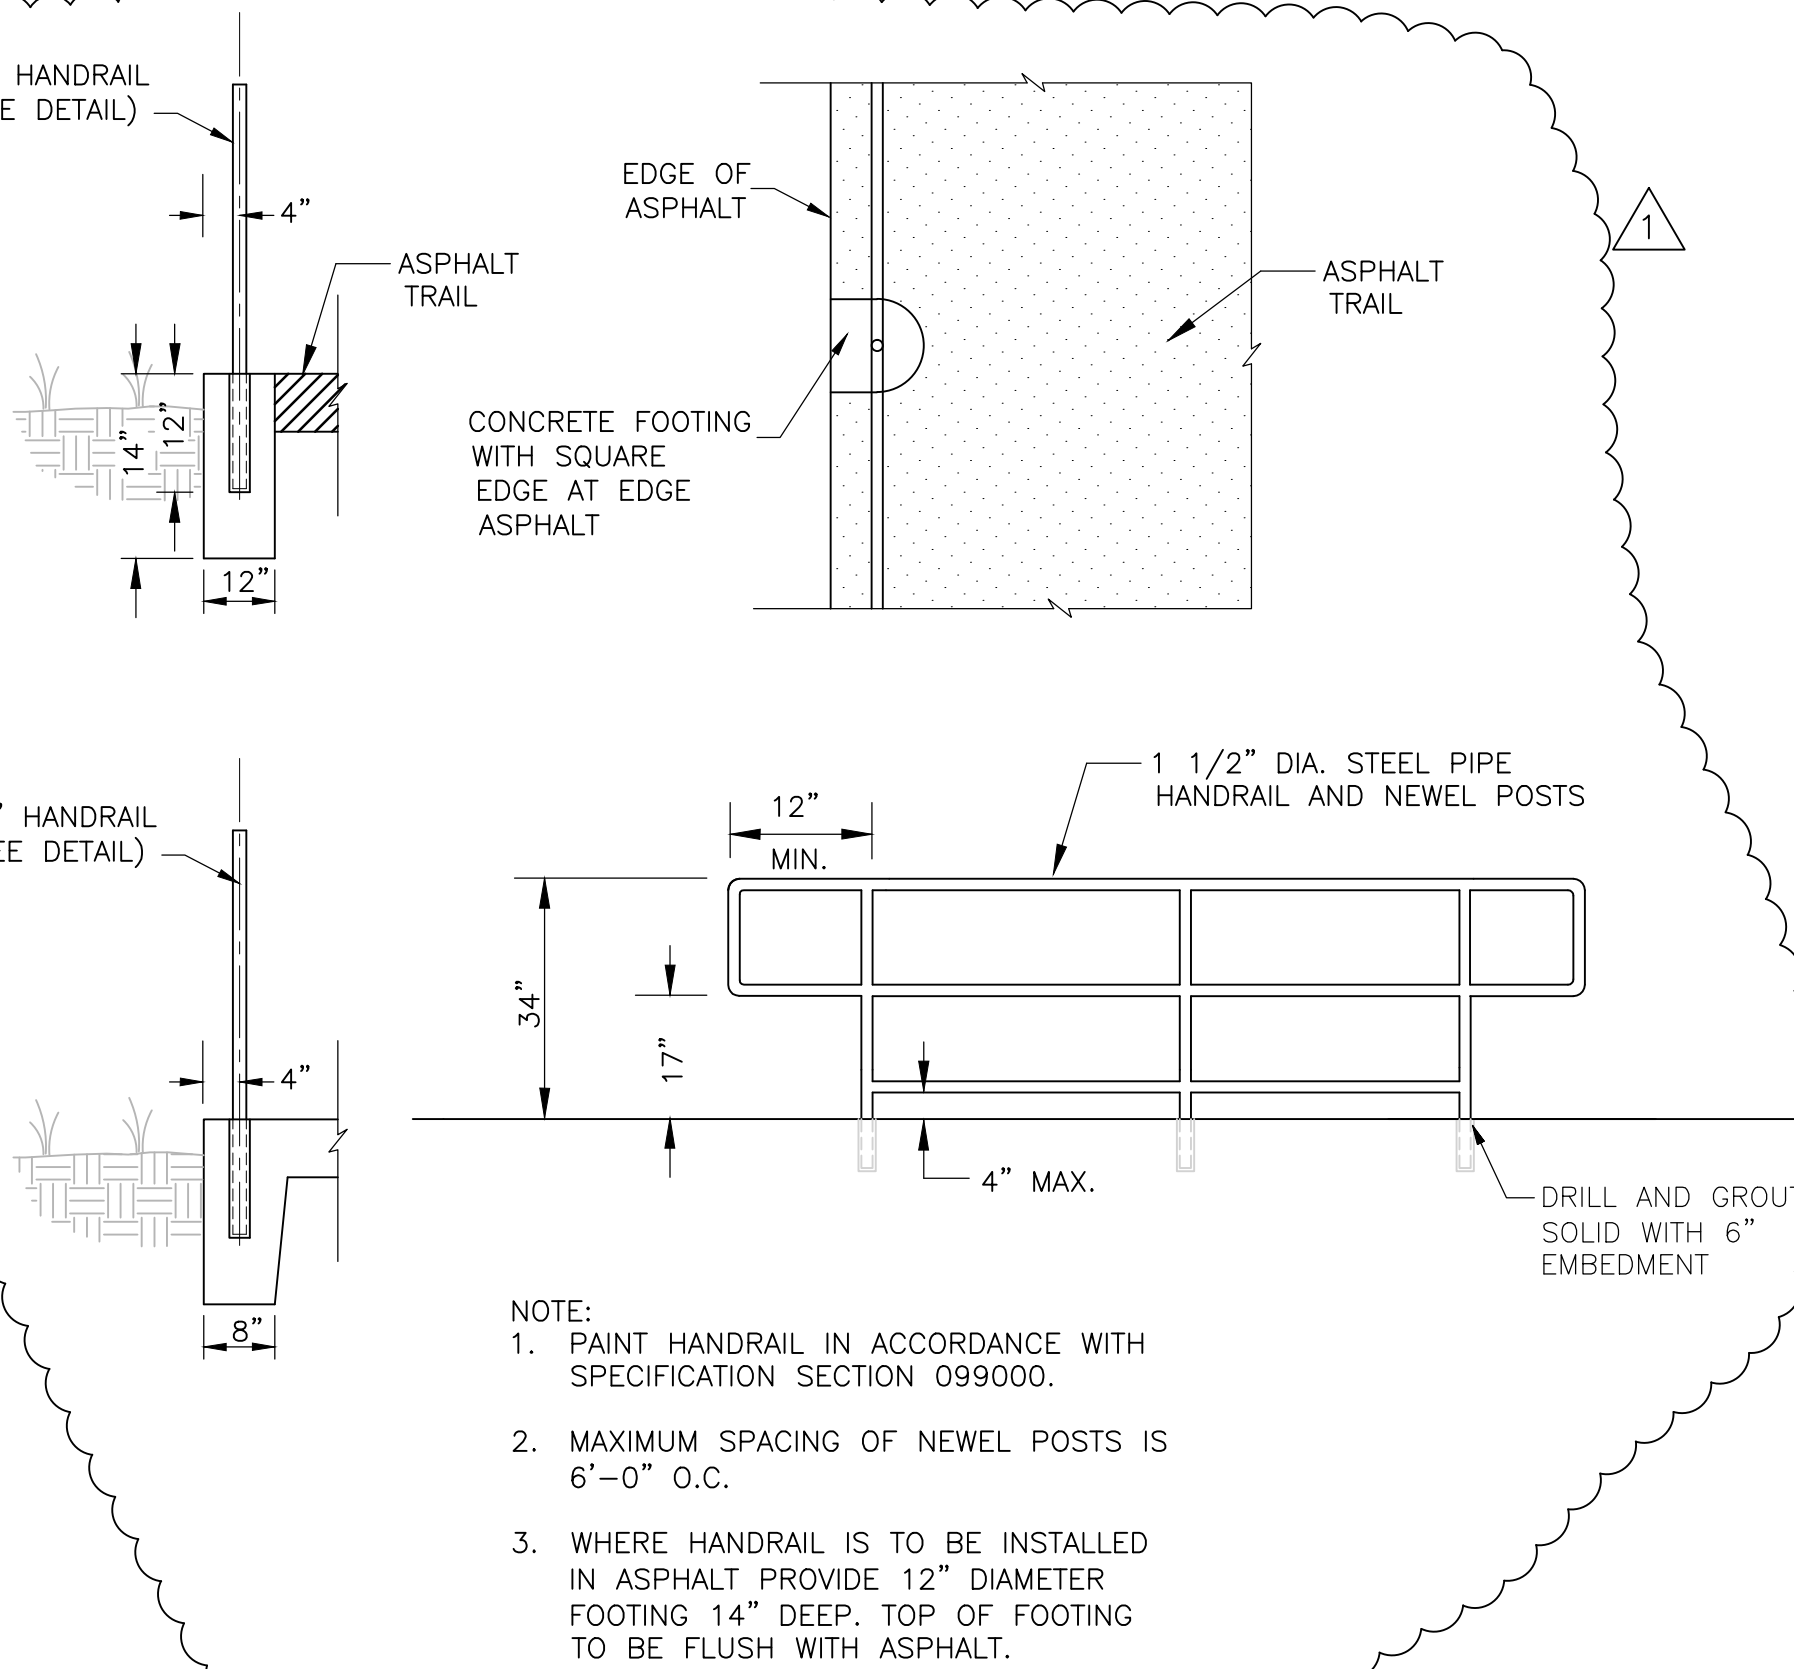

4 HANDRAIL
NOT TO SCALE

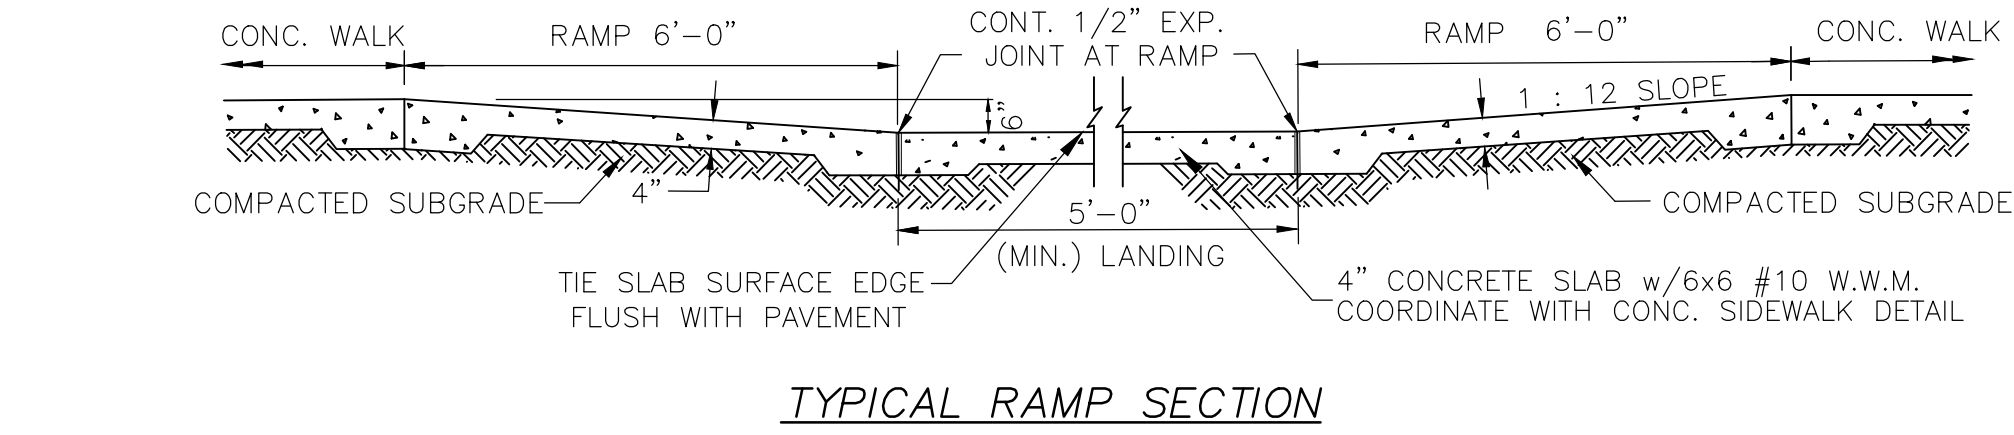

TYPICAL RAMP SECTION

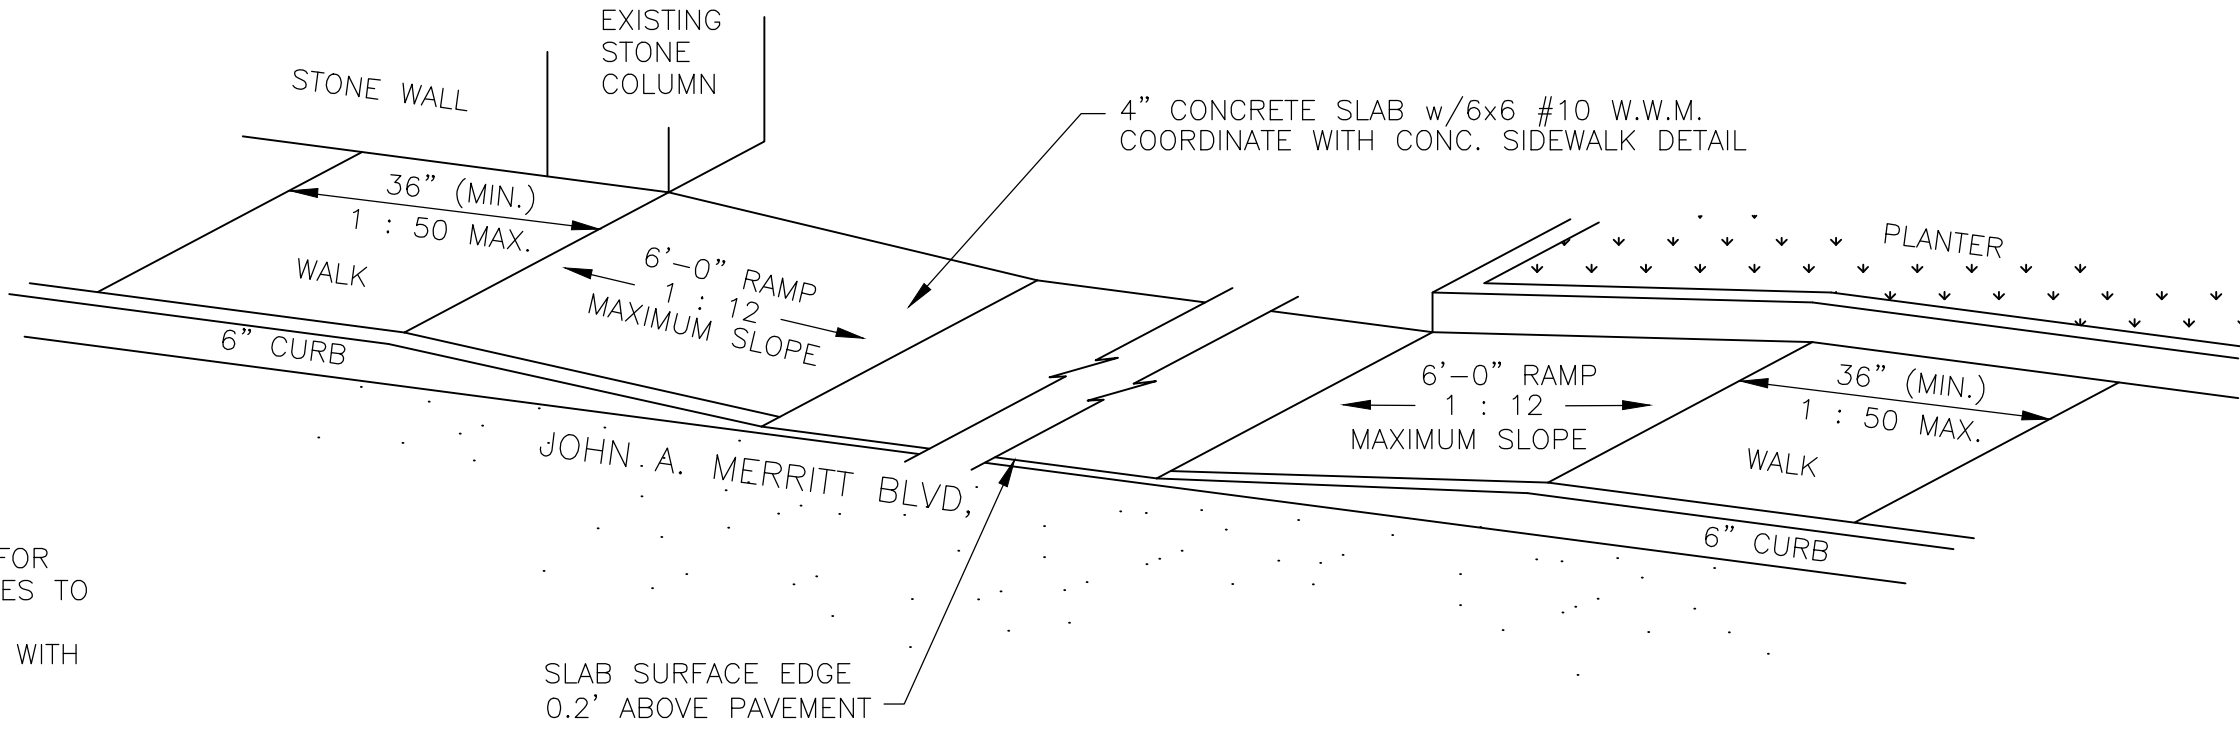

5 SOUTH PLAZA ENTRY RAMP
NOT TO SCALE




ARCHITECTURE
ENGINEERING
PLANNING
INTERIORS

HART FREELAND ROBERTS, INC.
7101 Executive Center Drive
Suite 300
Brentwood, TN 37024

615.370.8500 phone
615.370.8530 fax
www.hfrdesign.com web

Nashville, Tennessee
Jackson, Tennessee
Kansas City, Missouri
Louisville, Kentucky

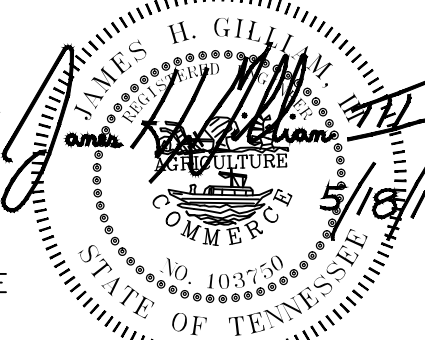

NO.	DATE	REVISION	ADDENDUM #2
1	5/18/12		
2			
3			
HALE STADIUM RENOVATIONS
NORTH AND SOUTH ENTRIES
TENNESSEE STATE UNIVERSITY


JOHN A MERRITT BLVD
NASHVILLE, TN
SBC# 166/001-02-2011

PROJ. NO.: 2011171
DATE: 25 APRIL 2012


**SITE
DETAILS**

C4.02

PLOT DATE: 5/18/2012 3:02:12 PM (GOODSON)
© COPYRIGHT 2012 - ALL RIGHTS RESERVED. NO PORTIONS OF THIS DOCUMENT MAY BE REPRODUCED WITHOUT THE EXPRESSED WRITTEN CONSENT OF HART FREELAND ROBERTS, INC.
C:\2011\TVC\DETAILS 2011171.dwg, C:\02, 5/18/2012 3:02:12 PM, C:\dson

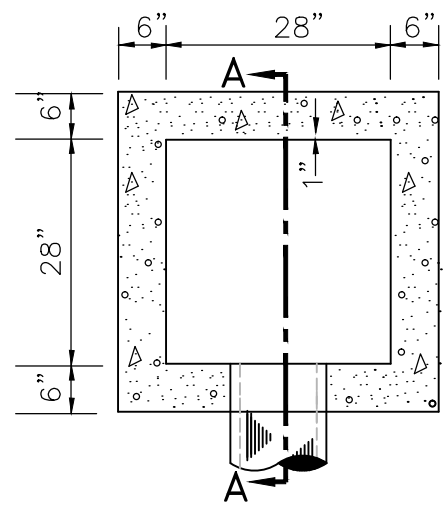

PLAN

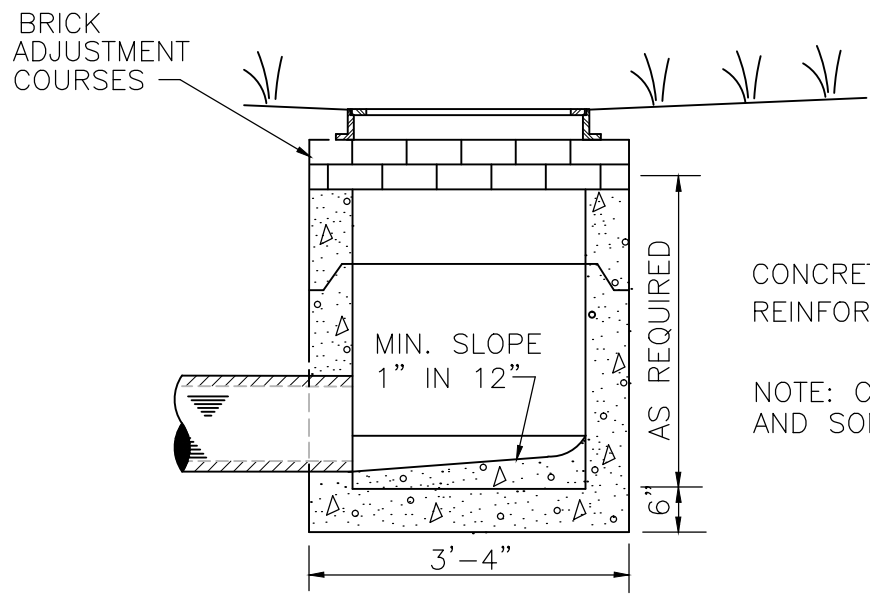



SECTION A-A

CONCRETE : 4000 PSI AT 28 DAYS
REINFORCED WITH NO. 4, GRADE 60 BARS

NOTE: CASTING SHALL BE JOHN BOUCHARD
AND SONS NO 4330.



1 CATCH BASIN

NOT TO SCALE

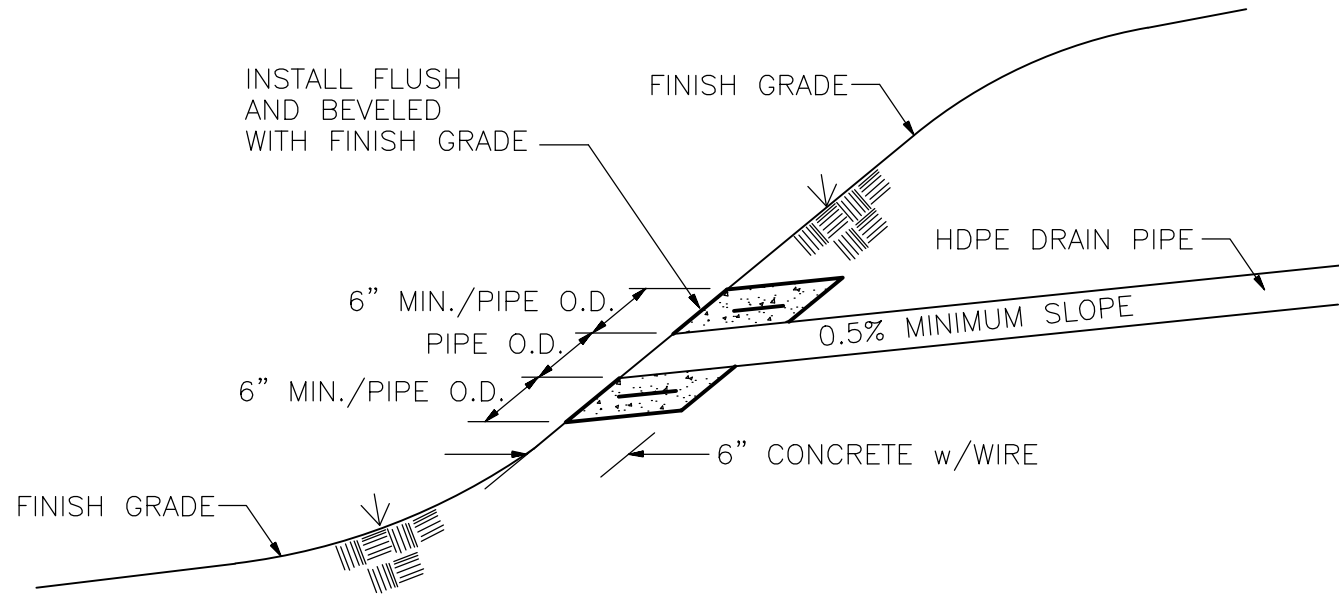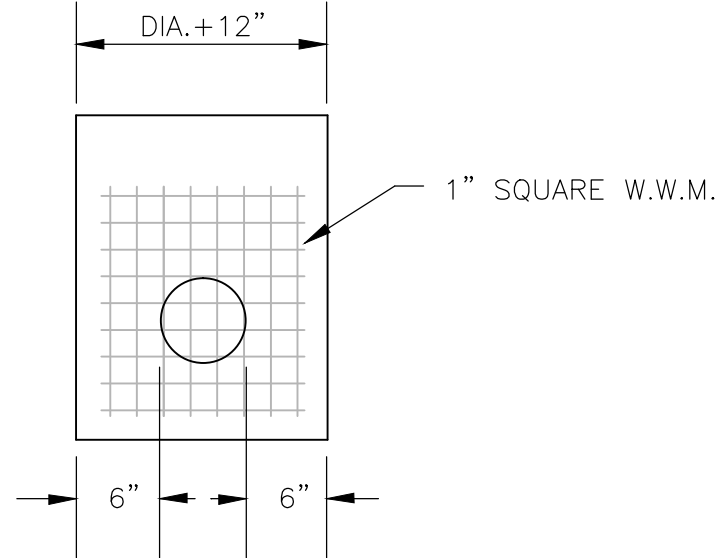

2 CONCRETE ENDWALL

NOT TO SCALE

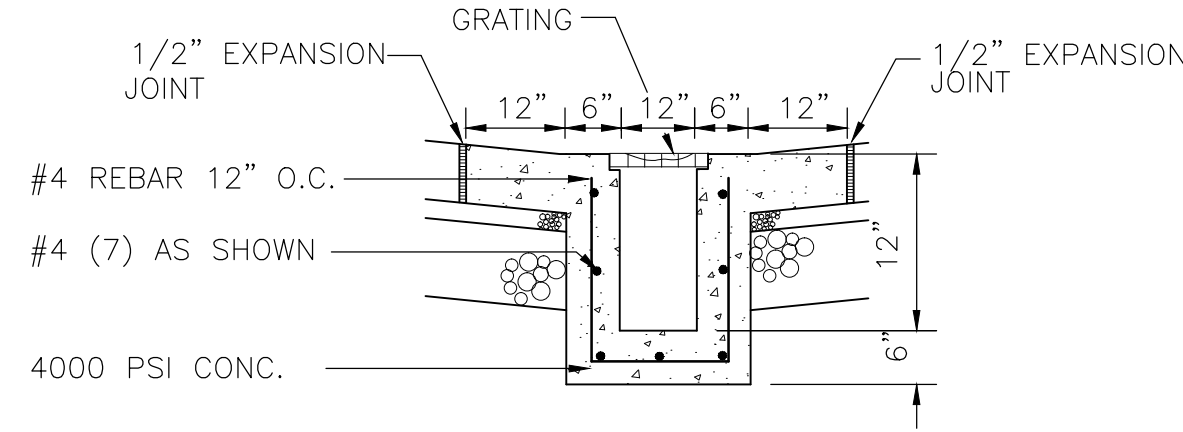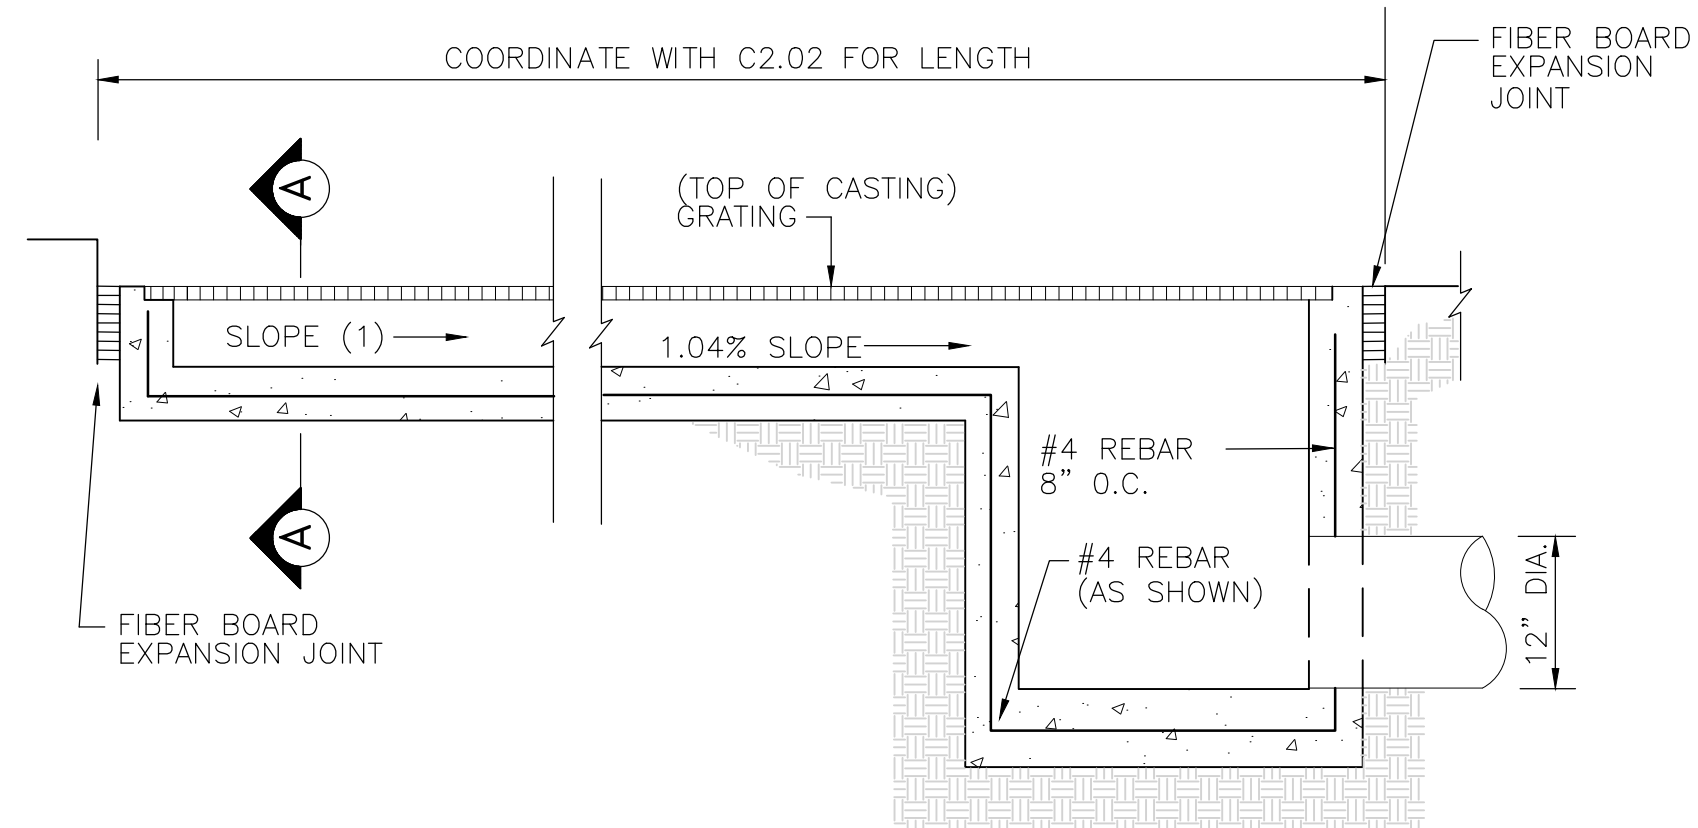


SECTION A-A

ZURN PERMA-TRENCH
DRAIN NO. Z882-12
WITH 24"x24"
PERMA-TRENCH CATCH
BASIN, NO. Z887, AND
HEEL-PROOF DUCTILE
SLOTTED GRATE, CLASS
E, OR APPROVED EQUAL.

(1) 104 LF OF TRENCH
DRAIN SHALL BE
NEUTRAL SLOPE, 8203N.
INSTALLATION SHALL
FOLLOW SLOPE OF
EXISTING ASPHALT.

3 TRENCH DRAIN


NOT TO SCALE

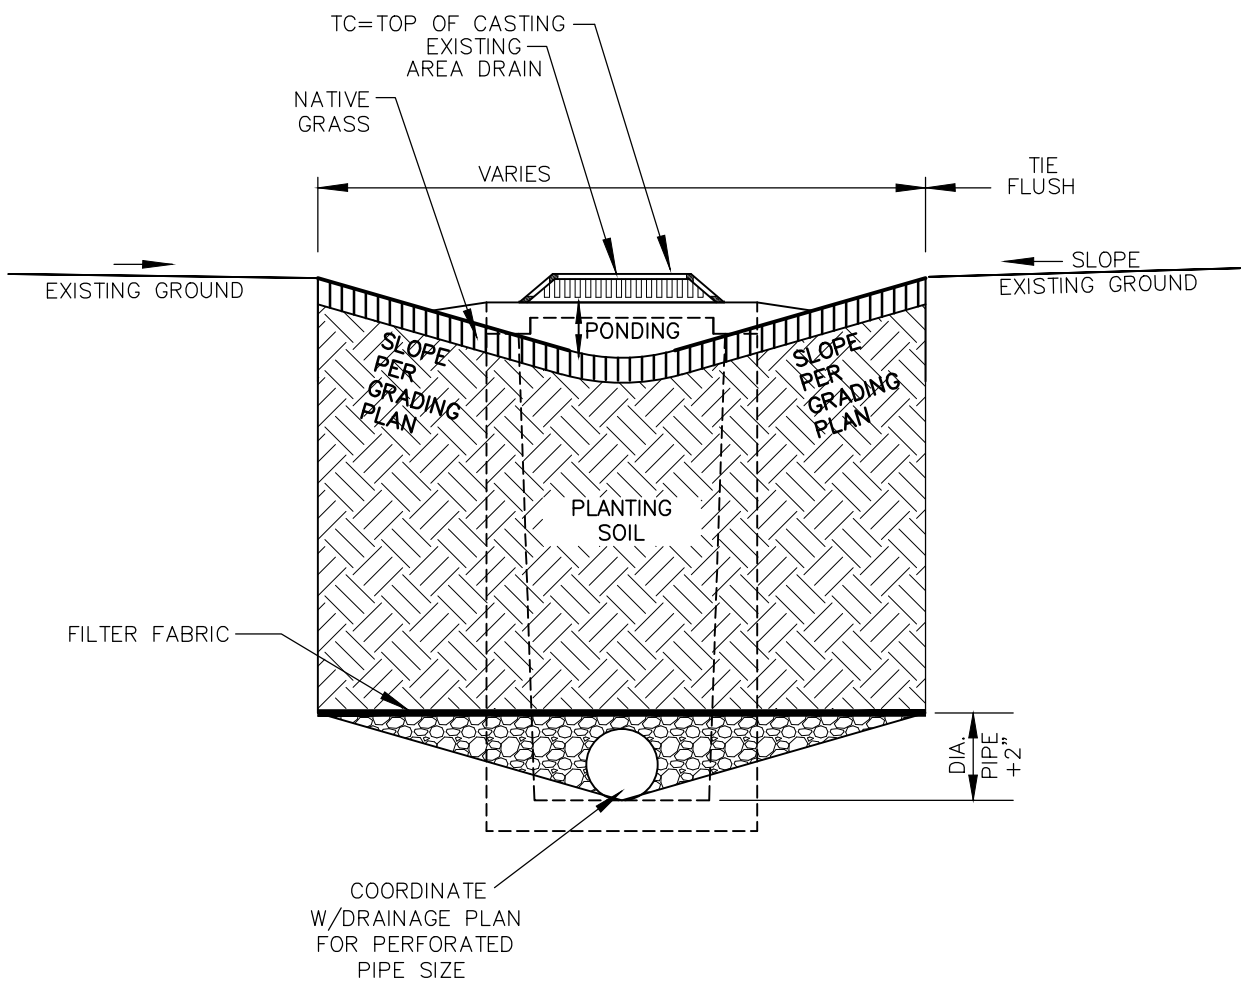

- NOTES:
1. THE PLANTING SOIL BED SHOULD BE SANDY LOAM, LOAMY SAND OR LOAM MIXTURE WITH A CLAY CONTENT RANGING FROM 10 TO 25%. THE SOIL MUST HAVE A PH BETWEEN 5.5 AND 6.5. IN ADDITION, THE PLANTING SOIL SHOULD HAVE A 1.5 TO 3% ORGANIC CONTENT AND A MAXIMUM 500 ppm CONCENTRATION OF SOLUBLE SALTS.
 2. THE UNDERDRAIN COLLECTION SYSTEM IS EQUIPPED WITH A 12" PERFORATED HOPE PIPE (ASHTO M 252) IN A 14" LAYER. THE PIPE SHOULD HAVE 3/8 PERFORATIONS, SPACED AT 6" CENTERS, WITH A MINIMUM OF 4 HOLES PER ROW. THE PIPE IS PLACED ON A MINIMUM GRADE OF 0.5%. A PERMEABLE FILTER FABRIC IS PLACED BETWEEN THE SOIL AND THE GRAVEL.
 3. BIO-RETENTION AREA SHALL BE PLANTED WITH NATIVE GRASSES.

4 BIO-RETENTION AREA


NOT TO SCALE

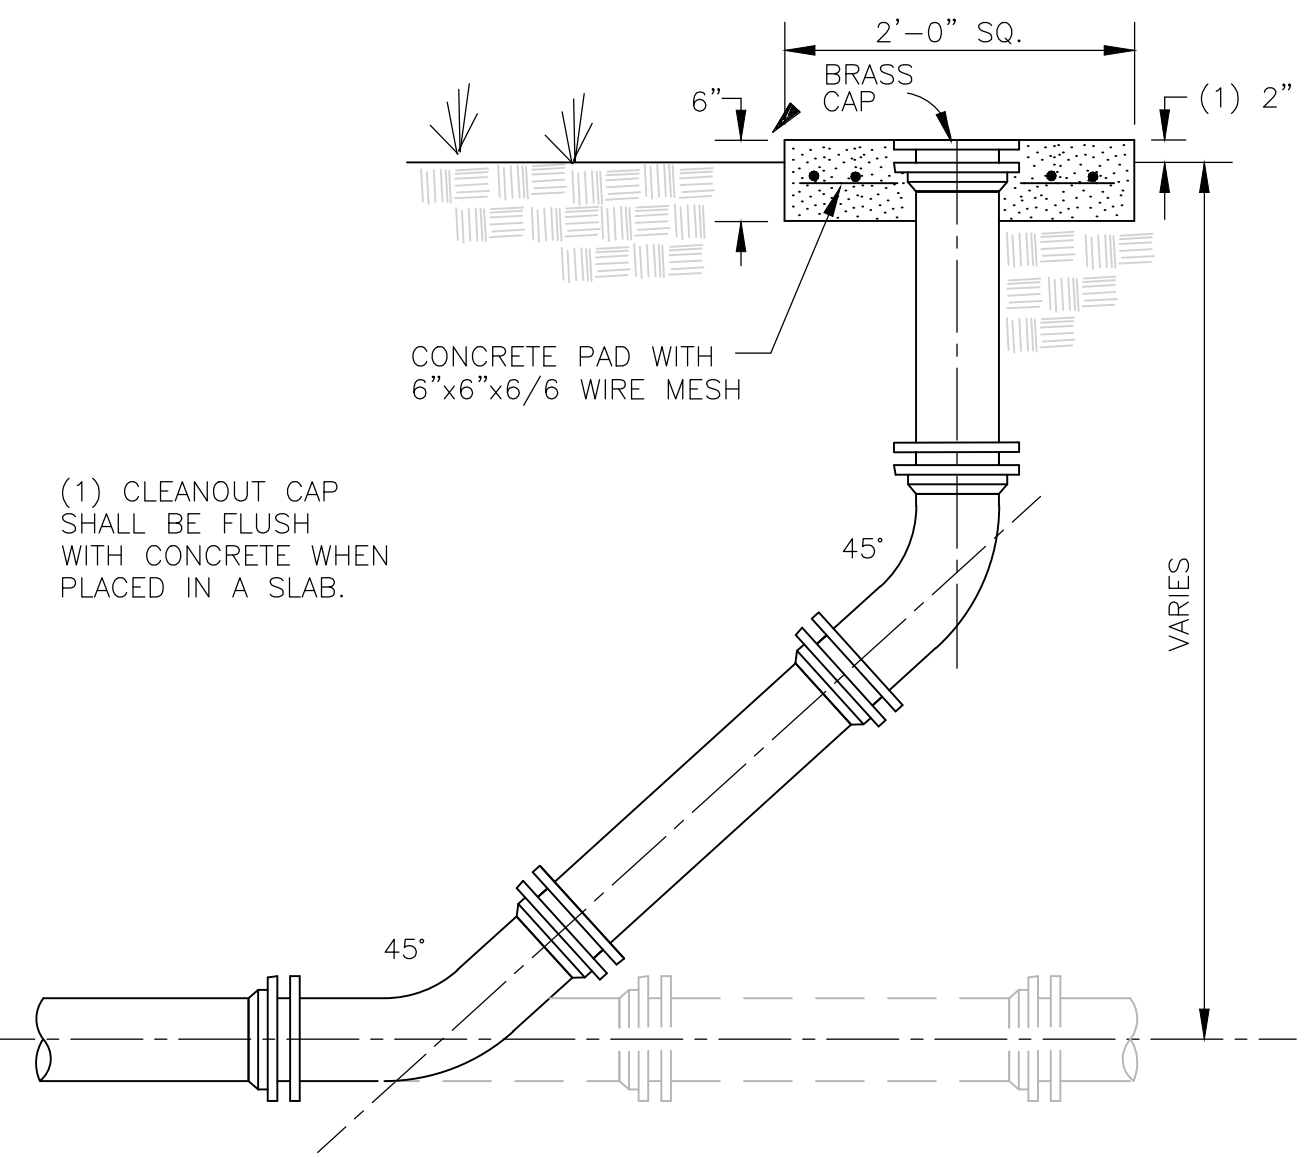

(1) CLEANOUT CAP
SHALL BE FLUSH
WITH CONCRETE WHEN
PLACED IN A SLAB.

5 CLEANOUT

NOT TO SCALE

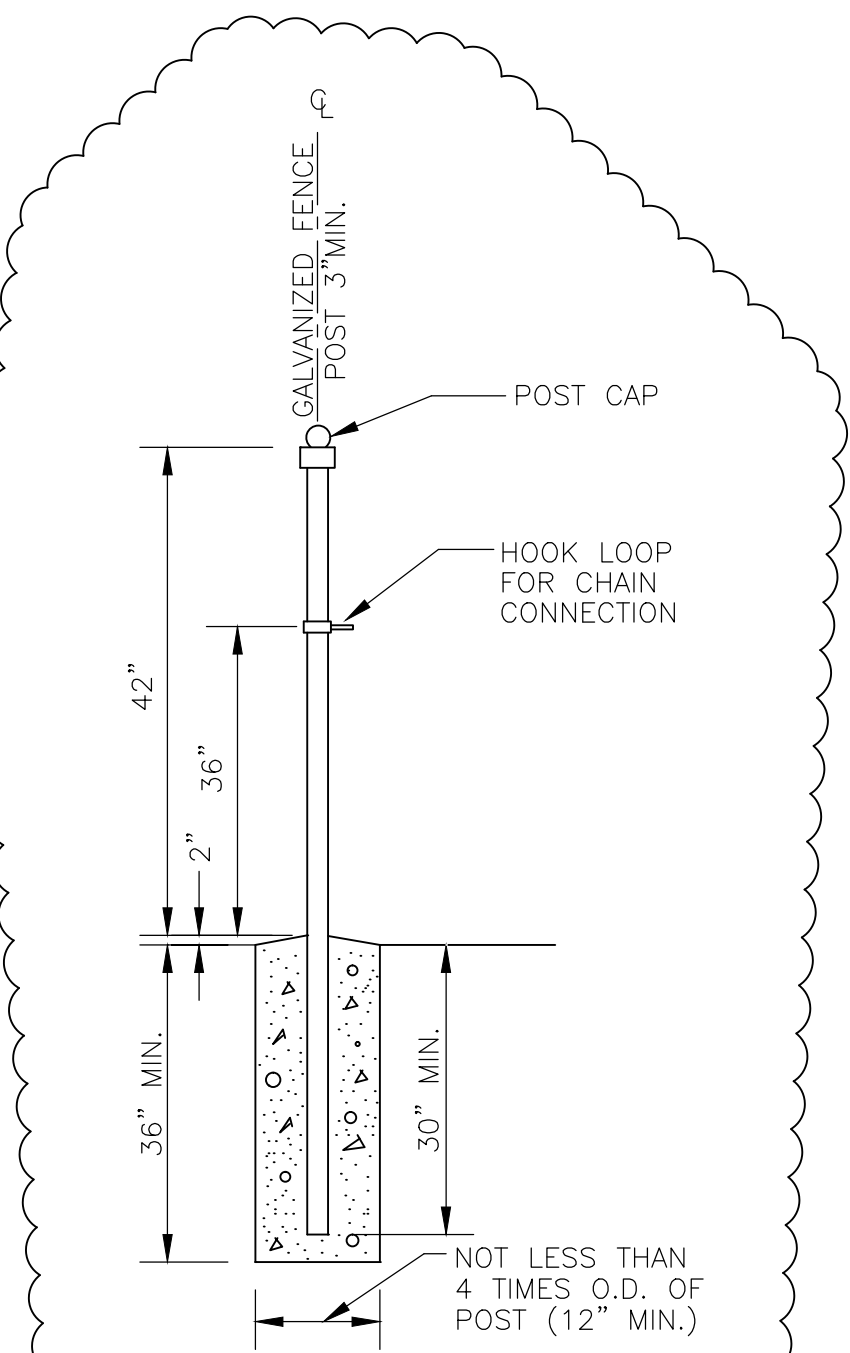

NOTES:

1. PROVIDE ZINC PLATED, LOW CARBON WELDED STEEL CHAIN, 0.18 MINIMUM DIA., WITH LATCHES ON EACH END, ACROSS DRIVEWAY, APPROXIMATELY 6" SAG ALLOWED.

6 FENCE POST

NOT TO SCALE




ARCHITECTURE
ENGINEERING
PLANNING
INTERIORS

HART FREELAND ROBERTS, INC.
7101 Executive Center Drive
Suite 300
Brentwood, TN 37024

615.370.8500 phone
615.370.8530 fax
www.hfrdesign.com web

Nashville, Tennessee
Jackson, Tennessee
Kansas City, Missouri
Louisville, Kentucky

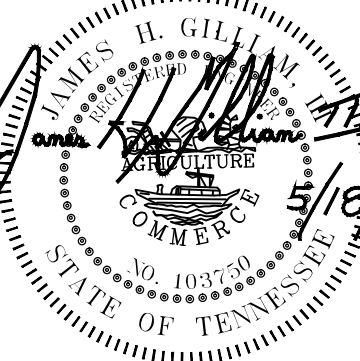

NO.	DATE	REVISION	ADDENDUM #2
1	5/18/12		
2			
3			

HALE STADIUM RENOVATIONS
NORTH AND SOUTH ENTRIES
TENNESSEE STATE UNIVERSITY

JOHN A MERRITT BLVD
NASHVILLE, TN
SBC# 166/001-02-2011

PROJ. NO.: 2011171
DATE: 25 APRIL 2012

SITE
DETAILS


C4.03

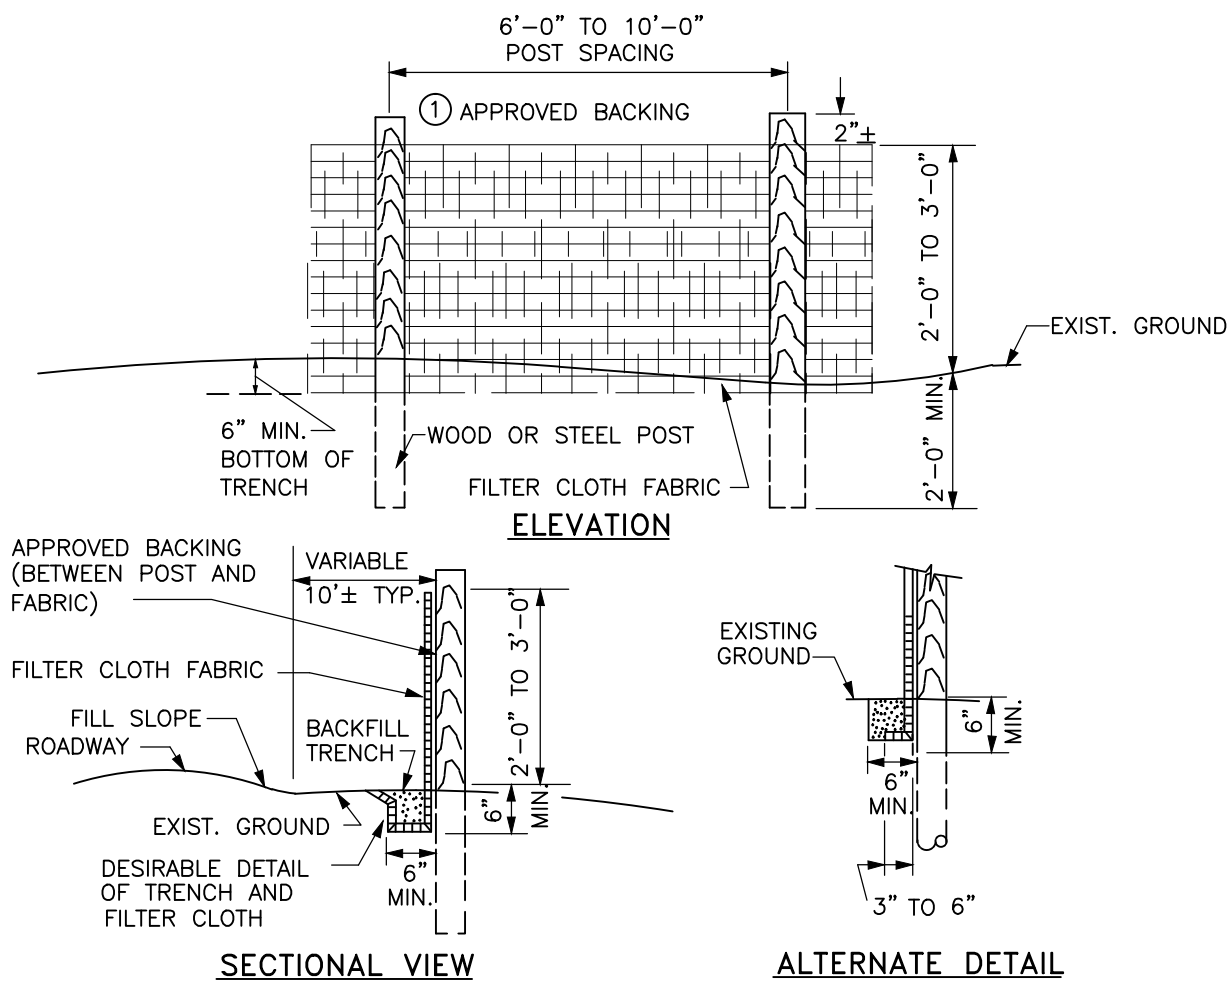

- NOTES:
1. FILTER CLOTH SHALL HAVE APPROVED BACKING OR A BUILT-IN REINFORCED STRUCTURE, AS RECOMMENDED BY THE MANUFACTURER TO SUPPORT THE FILTER CLOTH
 2. FILTER CLOTH SHALL MEET THE REQUIREMENTS OF STATE D.O.T. STANDARD SPECIFICATIONS
 3. A PREASSEMBLED SILT FENCE MEETING THE REQUIREMENTS OF THIS DRAWING IS ACCEPTABLE IN LIEU OF A FIELD CONSTRUCTED SILT FENCE

1 TEMPORARY SILT FENCE


NOT TO SCALE

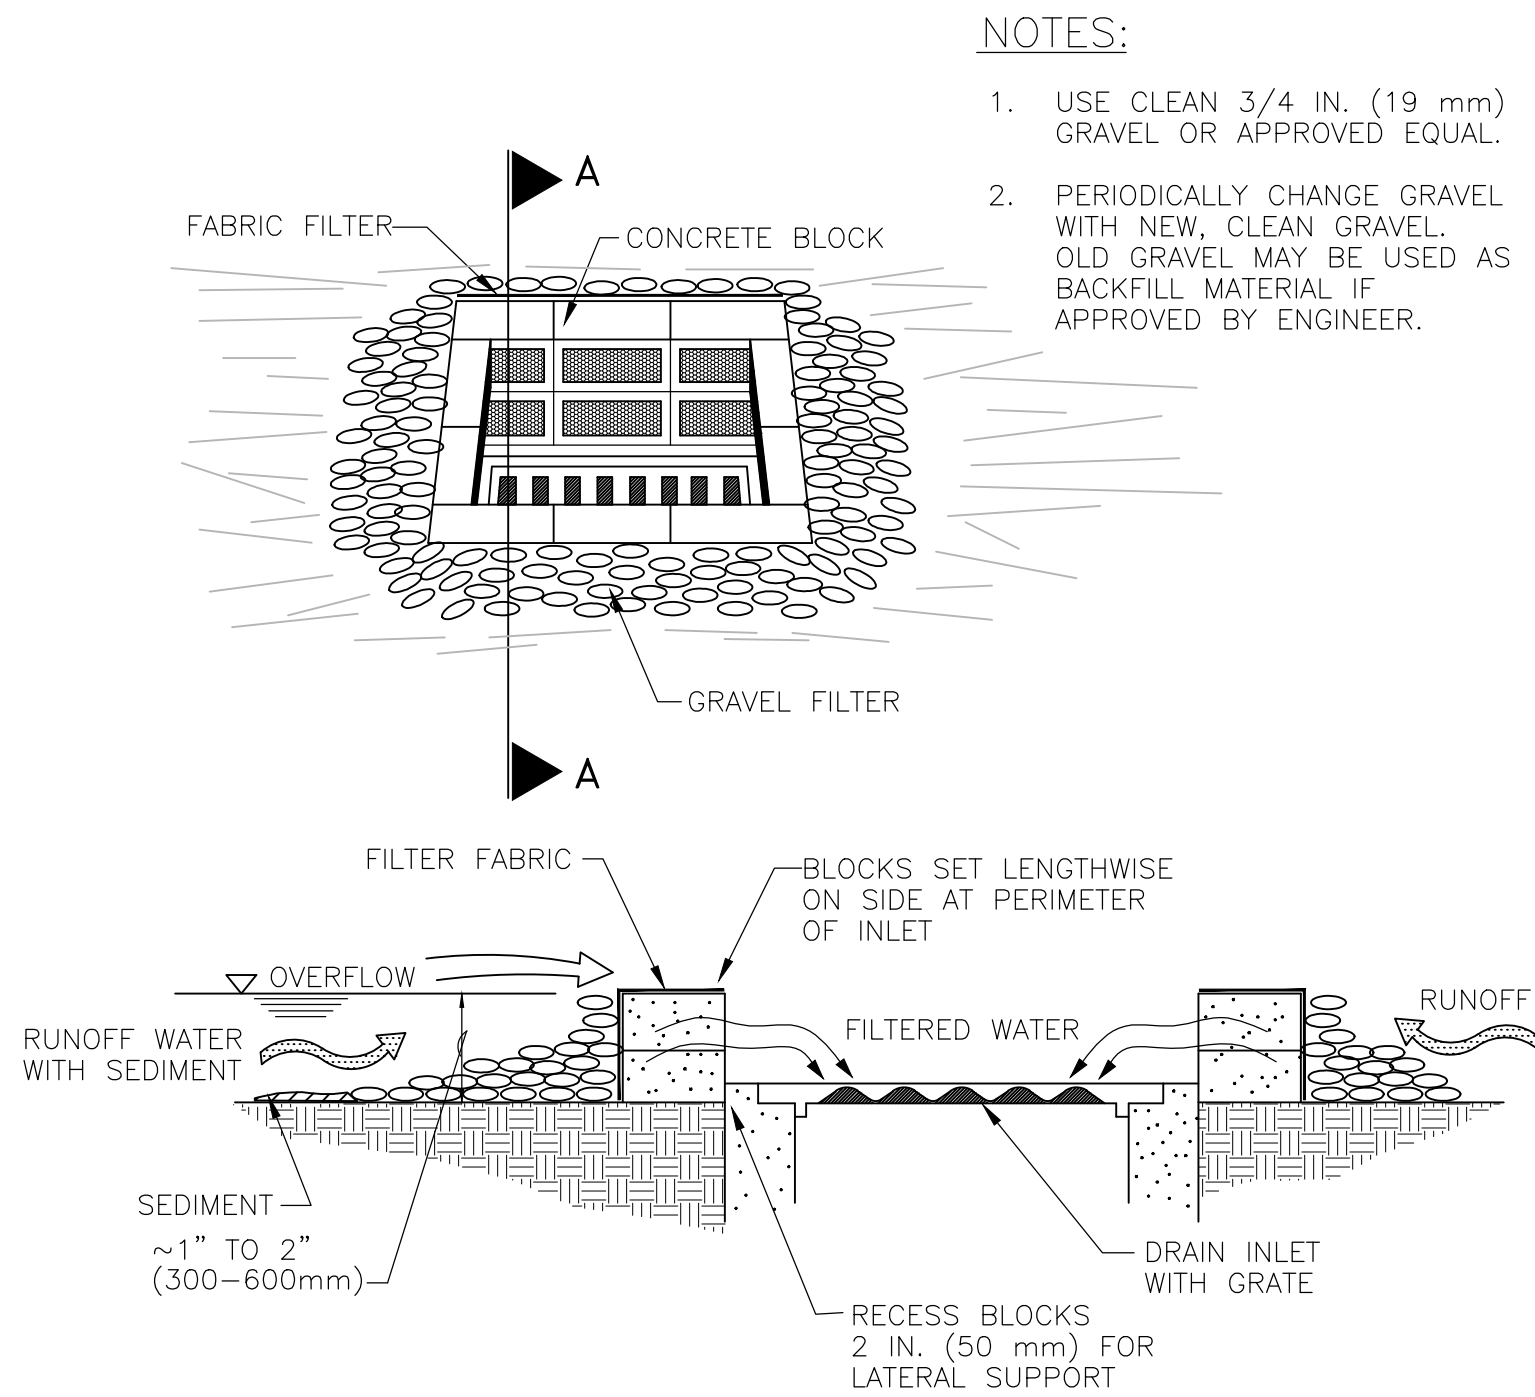

SECTION A-A


2 INLET PROTECTION

NOT TO SCALE

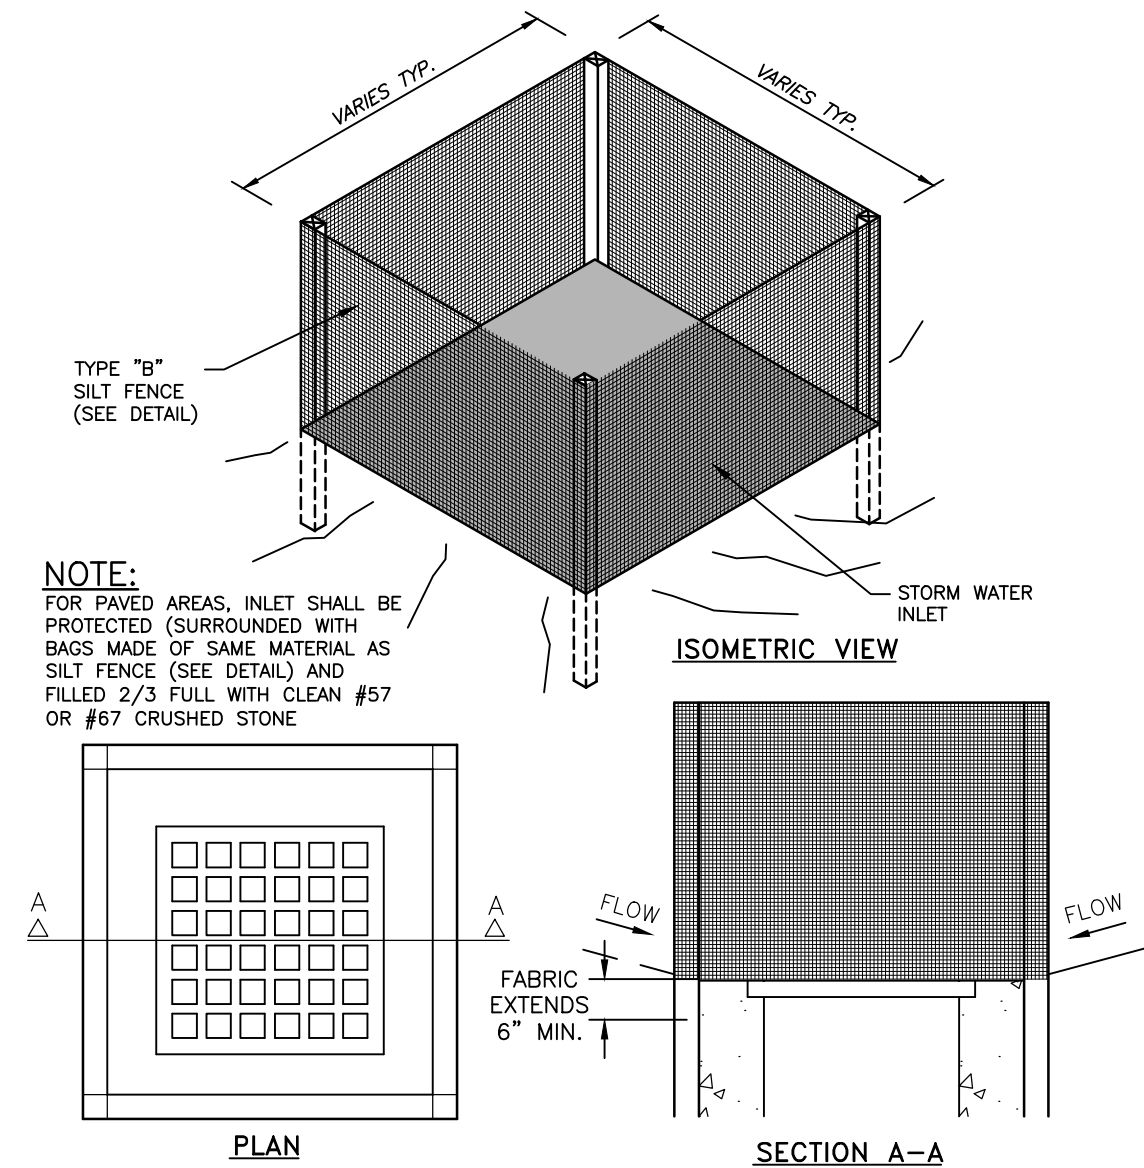


3 INLET PROTECTION

NOT TO SCALE

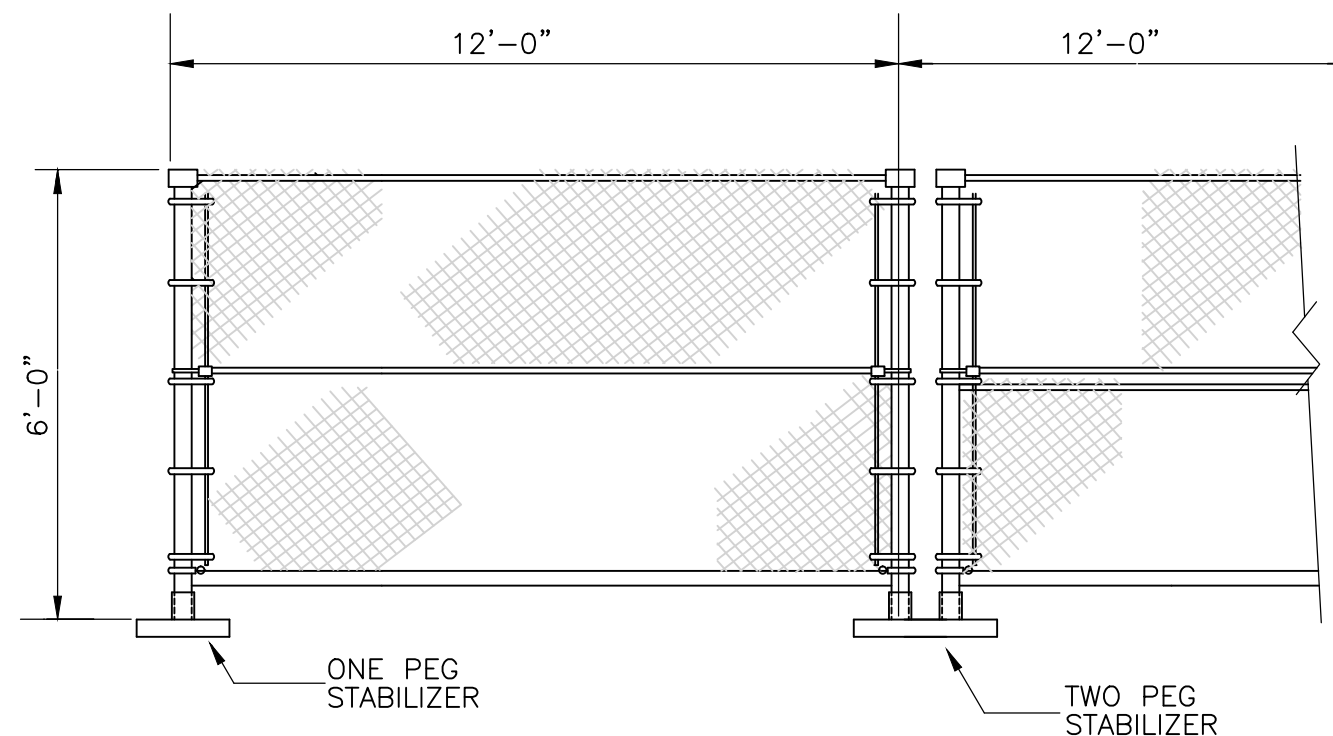


4 CONSTRUCTION FENCE

NOT TO SCALE

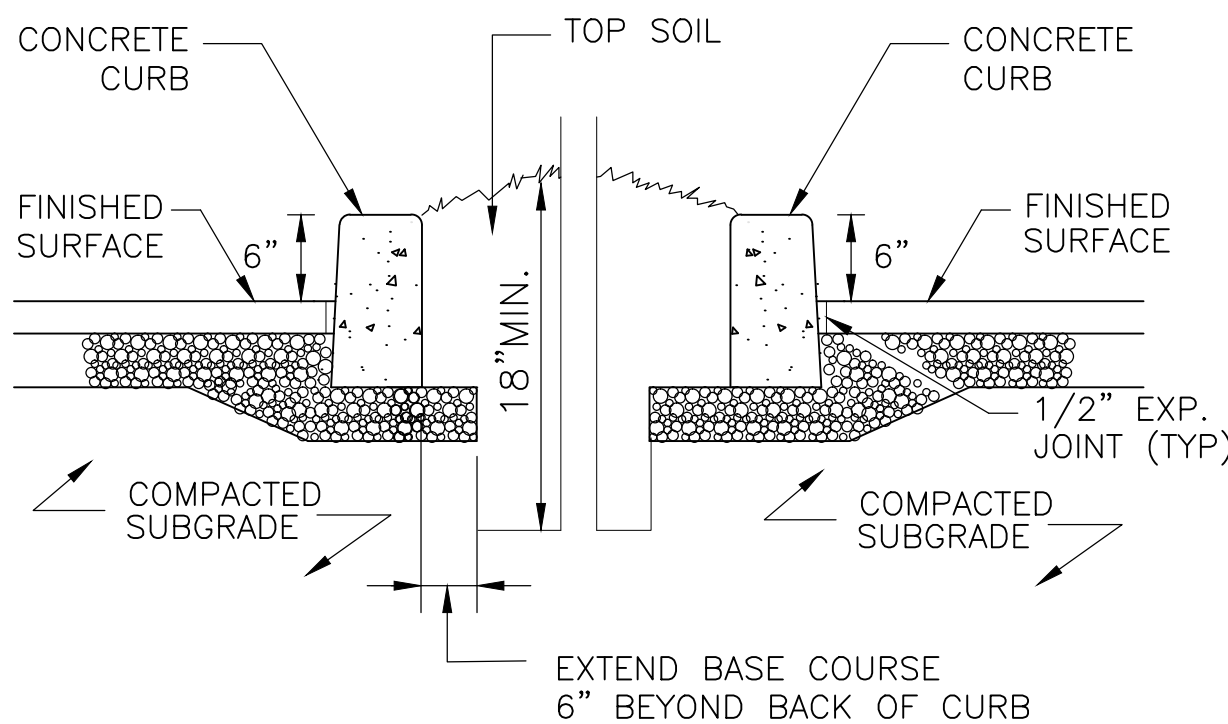

5 LANDSCAPE/PLANTER

NOT TO SCALE

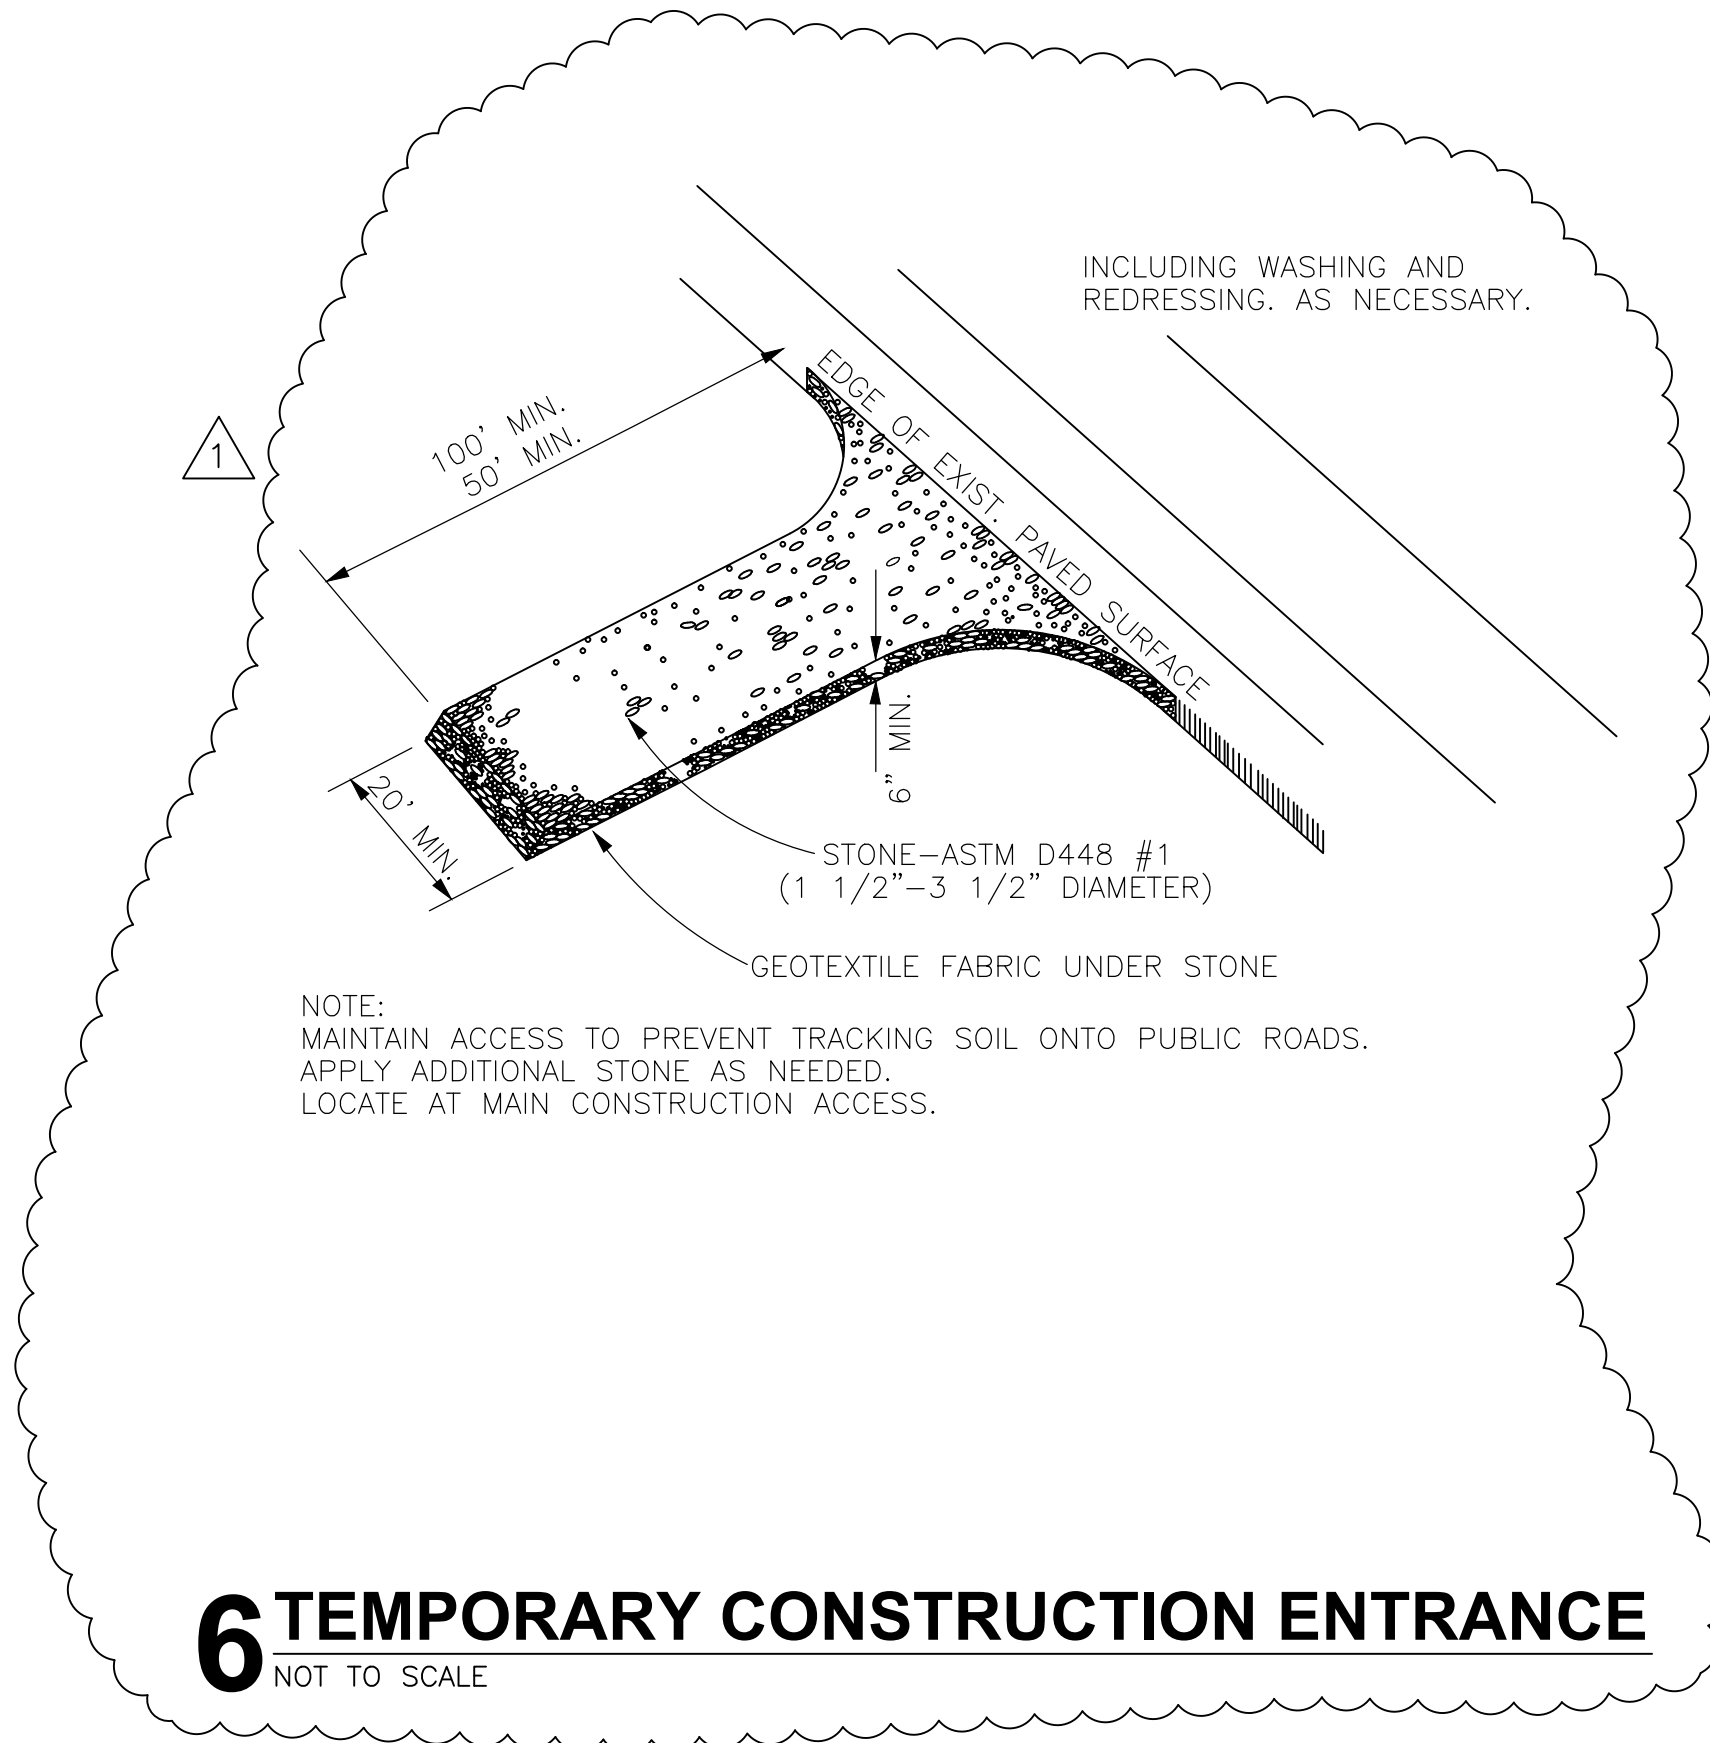

6 TEMPORARY CONSTRUCTION ENTRANCE

NOT TO SCALE




ARCHITECTURE
ENGINEERING
PLANNING
INTERIORS

HART FREELAND ROBERTS, INC.
7101 Executive Center Drive
Suite 300
Brentwood, TN 37024

615.370.8500 phone
615.370.8530 fax
www.hfrdesign.com web

Nashville, Tennessee
Jackson, Tennessee
Kansas City, Missouri
Louisville, Kentucky

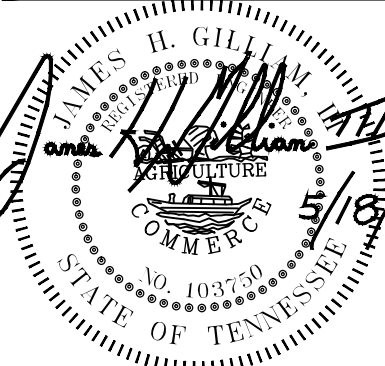

NO.	DATE	REVISION	ADDENDUM #2
1	5/18/12		
2			
3			

HALE STADIUM RENOVATIONS
NORTH AND SOUTH ENTRIES
TENNESSEE STATE UNIVERSITY
JOHN A MERRITT BLVD
NASHVILLE, TN
SBC# 166/001-02-2011

PROJ. NO.: 2011171

DATE: 25 APRIL 2012


SITE
DETAILS

C4.04

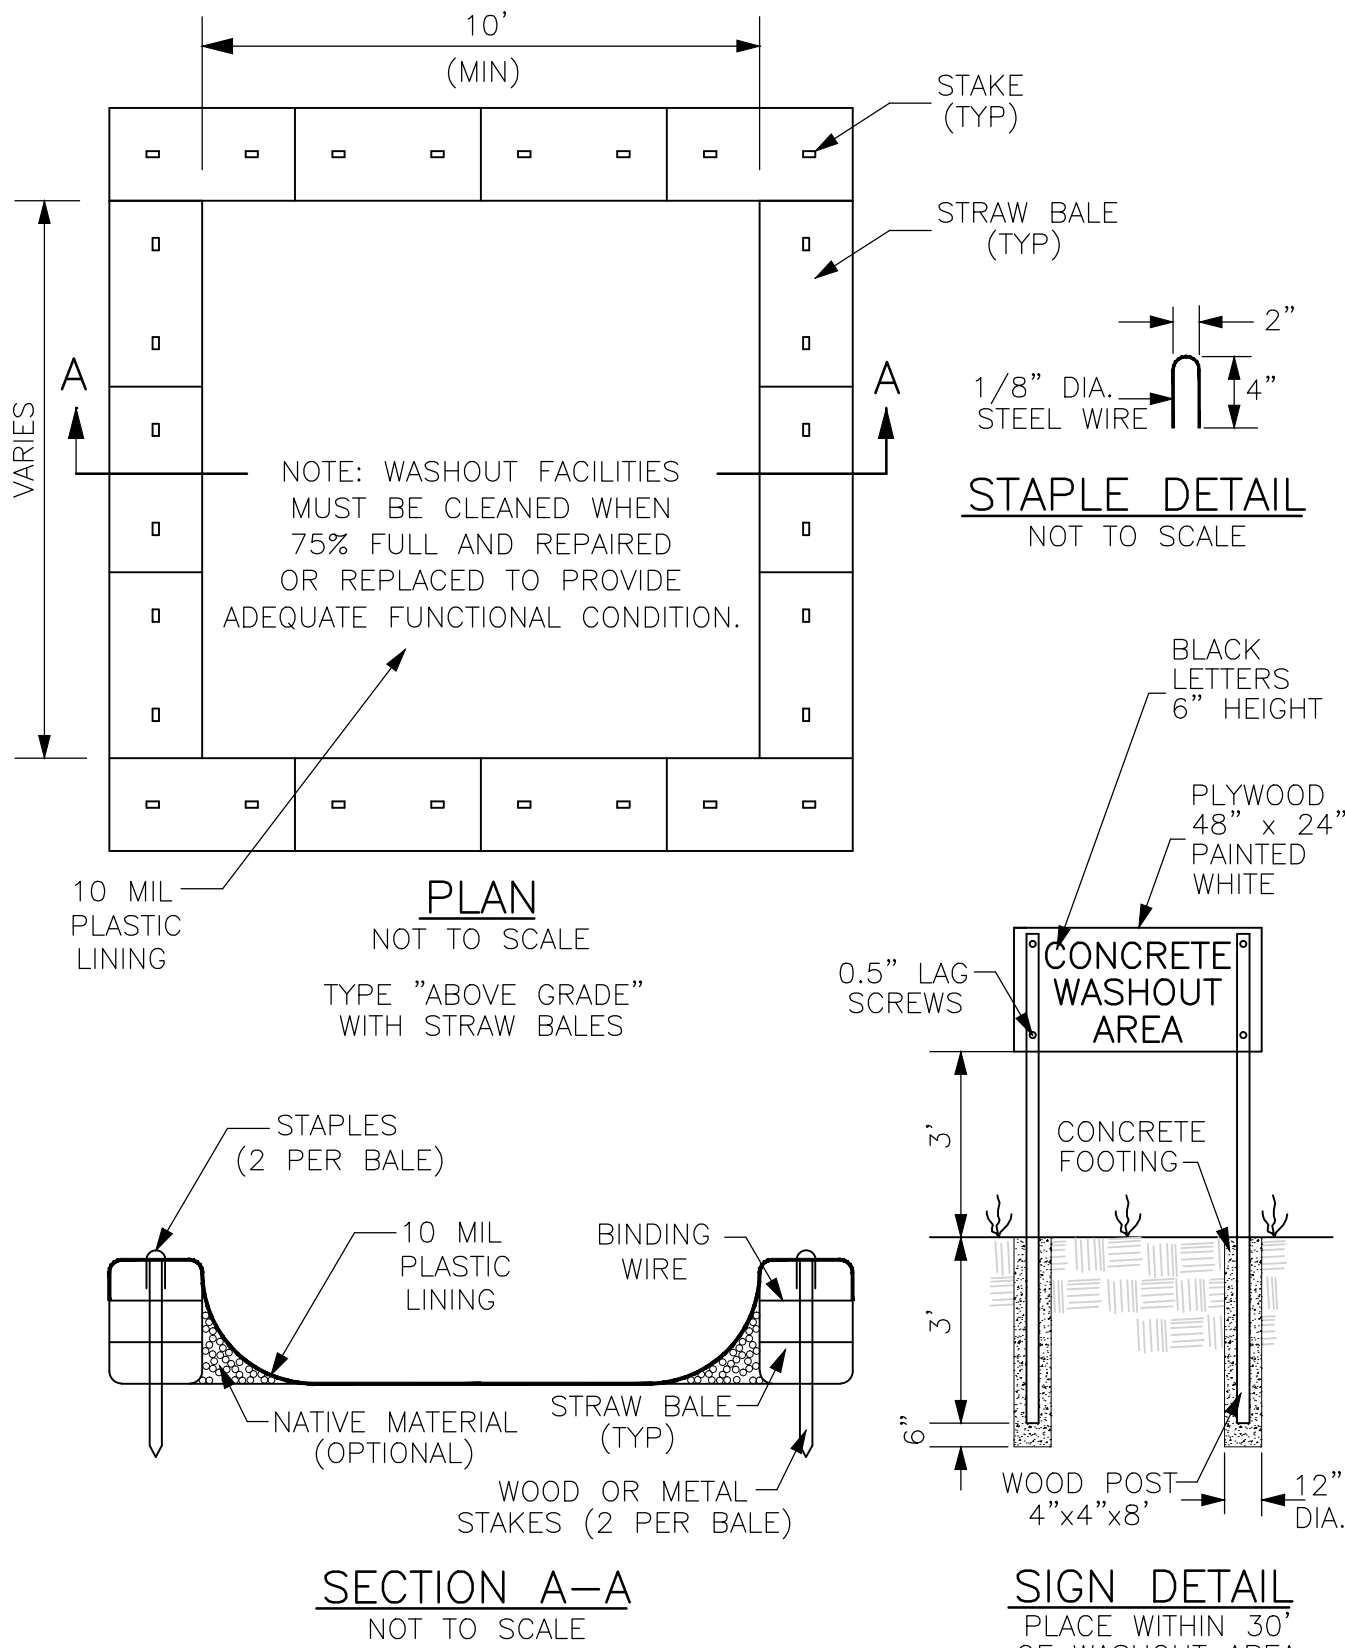

1 CONCRETE WASHOUT

NOT TO SCALE

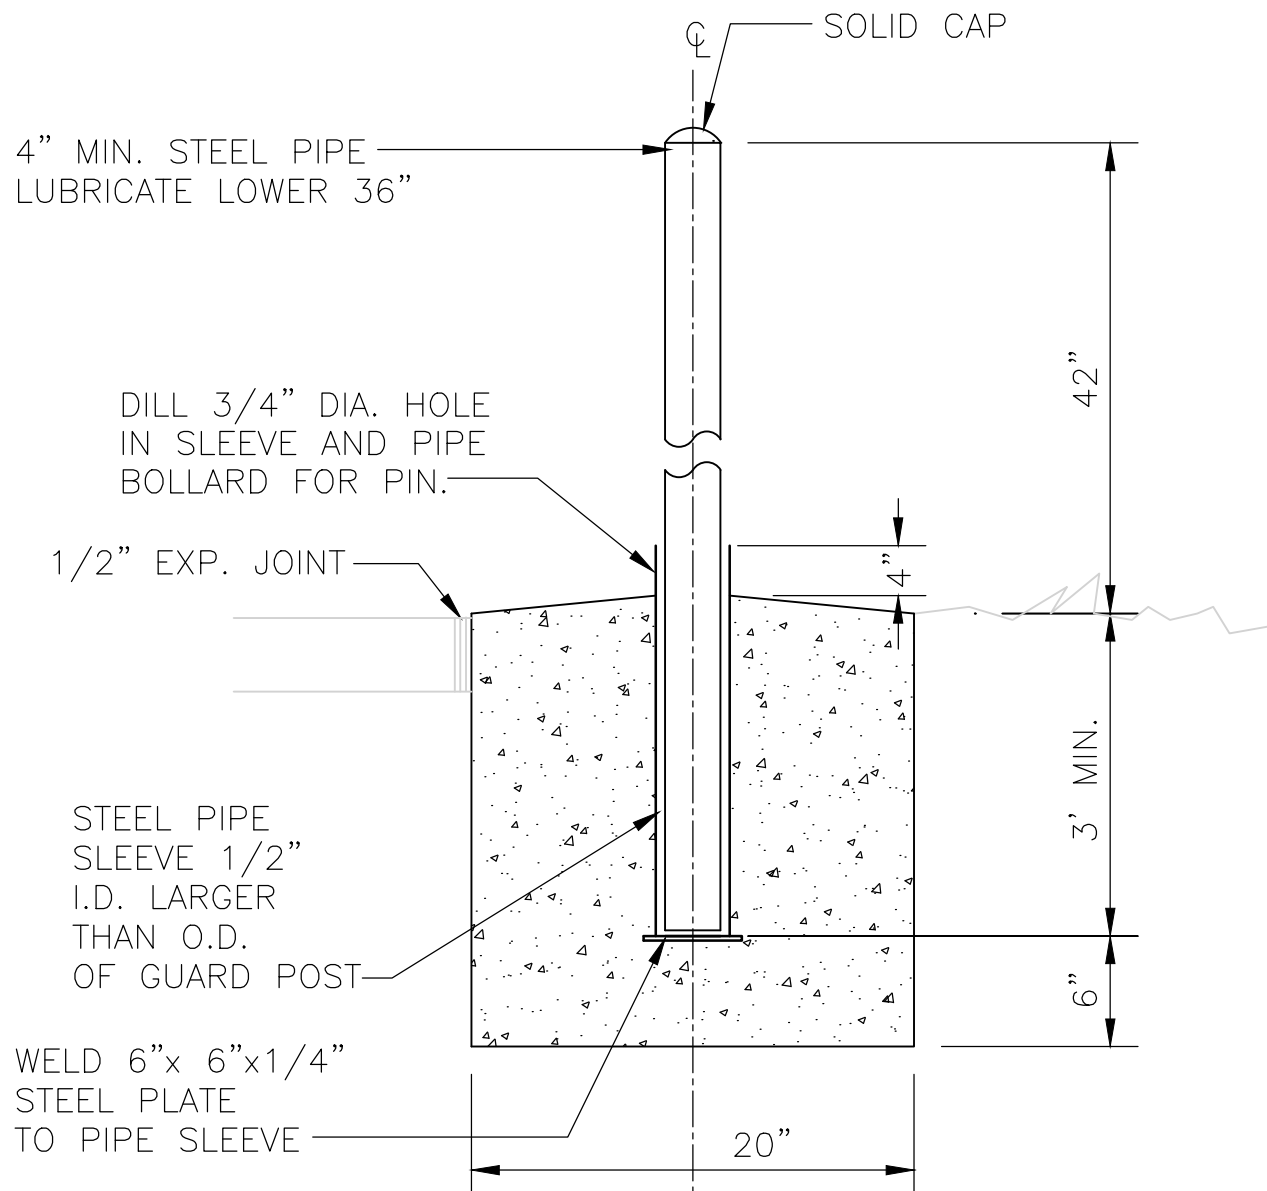

IN CONC. PAVM'T

IN BITUM. PAVM'T. AND GRASS AREAS

NOTE: PROVIDE 9/16" DIA. STEEL PIN WITH FLAT HEAD ON ONE AND 1/4" DIA HOLE ON THE OTHER TO ALLOW FOR LOCKING.

2 REMOVABLE BOLLARD


NOT TO SCALE



- NOTES:
1. REPLICATE EXISTING STONE COLUMN ON EAST SIDE OF SOUTH ENTRANCE.
 2. OWNER TO PROVIDE STONE FOR COLUMN.
 3. APPROXIMATE HEIGHT OF STONE COLUMN TO BE 4'-0", COLUMN SHALL BE 6" ABOVE EXISTING STONE WALL.
 4. SEE SHEET A1.03 DETAIL 1 FOR FOOTING DETAIL.

3 STONE COLUMN

NOT TO SCALE

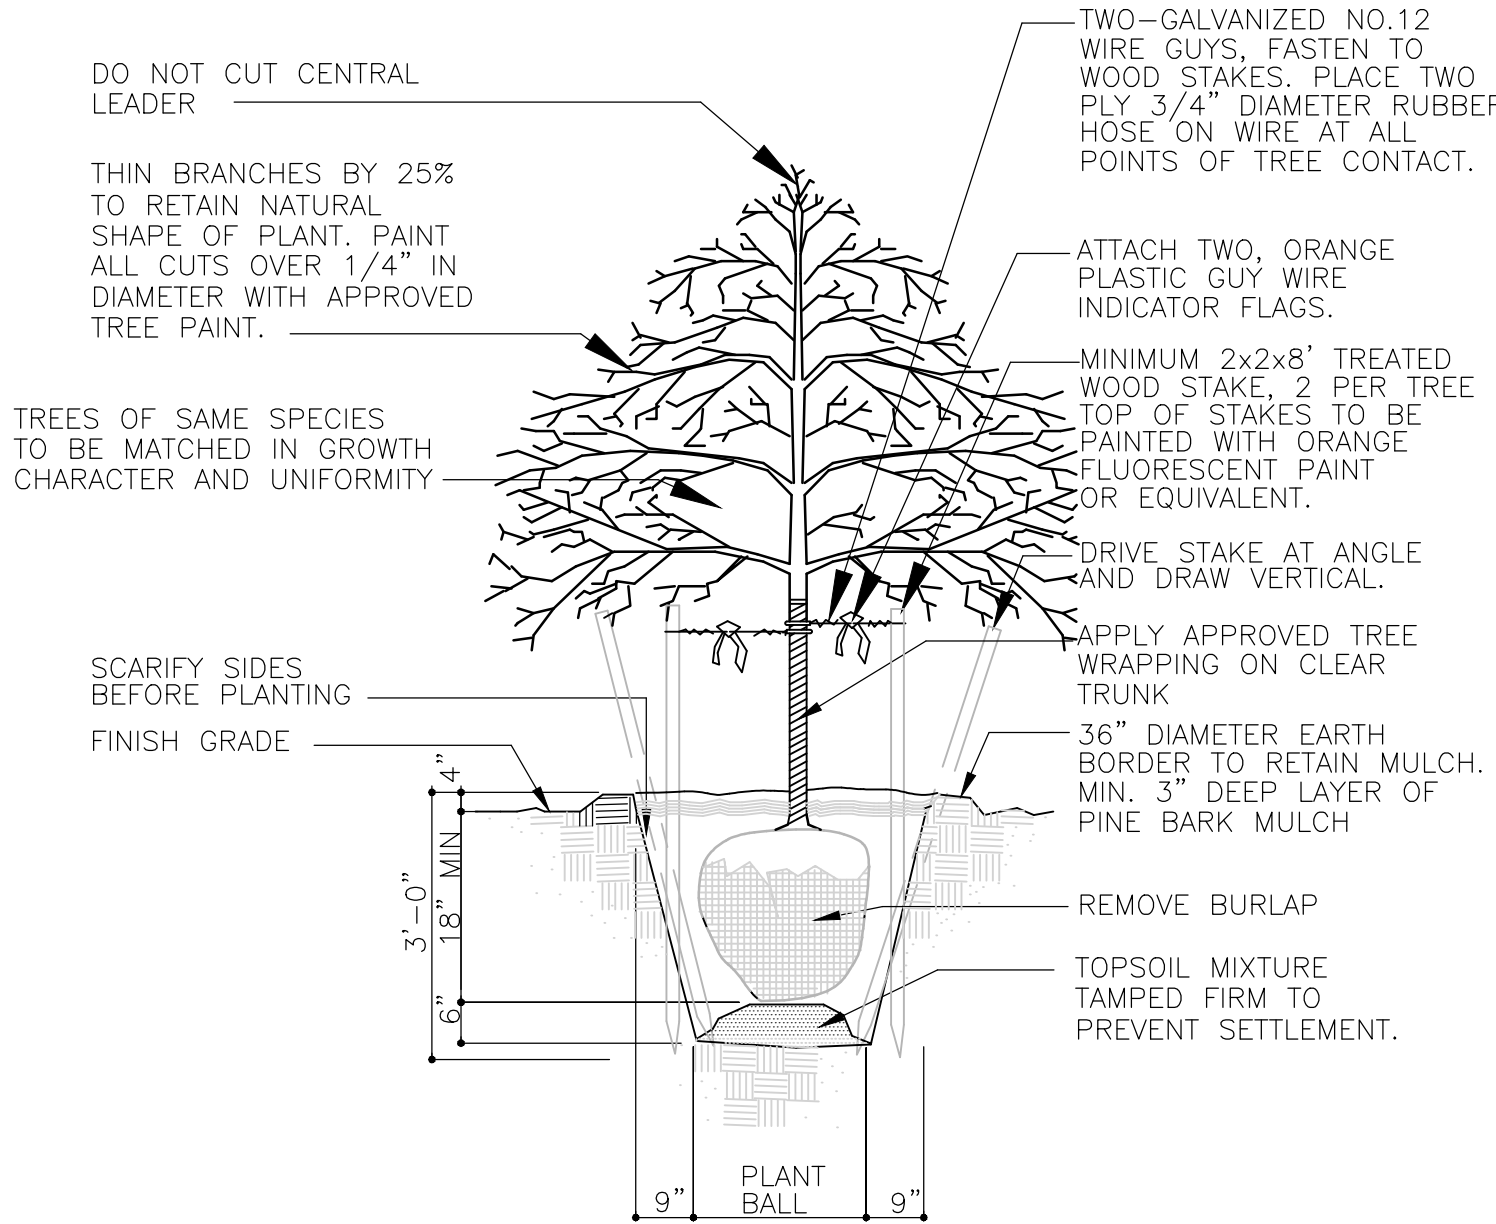

4 TREE PLANTING DETAIL

NOT TO SCALE

5 DETAIL

NOT TO SCALE

6 DETAIL

NOT TO SCALE




ARCHITECTURE
ENGINEERING
PLANNING
INTERIORS

HART FREELAND ROBERTS, INC.
7101 Executive Center Drive
Suite 300
Brentwood, TN 37024

615.370.8500 phone
615.370.8530 fax
www.hfrdesign.com web

Nashville, Tennessee
Jackson, Tennessee
Kansas City, Missouri
Louisville, Kentucky

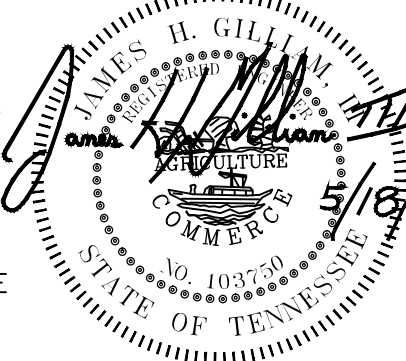

NO.	DATE	REVISION	ADDENDUM #2
1	5/18/12		
2			
3			

HALE STADIUM RENOVATIONS
NORTH AND SOUTH ENTRIES
TENNESSEE STATE UNIVERSITY
JOHN A MERRITT BLVD
NASHVILLE, TN
SBC# 166/001-02-2011

PROJ. NO.: 2011171

DATE: 25 APRIL 2012


SITE
DETAILS

C4.05

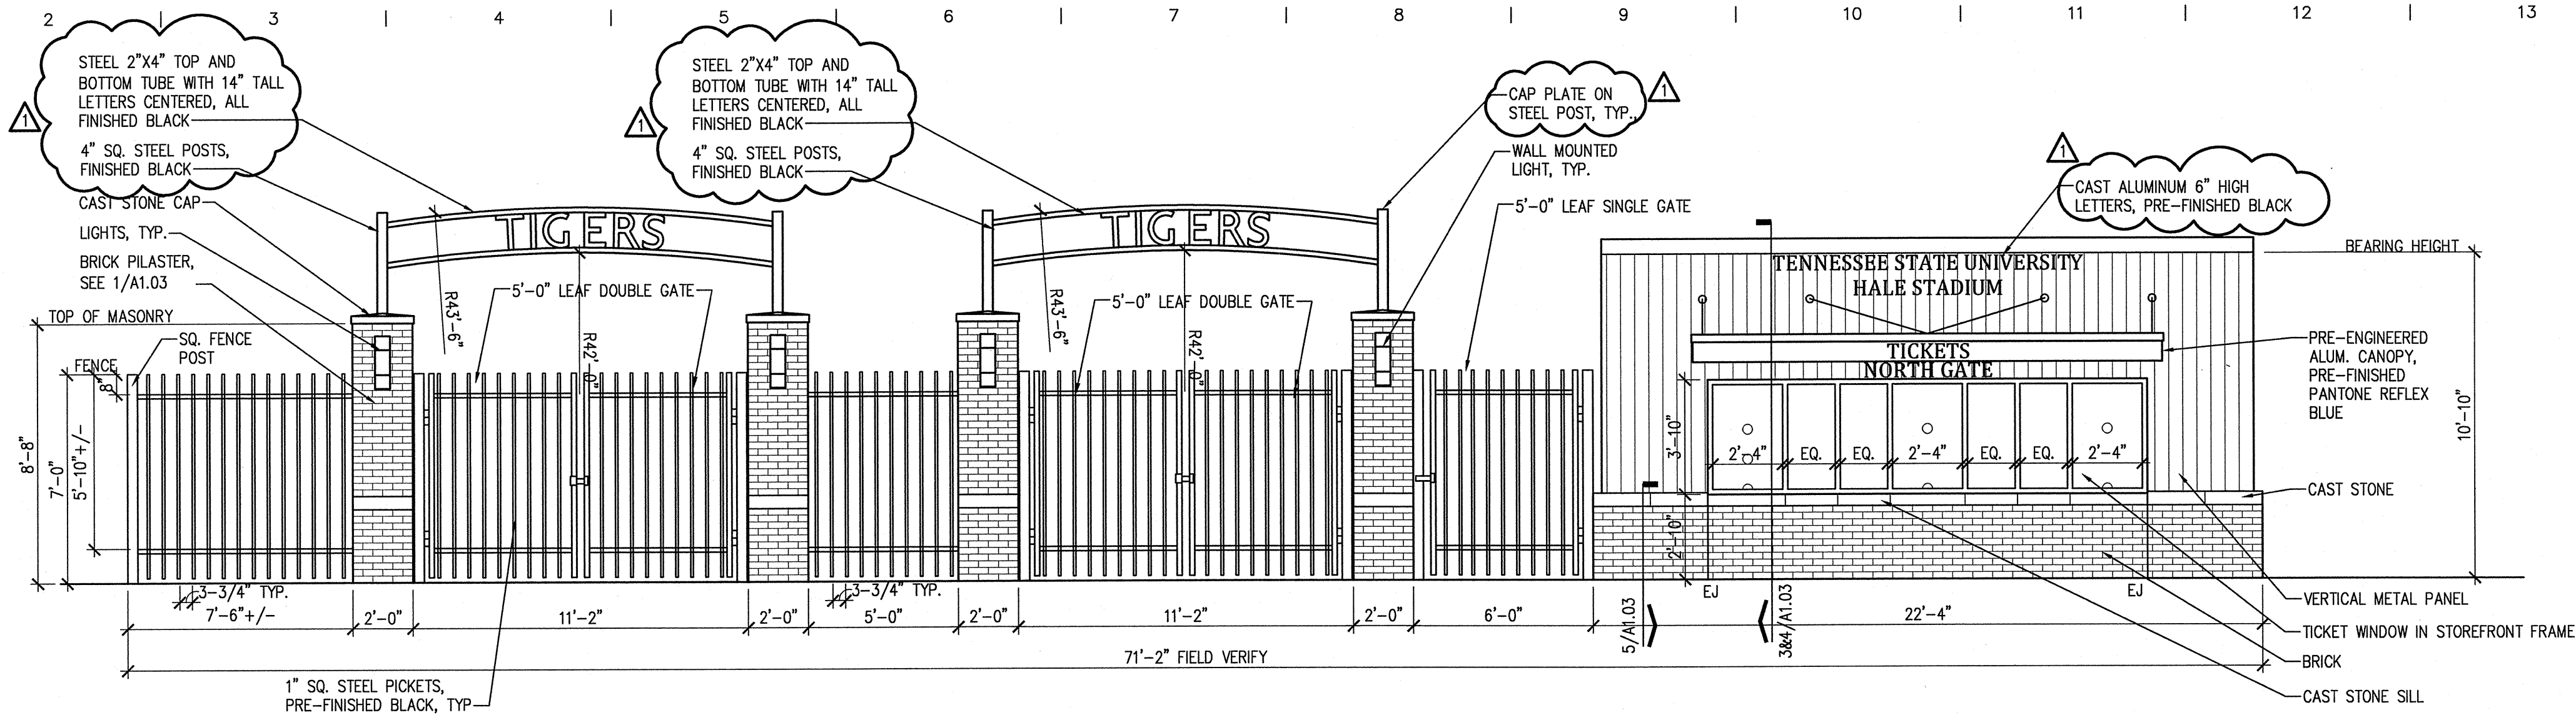


1 NORTH GATE NORTH ELEVATION

1/4" = 1'-0"

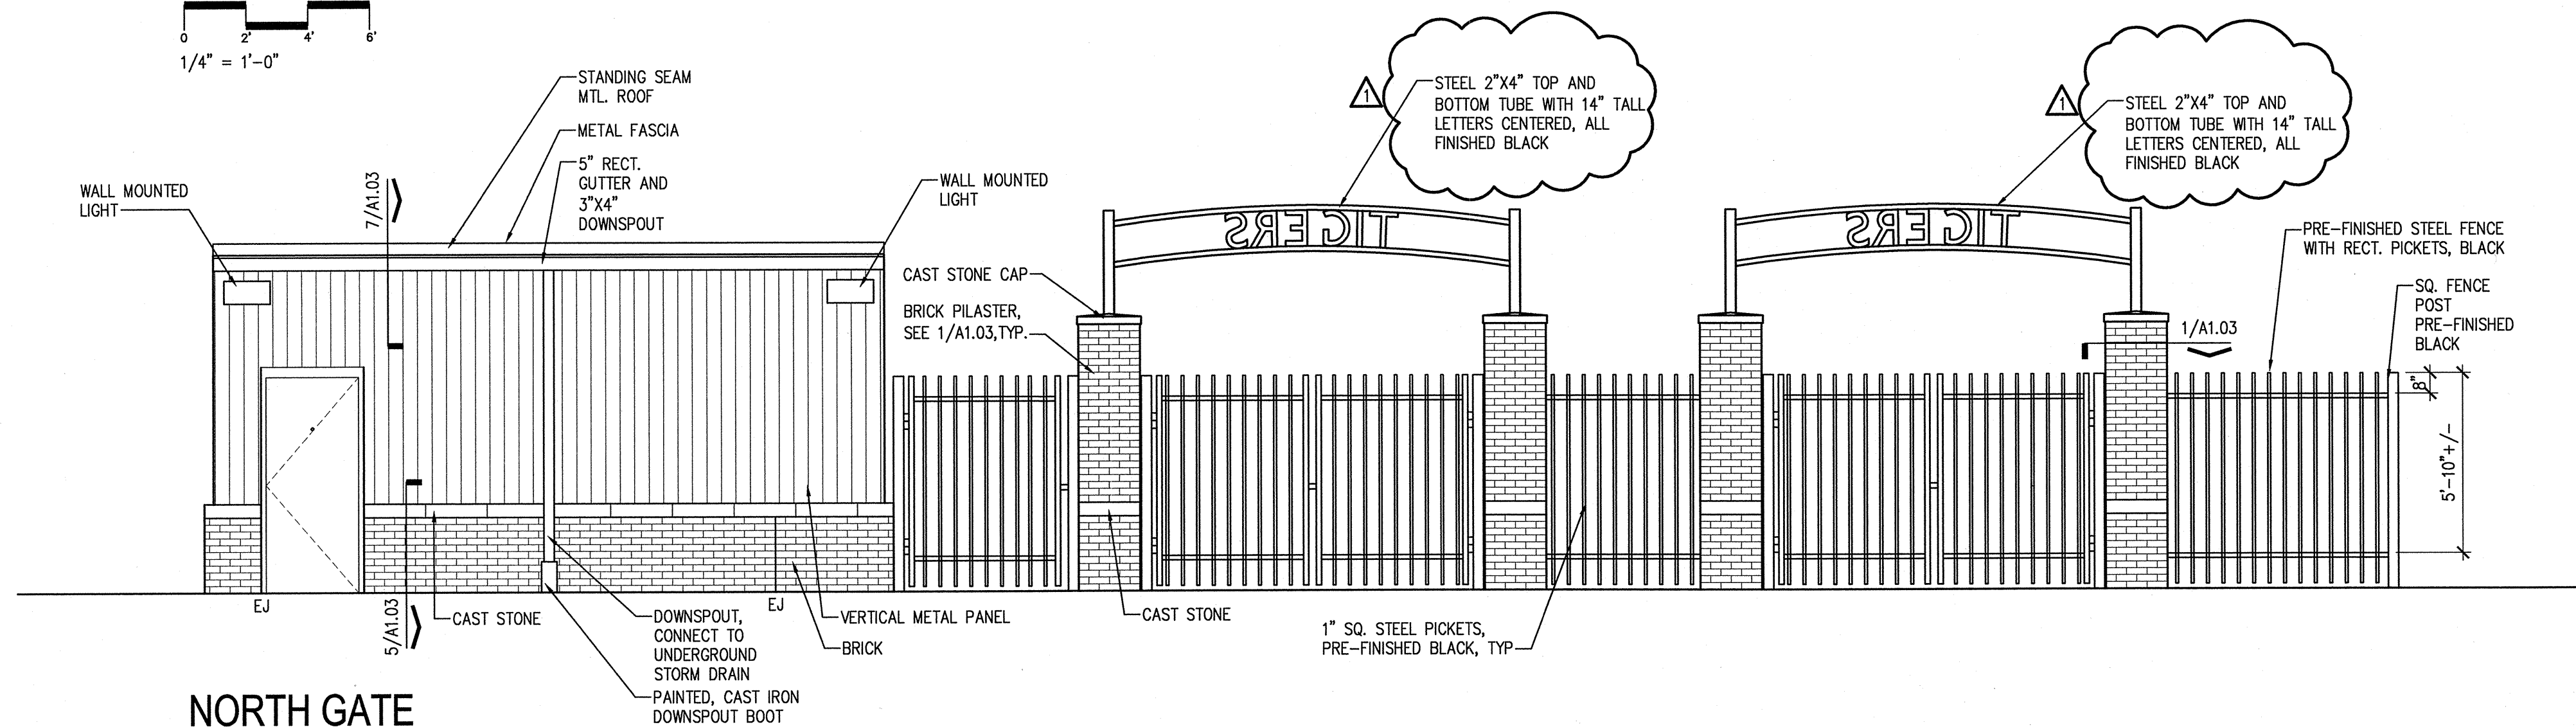


2 NORTH GATE SOUTH ELEVATION

1/4" = 1'-0"

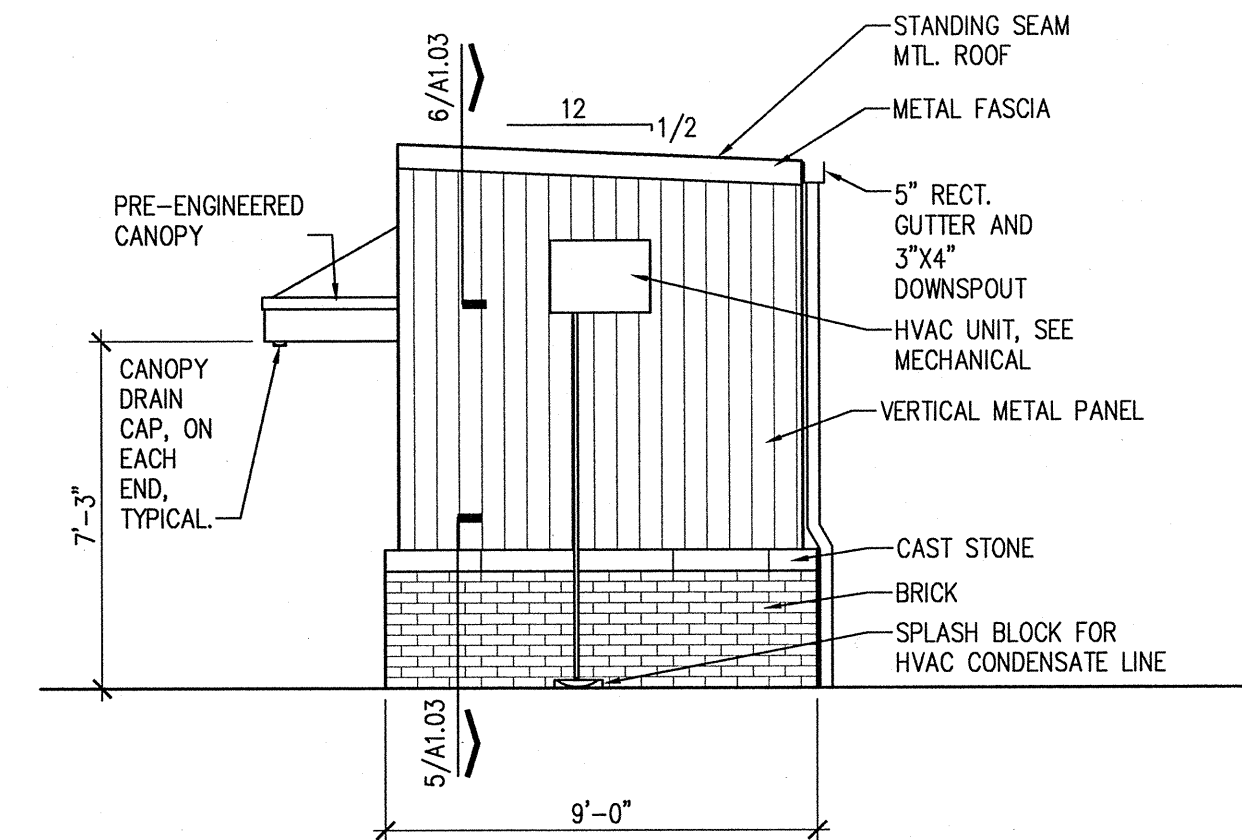

3 NORTH GATE WEST ELEVATION

1/4" = 1'-0"

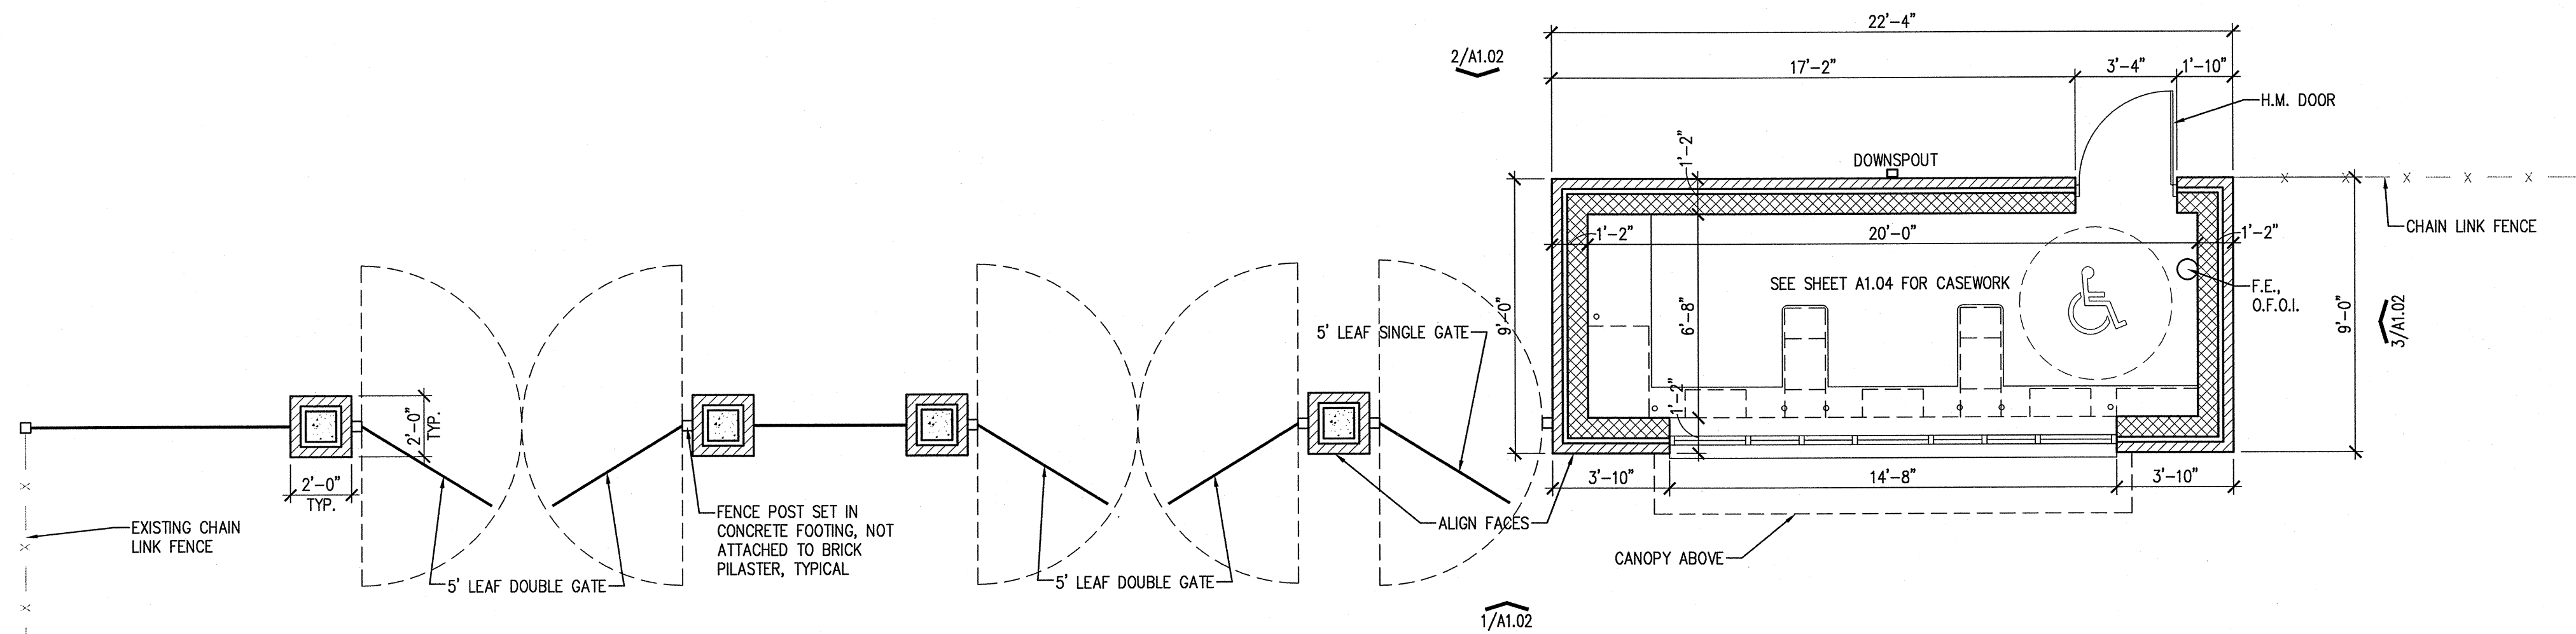


4 NORTH GATE FLOOR PLAN

1/4" = 1'-0"



ARCHITECTURE
ENGINEERING
PLANNING
INTERIORS

HART FREELAND ROBERTS, INC.
7101 Executive Center Drive
Suite 300
Brentwood, TN 37024
615.370.8500 phone
615.370.8530 fax
www.hfrdesign.com web
Nashville, Tennessee
Jackson, Tennessee
Kansas City, Missouri
Louisville, Kentucky

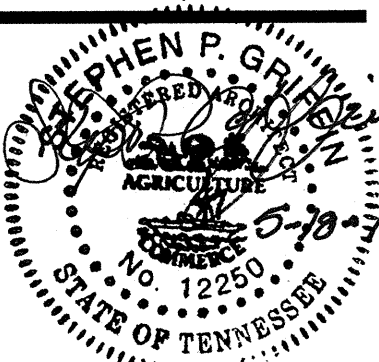

NO.	DATE	DESCRIPTION	ADDENDUM #2
1	5/18/12		




HALE STADIUM RENOVATIONS
NORTH AND SOUTH ENTRIES
TENNESSEE STATE UNIVERSITY
JOHN A MERRITT BLVD
NASHVILLE, TN
SBCH# 166/001-02-2011

PROJ. NO.: 2011171
DATE: 25 APRIL 2012

NORTH
PLAZA
GATE

A
1.02

PLOT DATE: 1/23/2012 3:00:47 PM (BALLOON)
COPYRIGHT 2012 - ALL RIGHTS RESERVED. NO PORTIONS OF THIS DOCUMENT MAY BE REPRODUCED WITHOUT THE EXPRESSED WRITTEN CONSENT OF HART FREELAND ROBERTS, INC.

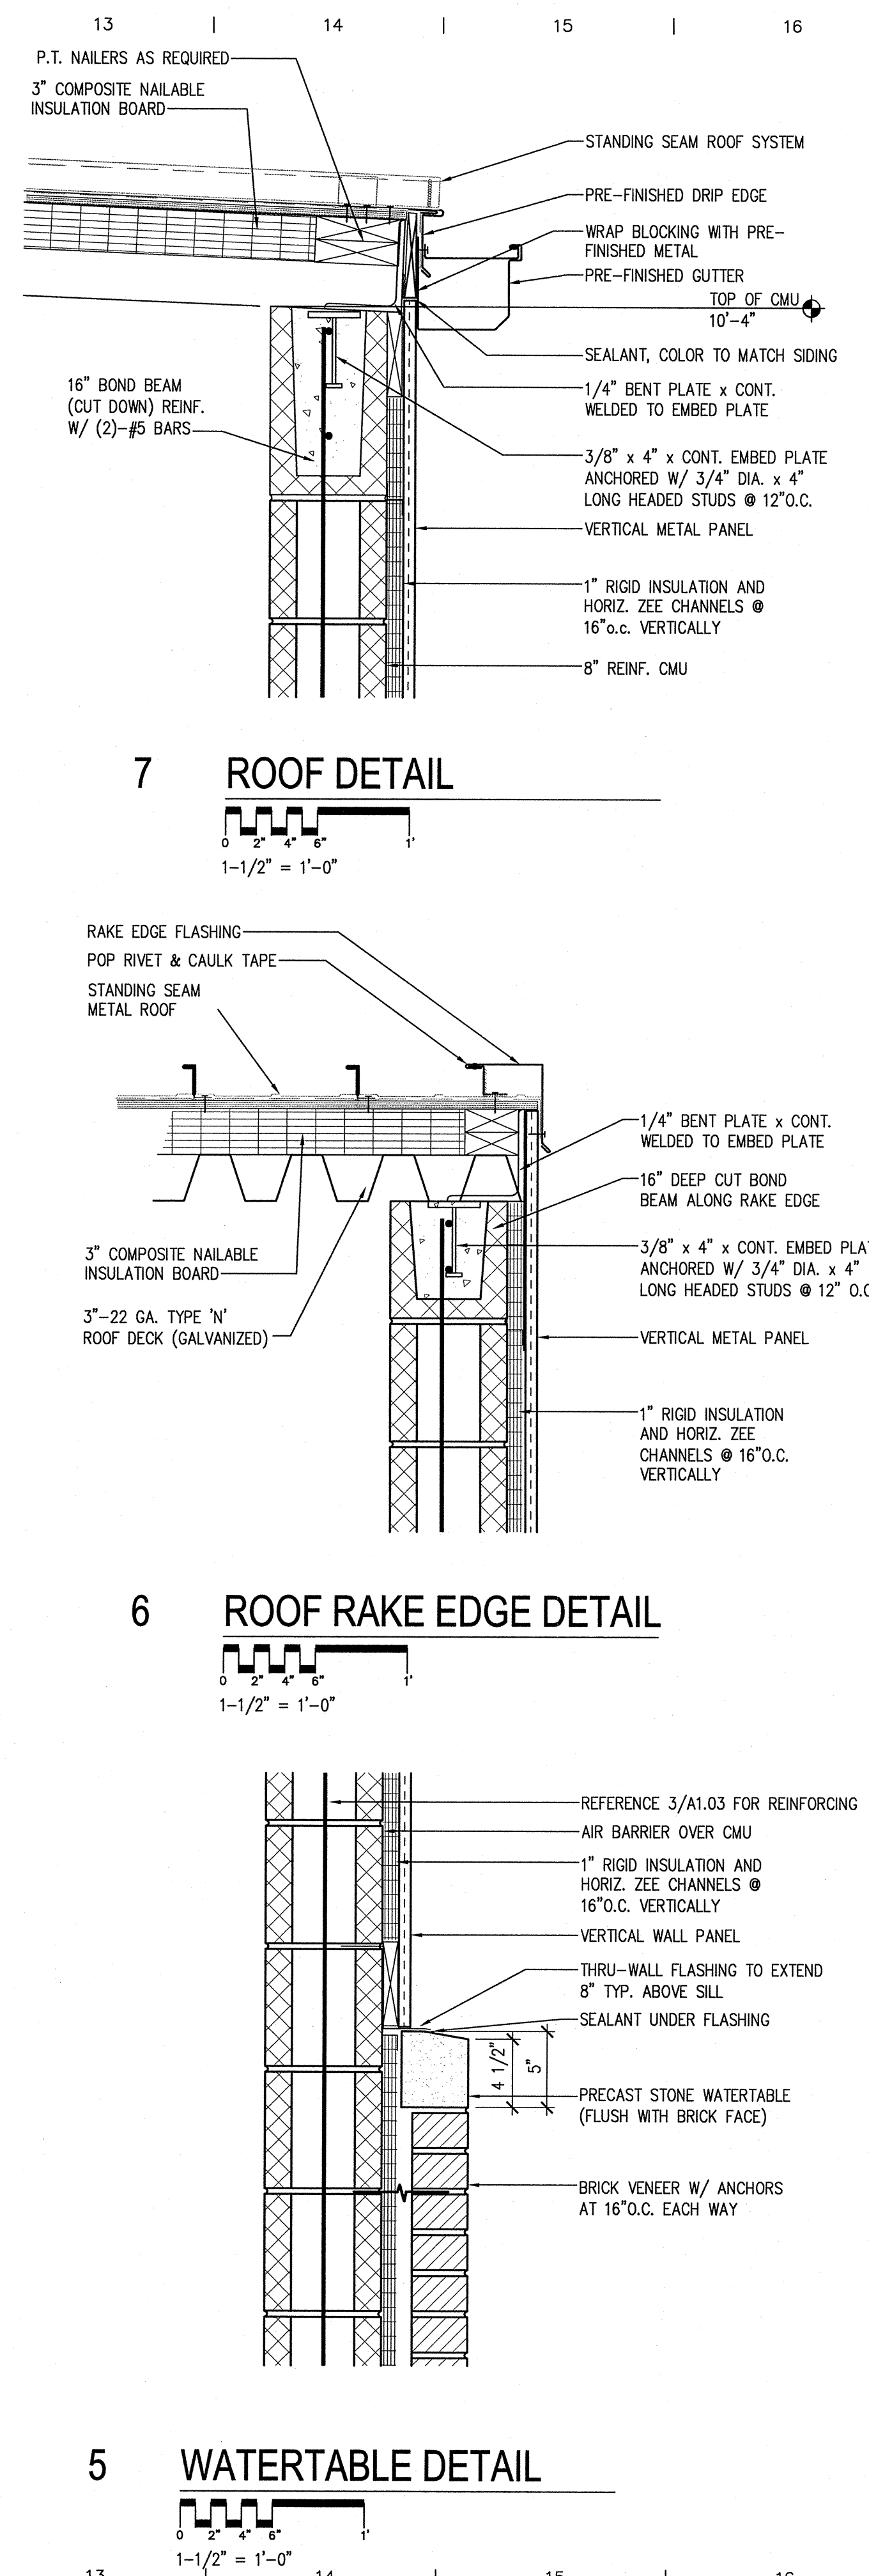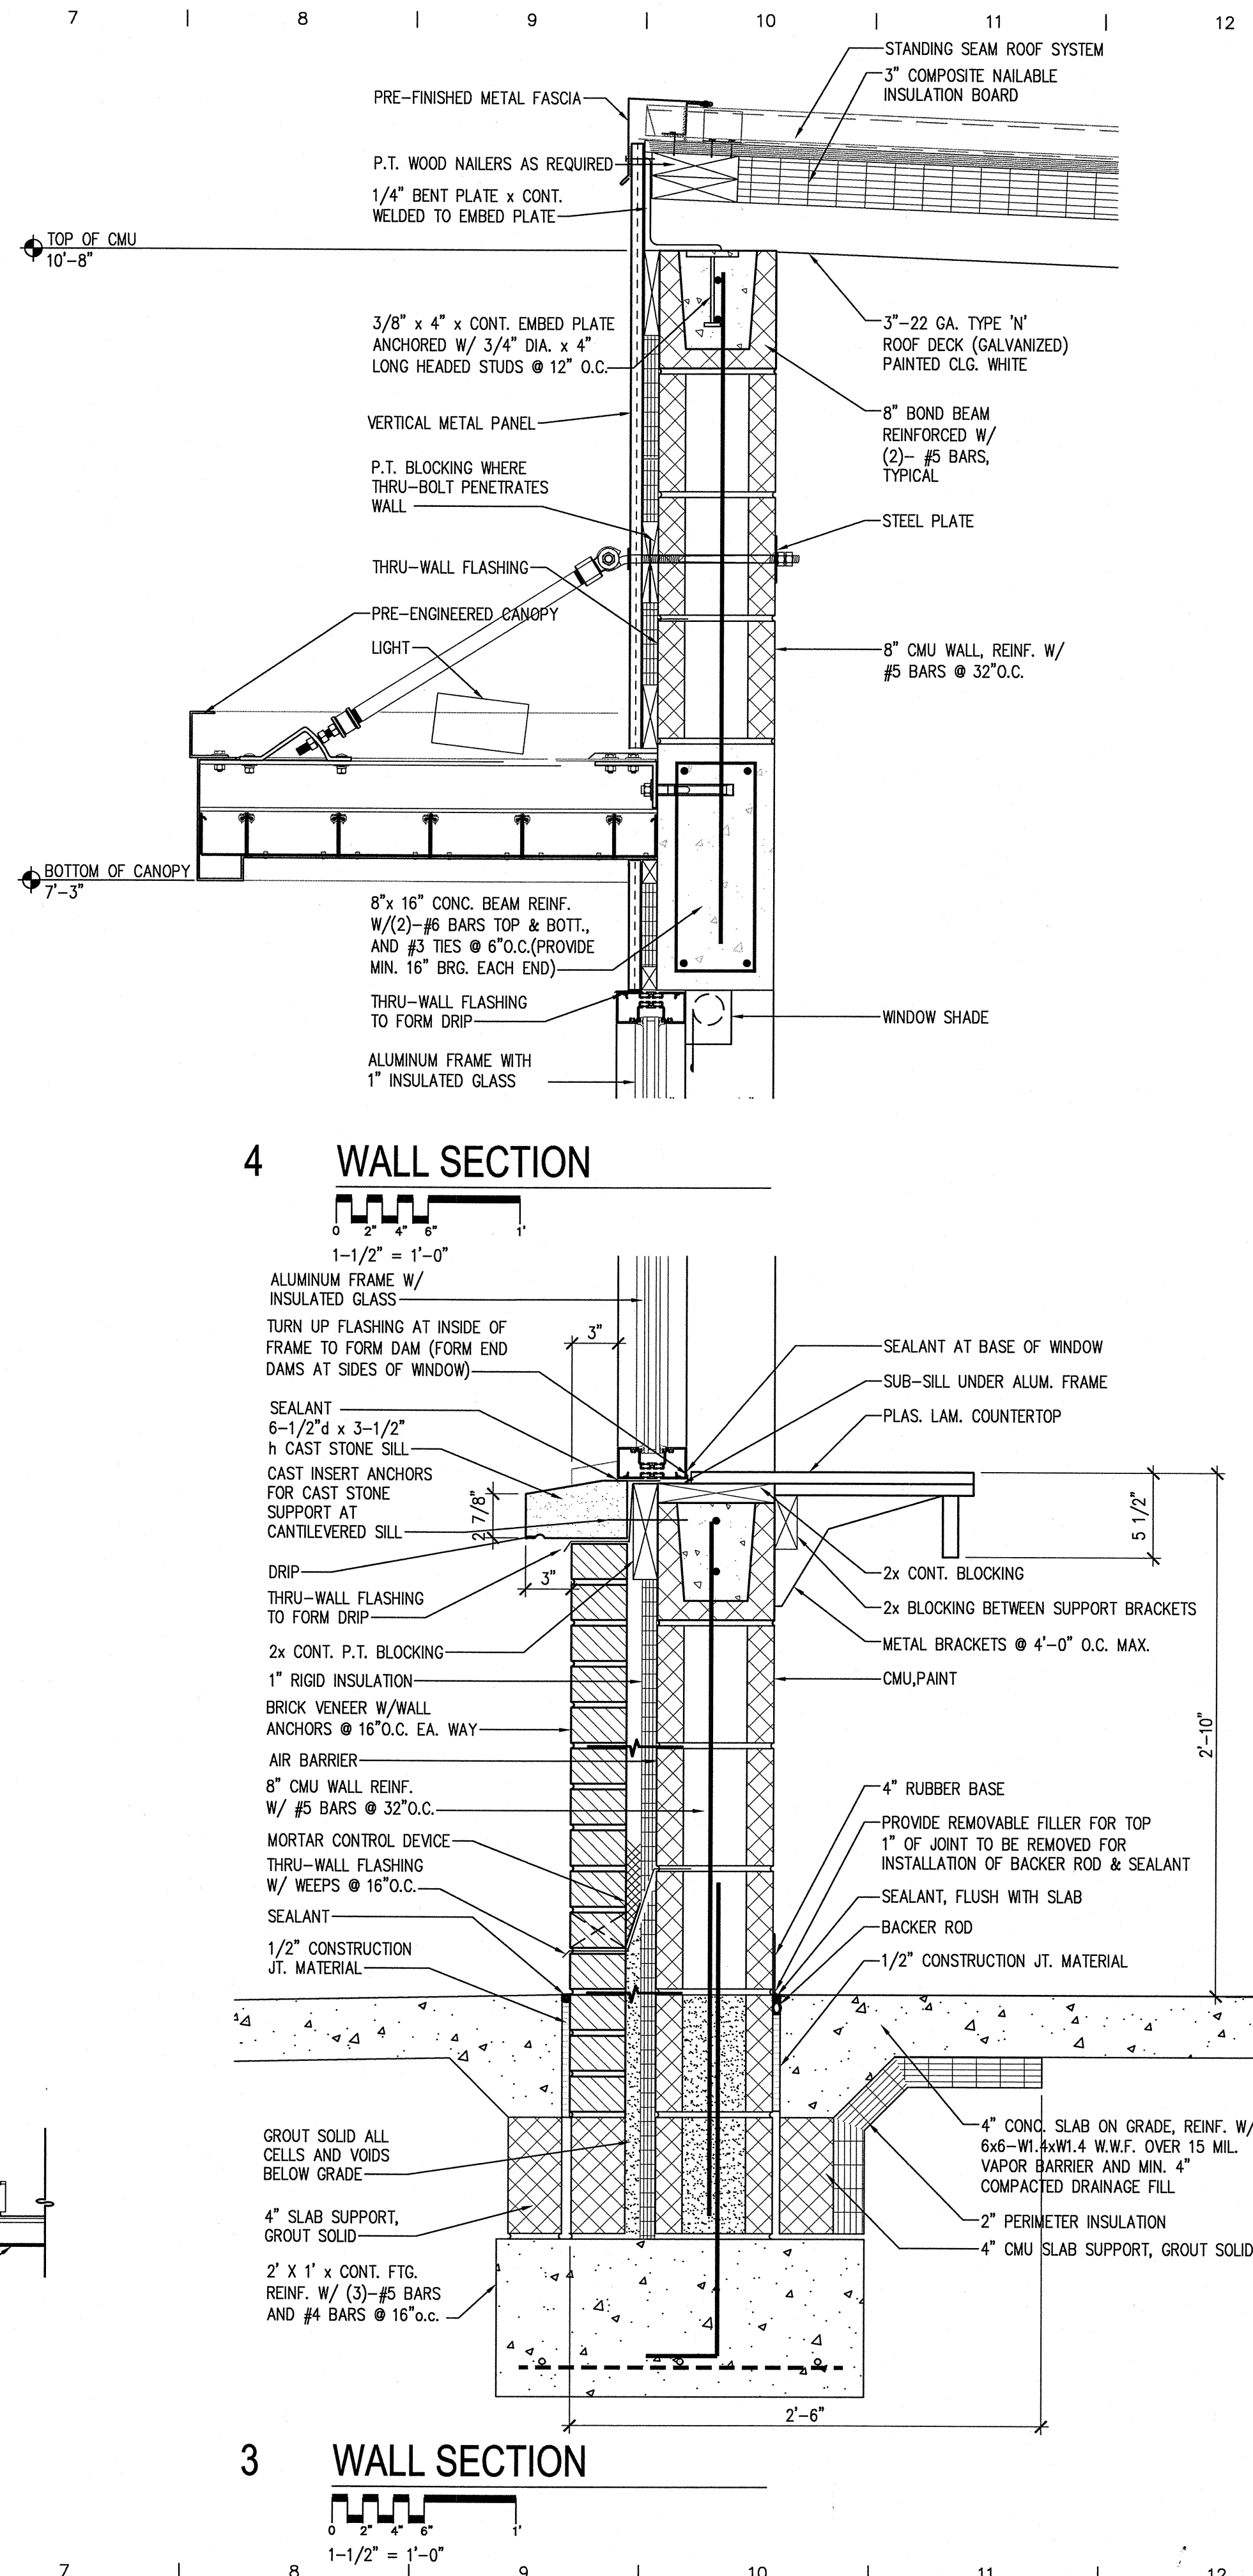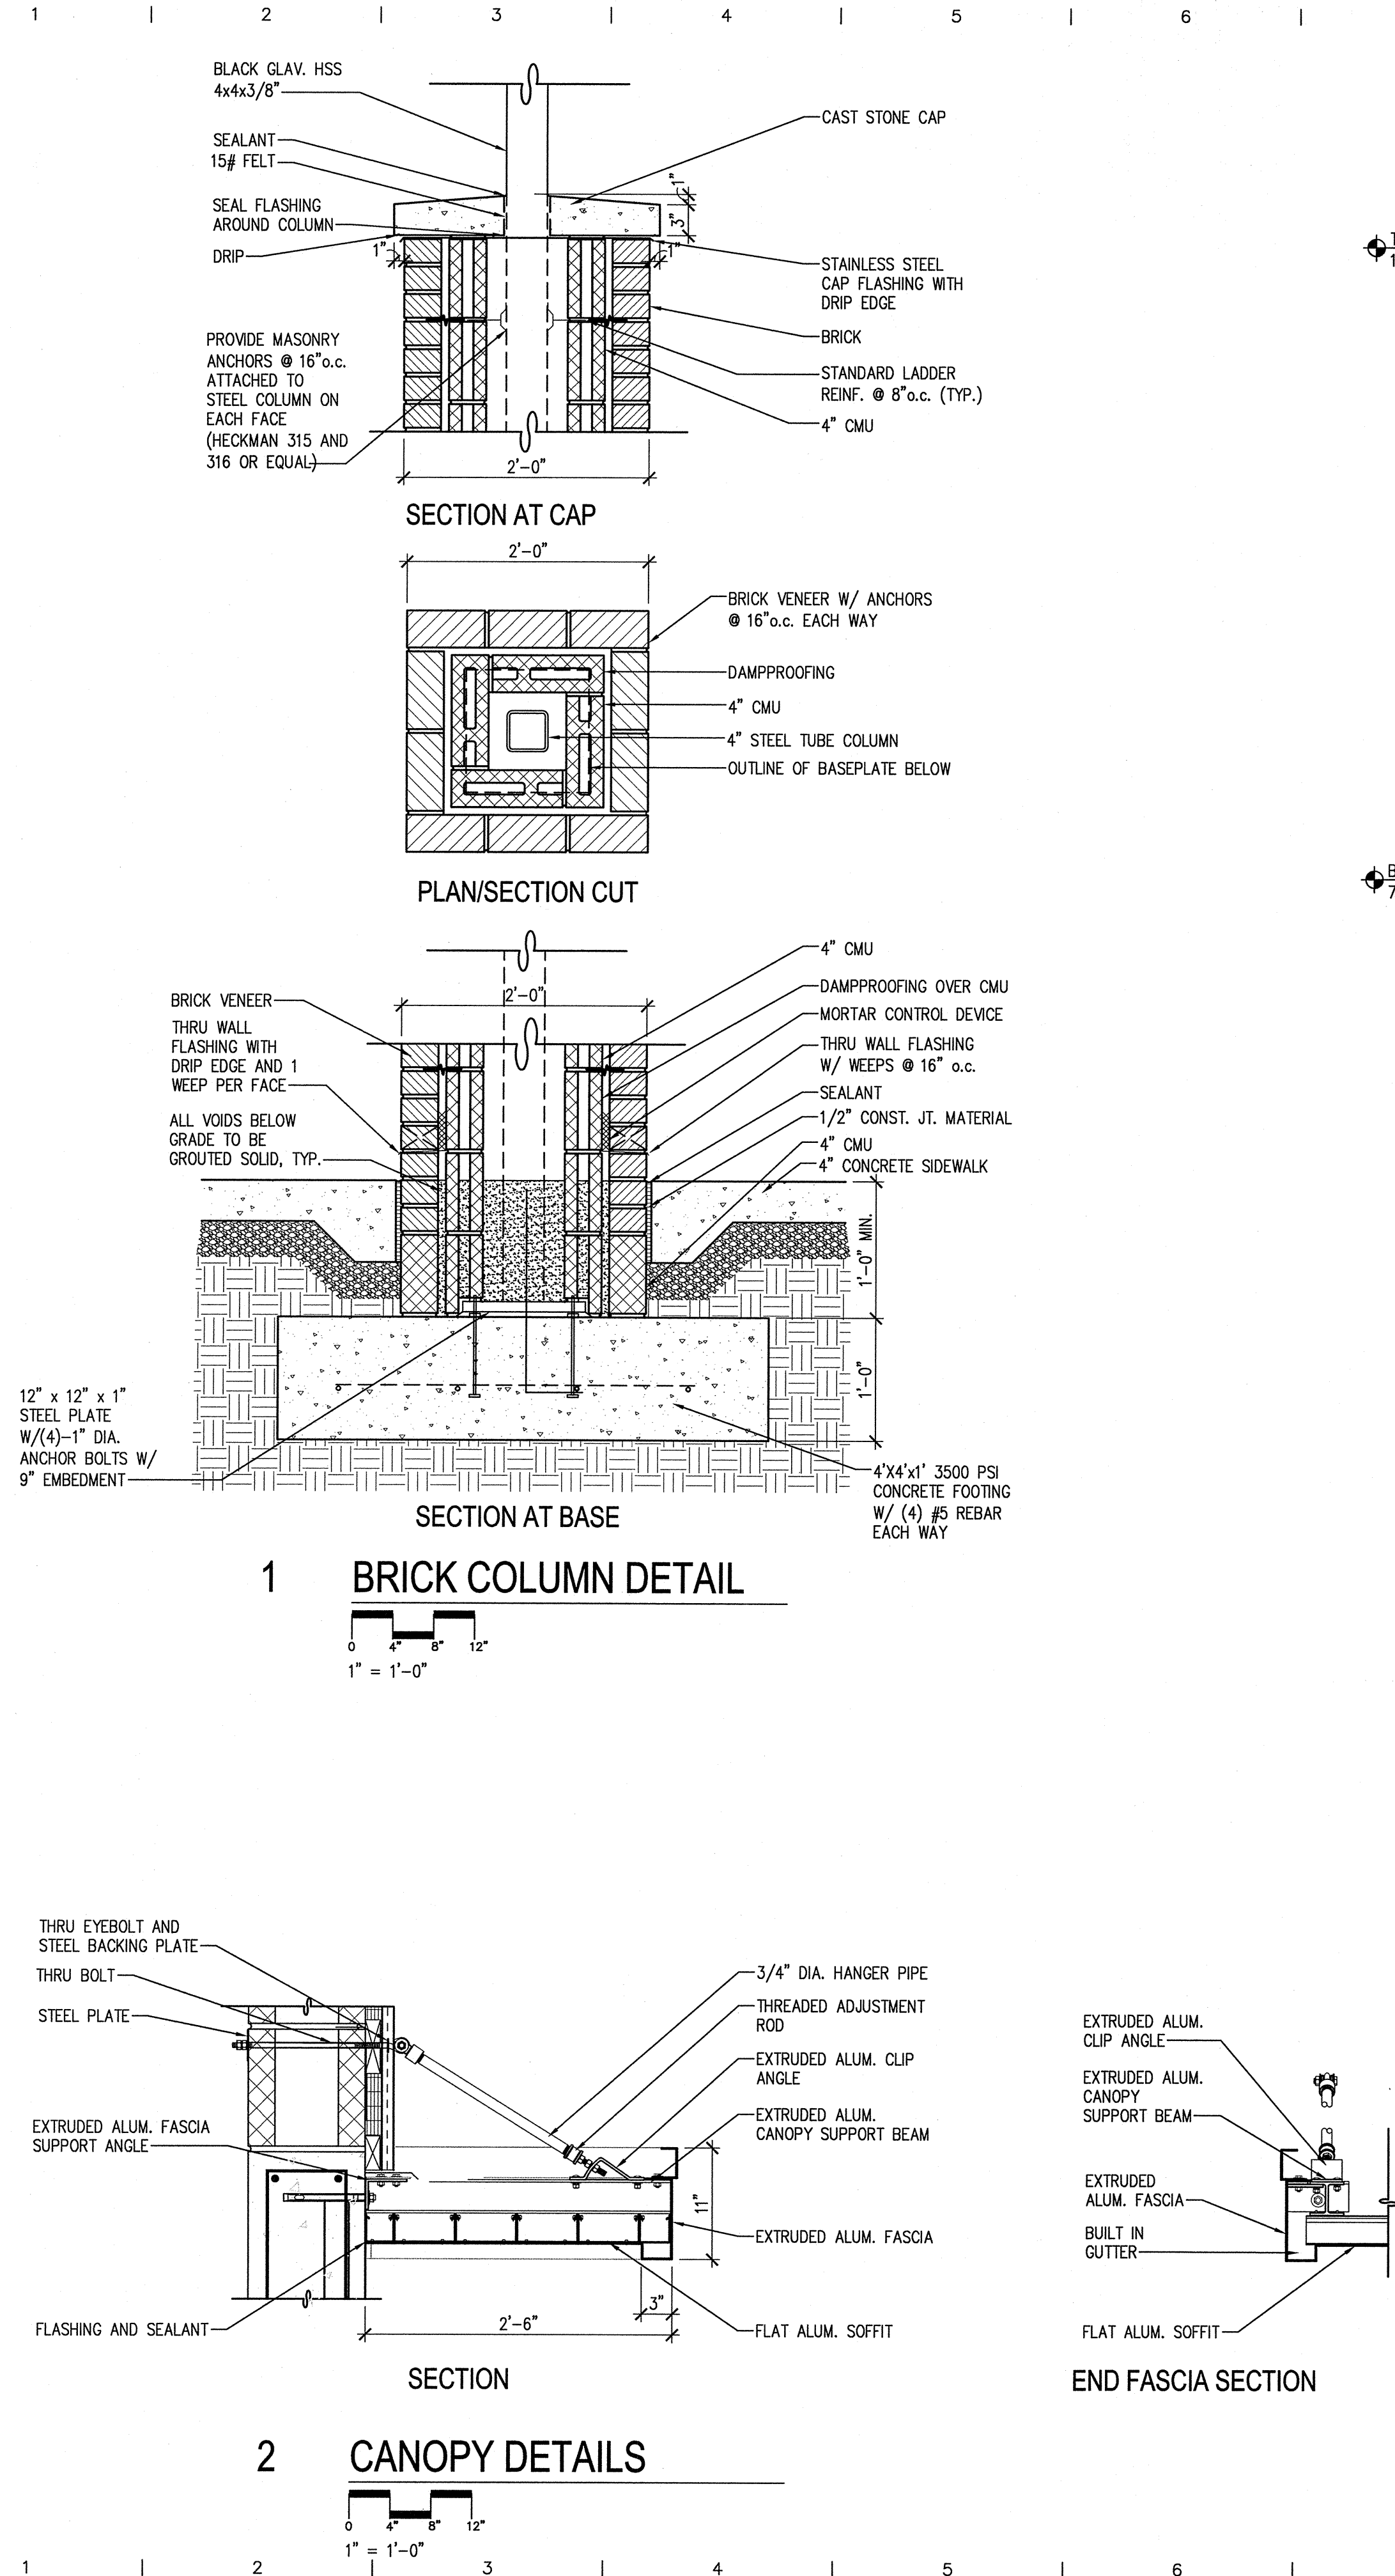

1910

HFR DESIGN

ARCHITECTURE
ENGINEERING
PLANNING
INTERIORS

HART FREELAND ROBERTS, INC.
7101 Executive Center Drive
Suite 300
Brentwood, TN 37024
615.370.8500 phone
615.370.8500 fax
www.hfrdesign.com web

Nashville, Tennessee
Jackson, Tennessee
Kansas City, Missouri
Louisville, Kentucky

STEPHEN P. ROBERTS
No. 12250
4-23-2012
STATE OF TENNESSEE

**HALE STADIUM RENOVATIONS
NORTH AND SOUTH ENTRIES
TENNESSEE STATE UNIVERSITY**

JOHN A MERRITT BLVD
NASHVILLE, TN
SBC# 166/001-02-2011


PROJ. NO.: 2011171
DATE: 25 APRIL 2012

DETAILS

A

1.03


PLOT DATE: 4/23/2012 3:03:04 PM (BIALONE)
© COPYRIGHT 2012 - ALL RIGHTS RESERVED. NO PORTIONS OF THIS DOCUMENT MAY BE REPRODUCED WITHOUT THE EXPRESSED WRITTEN CONSENT OF HART FREELAND ROBERTS, INC.

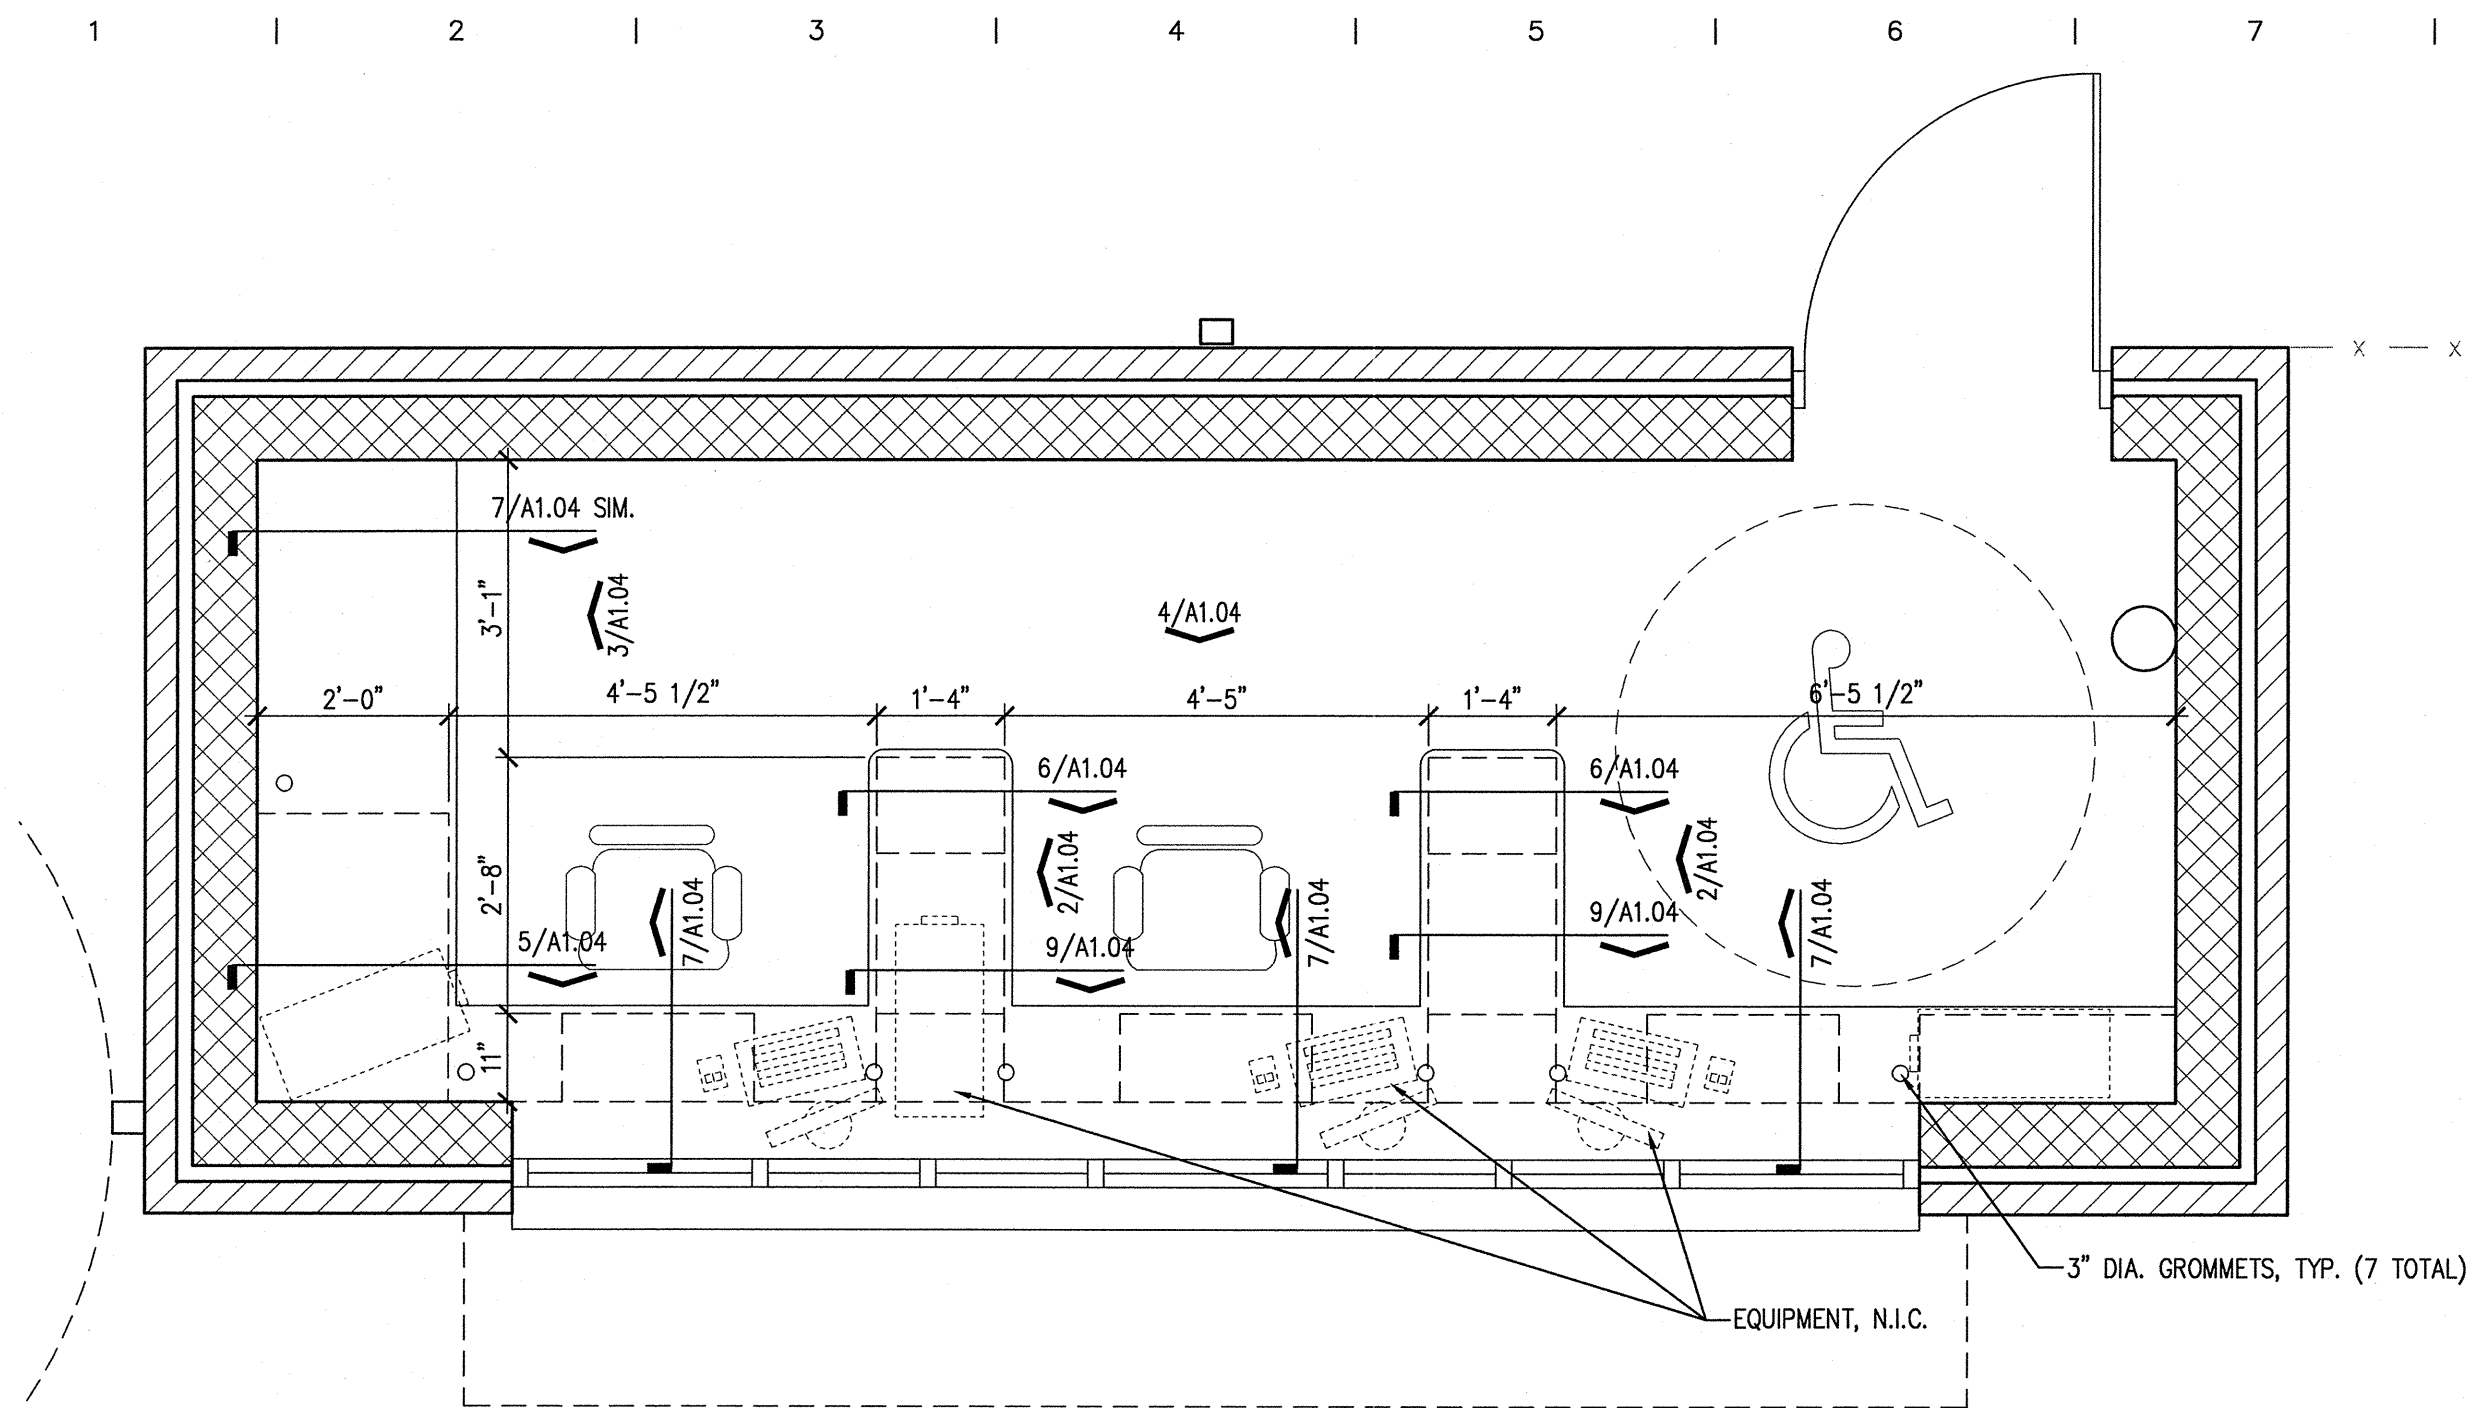

1 TICKET BOOTH PLAN, TYP.


1/2" = 1'-0"

- DOOR SCHEDULE:
- 3'-0" X 7'-0" H. METAL, FLUSH, INSULATED, PEEP HOLE
 - PROVIDE WEATHER STRIPPING, THRESHOLD
 - REFER TO SPEC SECTION 087100 FOR HARDWARE
 - H. METAL FRAME; SEE DETAILS THIS SHEET

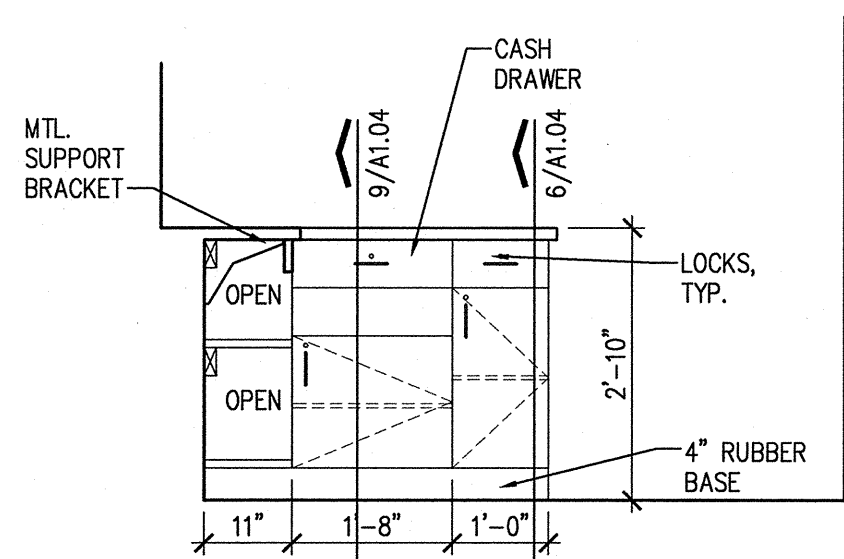


2 CASEWORK ELEVATION

1/2" = 1'-0"

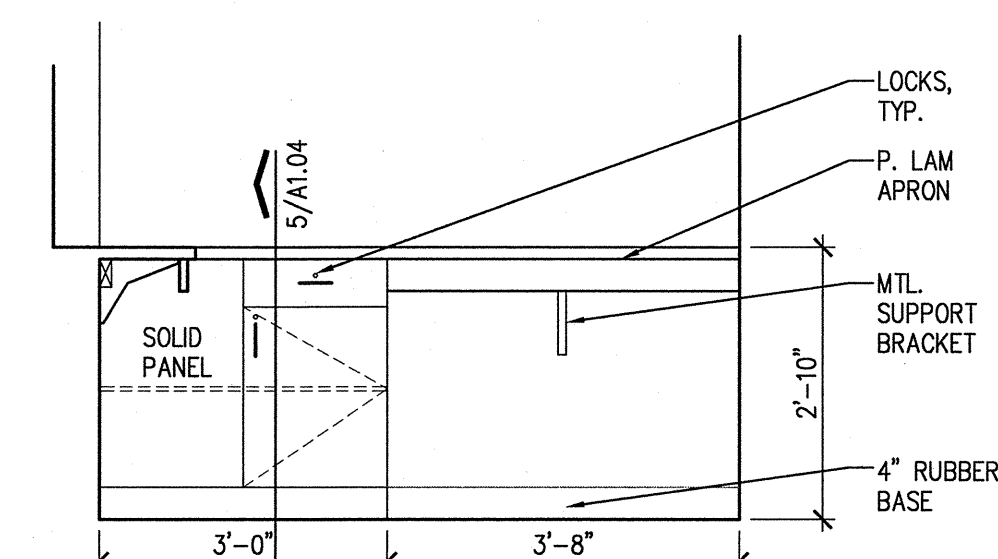

3 CASEWORK ELEVATION


1/2" = 1'-0"

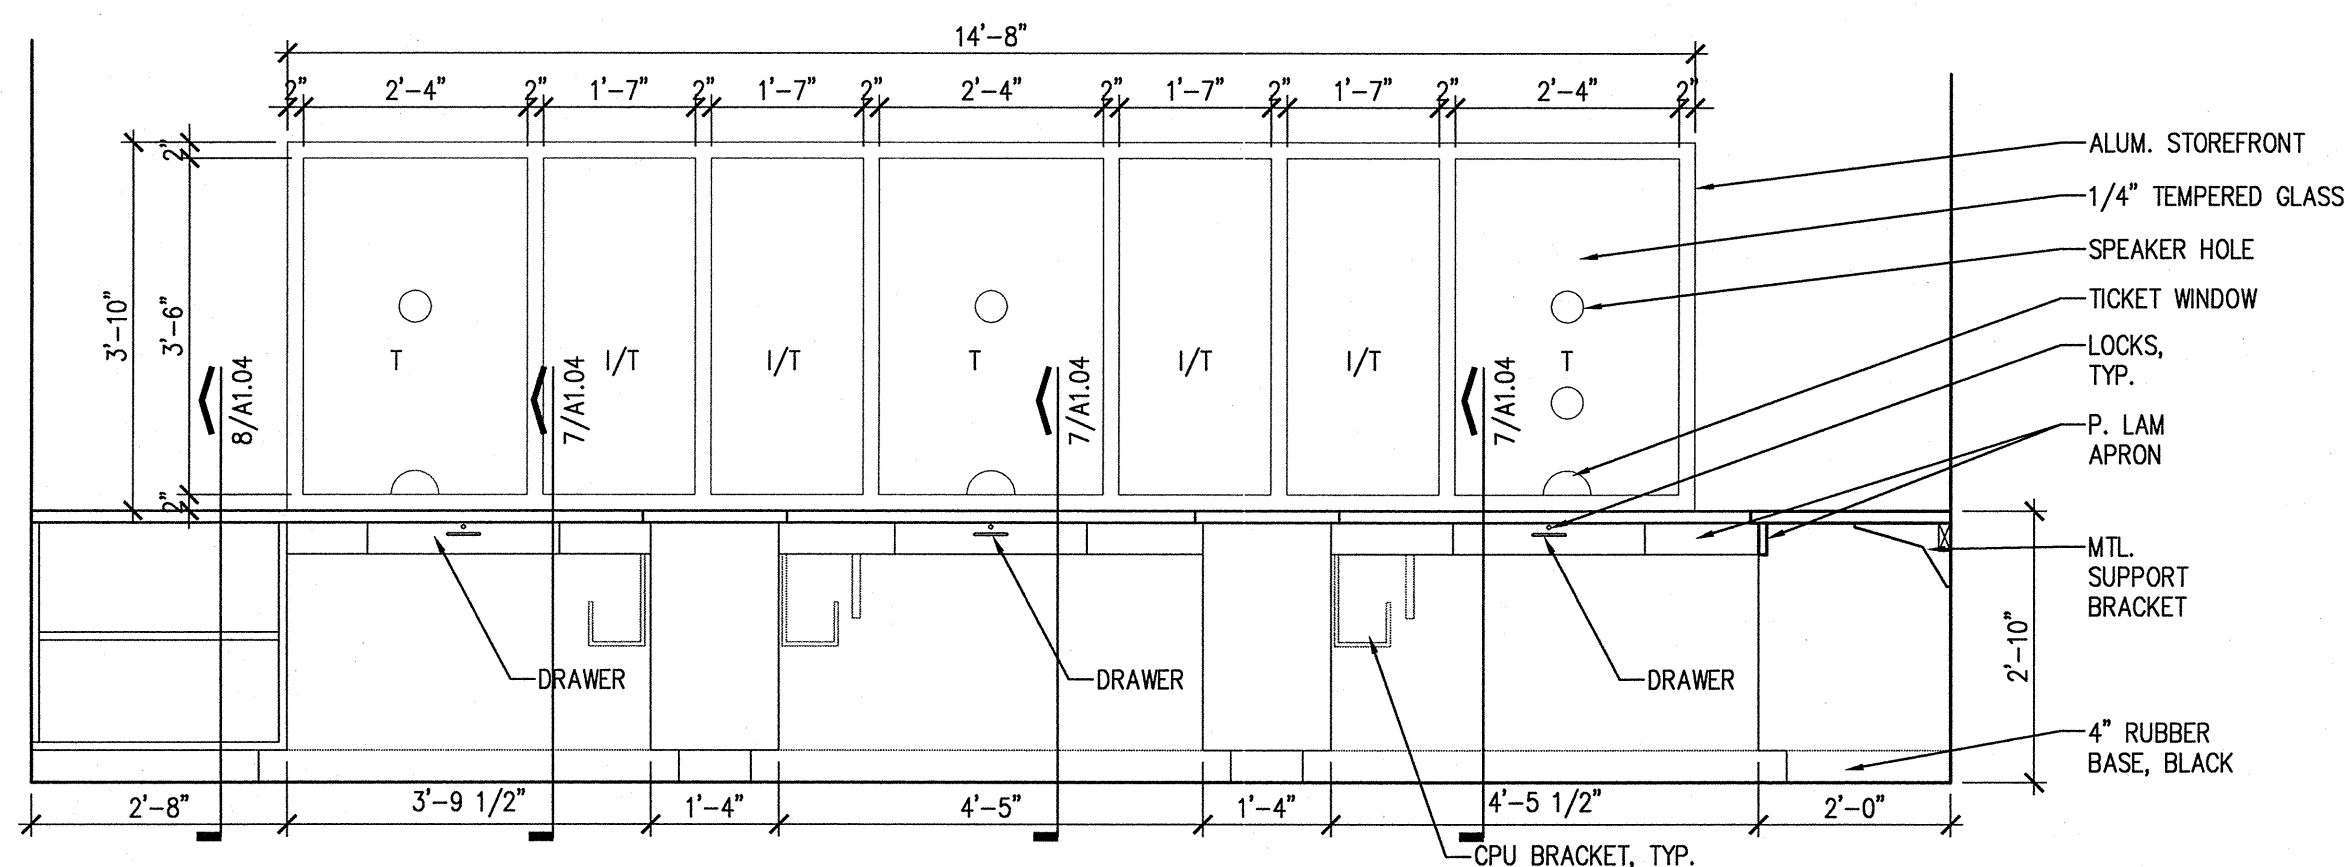

4 CASEWORK ELEVATION


1/2" = 1'-0"

I/T = INSULATED, TEMPERED GLASS
T = 1/4" TEMPERED GLASS

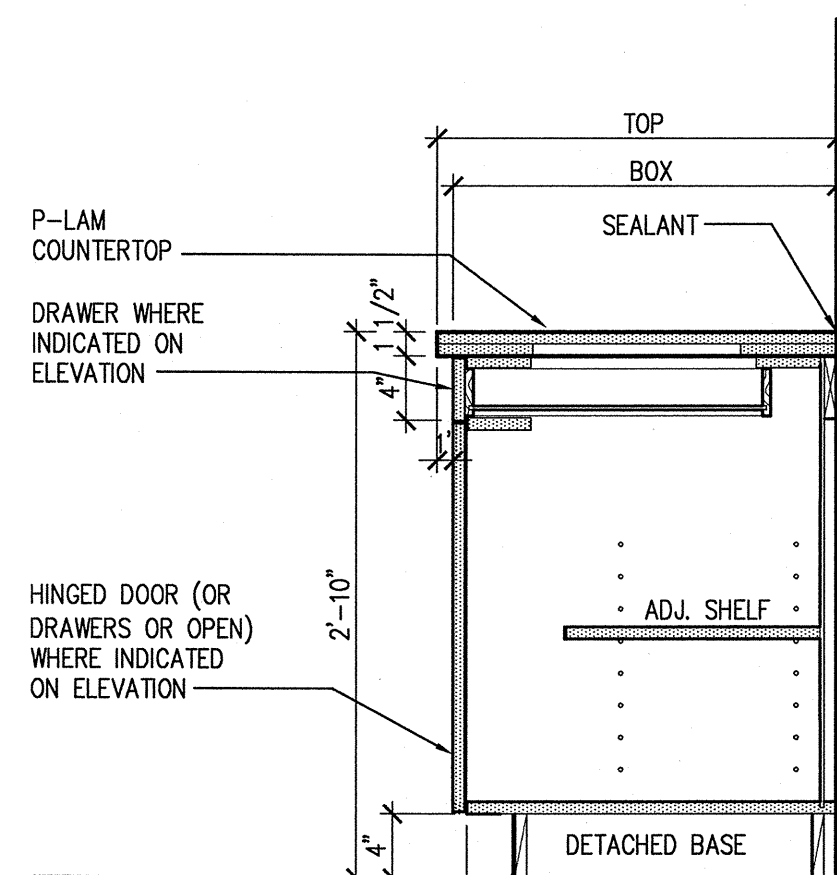


5 CASEWORK SECTION

1" = 1'-0"

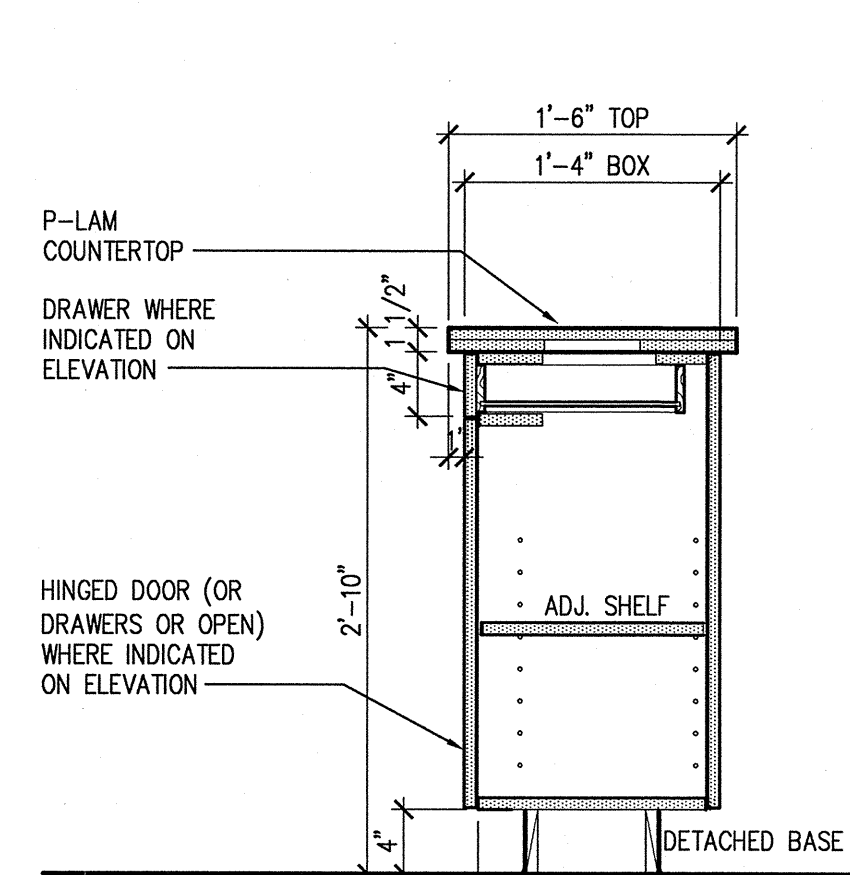


6 CASEWORK SECTION

1" = 1'-0"

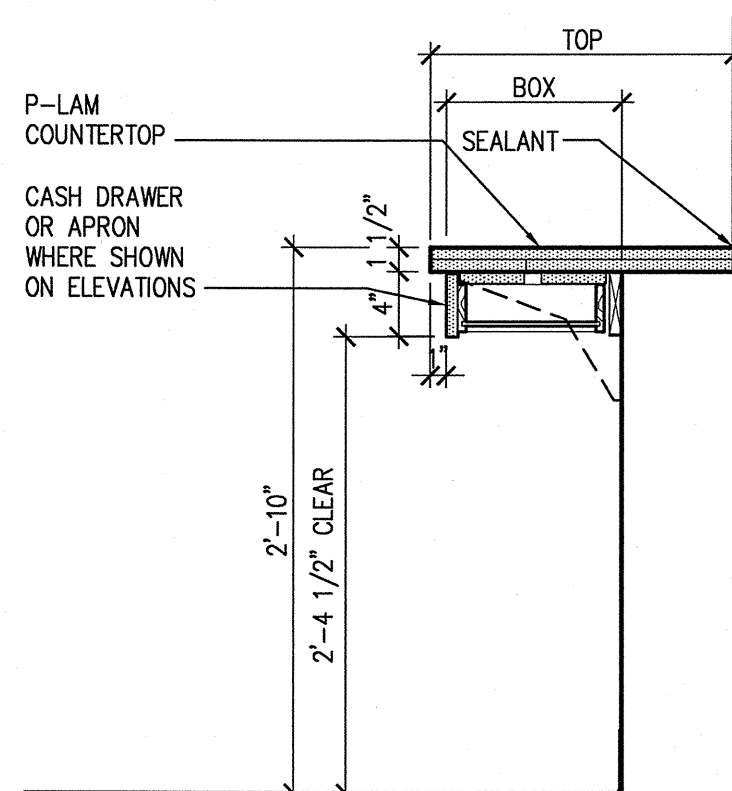


7 CASEWORK SECTION

1" = 1'-0"

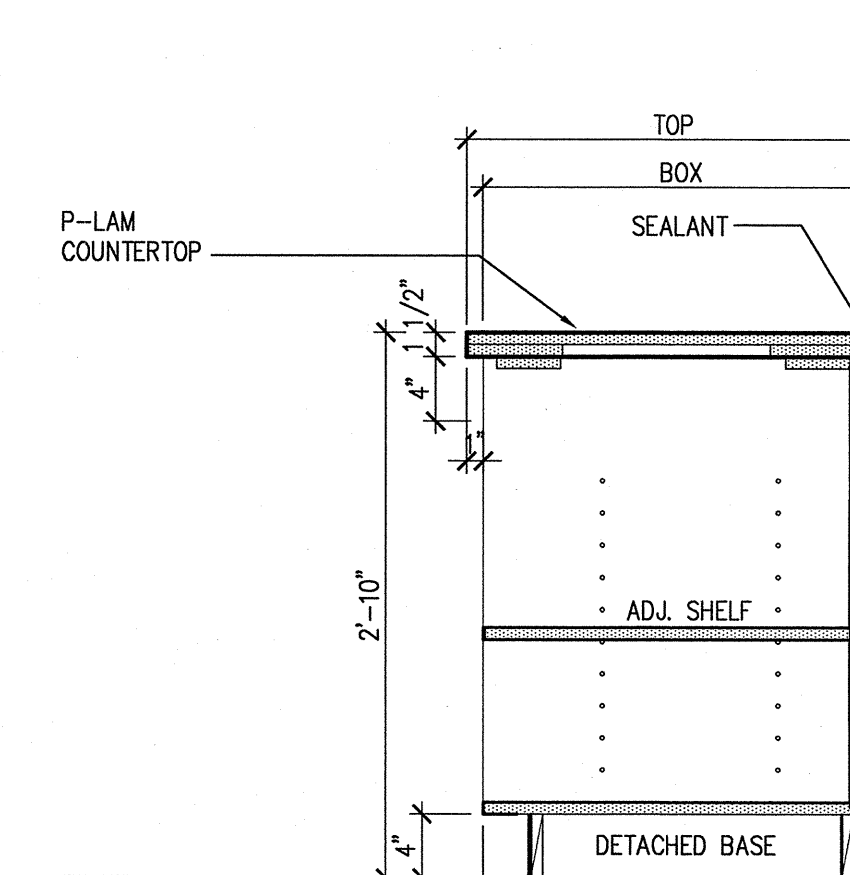


8 CASEWORK SECTION

1" = 1'-0"

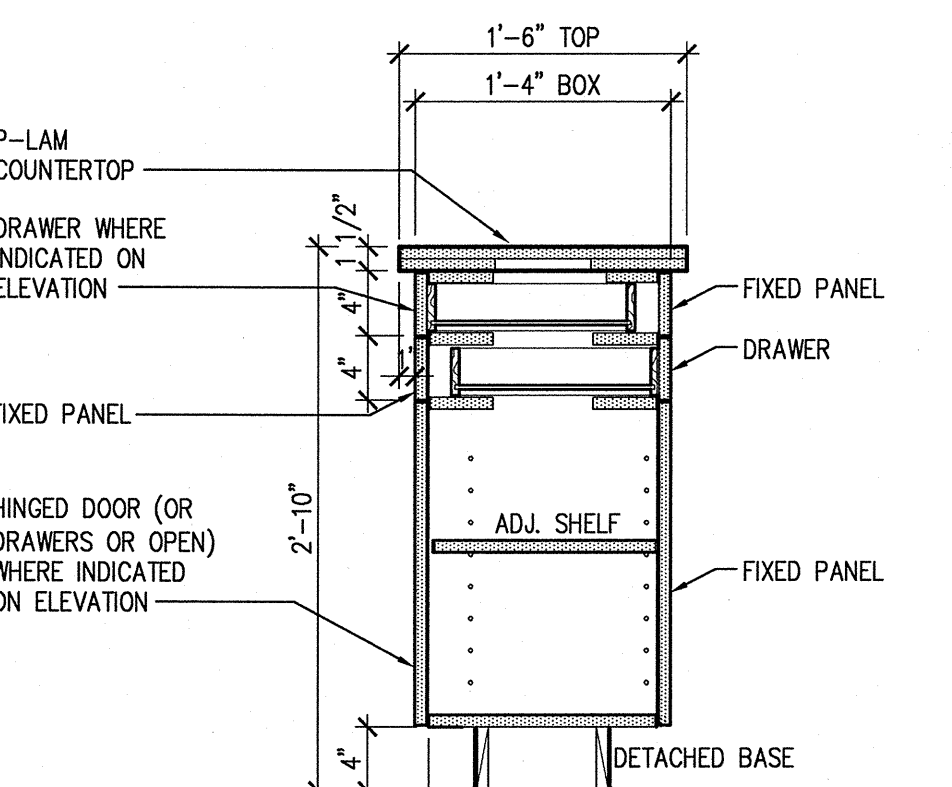


9 CASEWORK SECTION

1" = 1'-0"

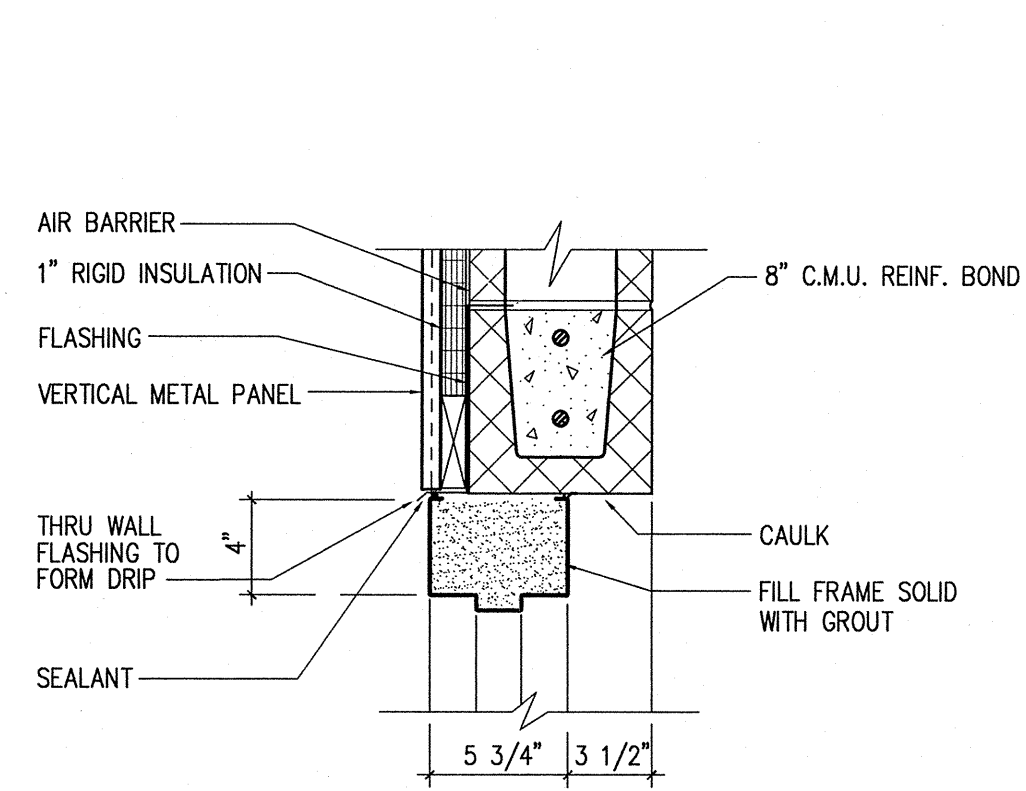


10 DOOR HEAD DETAIL

1-1/2" = 1'-0"

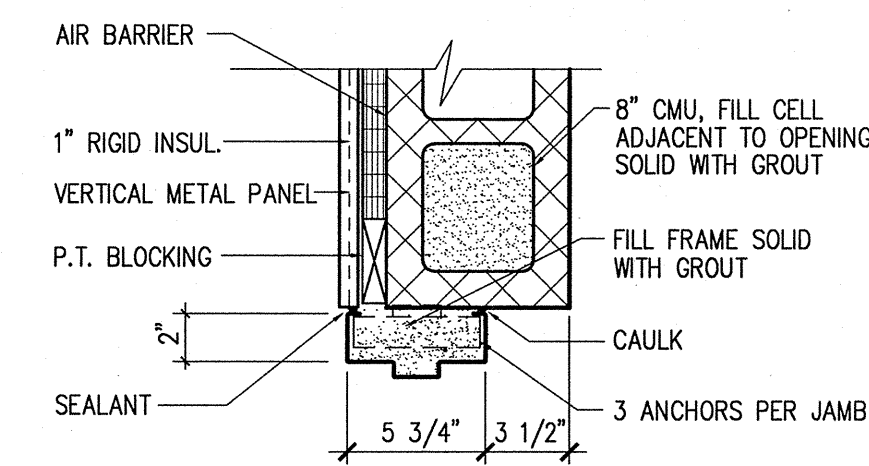


11 UPPER DOOR JAMB DETAIL

1-1/2" = 1'-0"

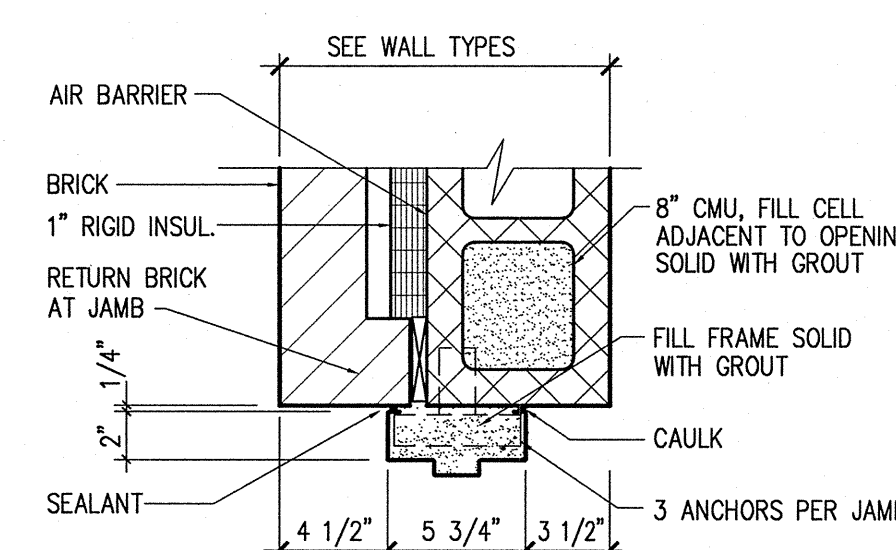

12 LOWER DOOR JAMB DETAIL

1-1/2" = 1'-0"

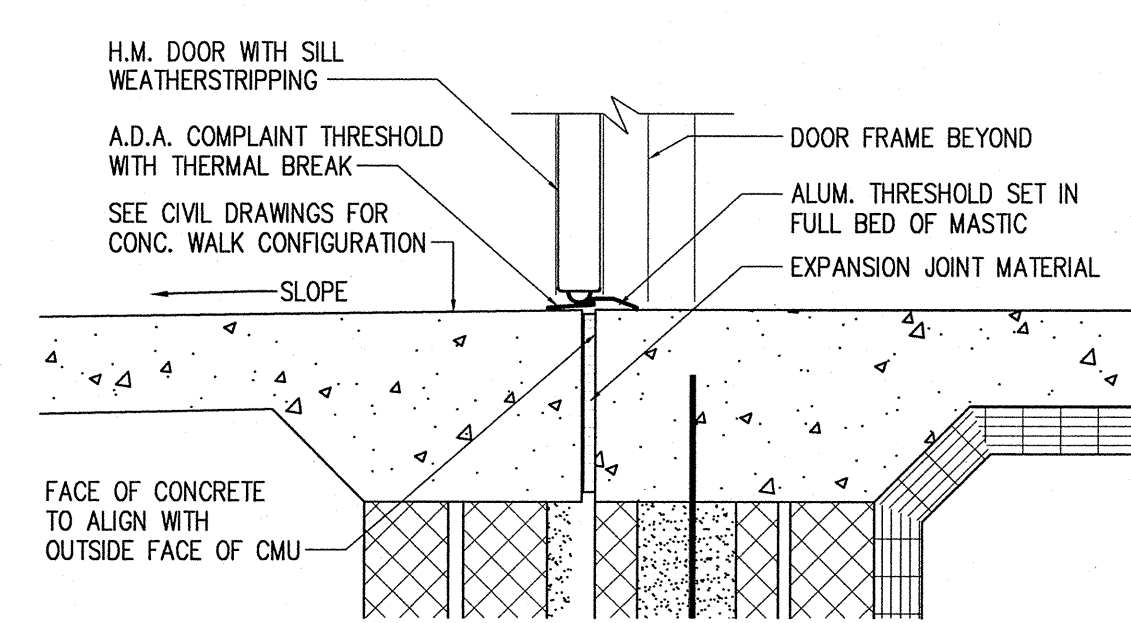

13 DOOR SILL DETAIL

1-1/2" = 1'-0"



ARCHITECTURE
ENGINEERING
PLANNING
INTERIORS

HART FREELAND ROBERTS, INC.
7101 Executive Center Drive
Suite 300
Brentwood, TN 37024

615.370.8500 phone
615.370.8530 fax
www.hfrdesign.com web

Nashville, Tennessee
Jackson, Tennessee
Kansas City, Missouri
Louisville, Kentucky



HALE STADIUM RENOVATIONS
NORTH AND SOUTH ENTRIES
TENNESSEE STATE UNIVERSITY
JOHN A MERRITT BLVD
NASHVILLE, TN
SBC# 166/001-02-2011

PROJ. NO.: 2011171

DATE: 25 APRIL 2012


DETAILS

A
1.04


THROUGH THE WALL HP UNIT SCHEDULE		
UNIT NO.	HP-1	
MANUFACTURER (BOD)	AMANA	
TYPE	Ⓐ	
MODEL	PBH113	
COOLING CAPACITY		
TOTAL MBH	11,500	
SENSIBLE MBH	----	
E.A.T. DB/WB °F	80/67	
O.A.T. DB °F	95	
INDOOR UNIT		
FAN		
TOTAL CFM	265	
O.A. CFM	30	
ESP IN WG	----	
DIMENSIONS (LxDxH)	25x25x16	
AUX. ELECT. HT	3KW	
ELECTRICAL ⓐ	240-1	
FAN FLA	----	
MCA	----	
MOCP	6-20P	
ACCESSORIES	①THRU ⑦	
REMARKS:		
Ⓐ THROUGH THE WALL HEAT PUMP UNIT.		
① POWER CORD FOR CONNECTION TO 6-20P OUTLET.		
② 5 YEAR COMPRESSOR WARRANTY.		
③ INSULATED METAL WALL SLEEVE.		
④ EXTERNAL CONDENSATE DRAIN ON WALL SLEEVE.		
⑤ ARCHITECTURAL GRILLE OF CUSTOM COLOR SELECTED BY ARCHITECT.		
⑥ FRESH AIR DAMPER SET FOR 30 CFM FRESH AIR.		
⑦ DIGITAL CONTROL PANEL WITH TEMP SETPOINT REMOTE CONTROLLER.		

MECHANICAL GENERAL NOTES:

- DRAWINGS ARE DIAGRAMMATIC AND INDICATE GENERAL ARRANGEMENT OF SYSTEMS. DRAWINGS SHALL NOT BE SCALED.
- CONTRACTOR SHALL FIELD VERIFY BY MEASUREMENT THE EXACT LOCATION OF EQUIPMENT, DUCTWORK, PIPING, STRUCTURE, AND OTHER CONDITIONS WHICH WILL AFFECT INSTALLATION. CONTRACTOR SHALL LOCATE EQUIPMENT AND ROUTE DUCTWORK AND PIPING TO AVOID CONFLICTS AND INTERFERENCES WITH FIELD CONDITIONS.
- PRIOR TO ANY INSTALLATION, CLOSELY COORDINATE ALL MECHANICAL WORK WITH PLUMBING, FIRE PROTECTION, ELECTRICAL, ARCHITECTURAL, AND STRUCTURAL WORK. CONTRACTOR TO ENSURE ALL EQUIPMENT AND SERVICES WILL FIT IN AVAILABLE SPACES ALLOWING CEILING HEIGHTS INDICATED ON ARCHITECTURAL PLANS. INSTALL EQUIPMENT SO AS TO PROVIDE CLEARANCES SHOWN ON DRAWINGS AND AS RECOMMENDED BY MANUFACTURER FOR AIRFLOW, SERVICE, MAINTENANCE, AND FILTER REMOVAL AS APPLICABLE.
- COORDINATE DUCT, PIPING, AND EQUIPMENT LOCATIONS WITH ELECTRICAL PANEL LOCATIONS. DO NOT PASS ANY MECHANICAL OR PLUMBING ITEMS DIRECTLY OVER ELECTRICAL PANELS. SEE ELECTRICAL DRAWINGS FOR EXACT PANEL LOCATIONS.
- ALL EXPOSED DUCTWORK, PIPING, AND EQUIPMENT IN FINISHED SPACES TO BE INSTALLED AS HIGH AS POSSIBLE ABOVE FINISHED FLOOR.
- ALL MANUFACTURER'S LISTED ARE BASIS OF DESIGN (BOD) ONLY AND ARE NOT INTENDED TO ELIMINATE EQUIPMENT SUBSTITUTIONS. SEE SPECIFICATIONS FOR ALTERNATE MANUFACTURER'S.

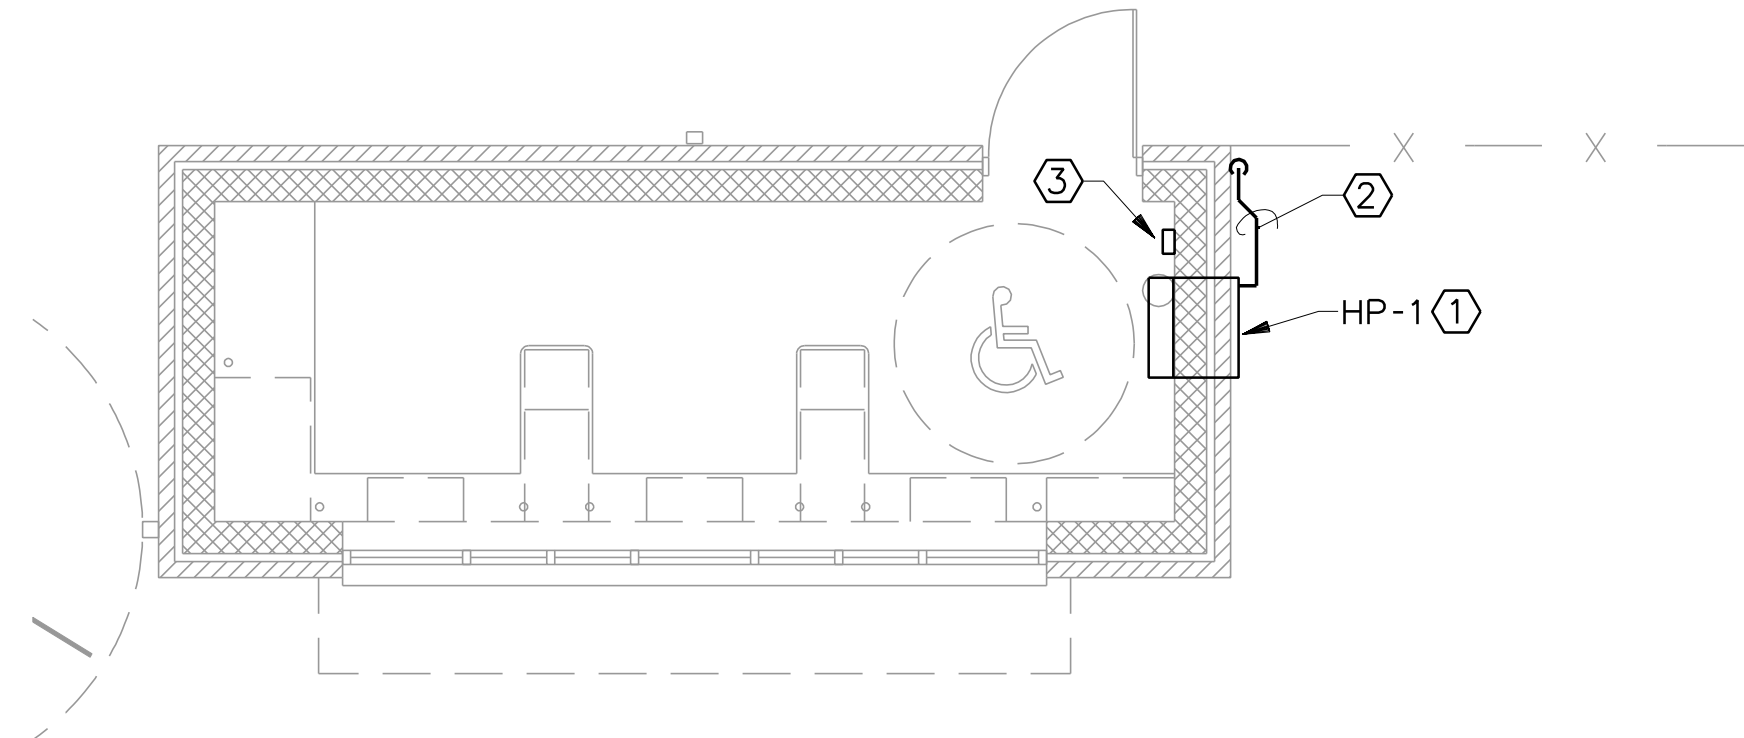


MECHANICAL - NORTH GATE FLOOR PLAN

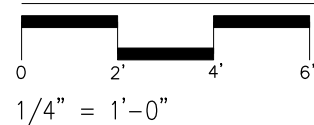


NOTES ⓐ:

- ⓐ MOUNT HP SO BOTTOM ELEVATION IS 7'-6" ABOVE FINISHED FLOOR. COORDINATE WITH ARCHITECTURAL ELEVATIONS.
- ⓐ ROUTE CONNECTION SIZE PVC CONDENSATE DRAIN TO NEAREST GUTTER. PAINT PIPE TO MATCH BUILDING.
- ⓐ UNIT COMES WITH REMOTE CONTROL. PROVIDE MEANS TO HOLD REMOTE CONTROLLER.

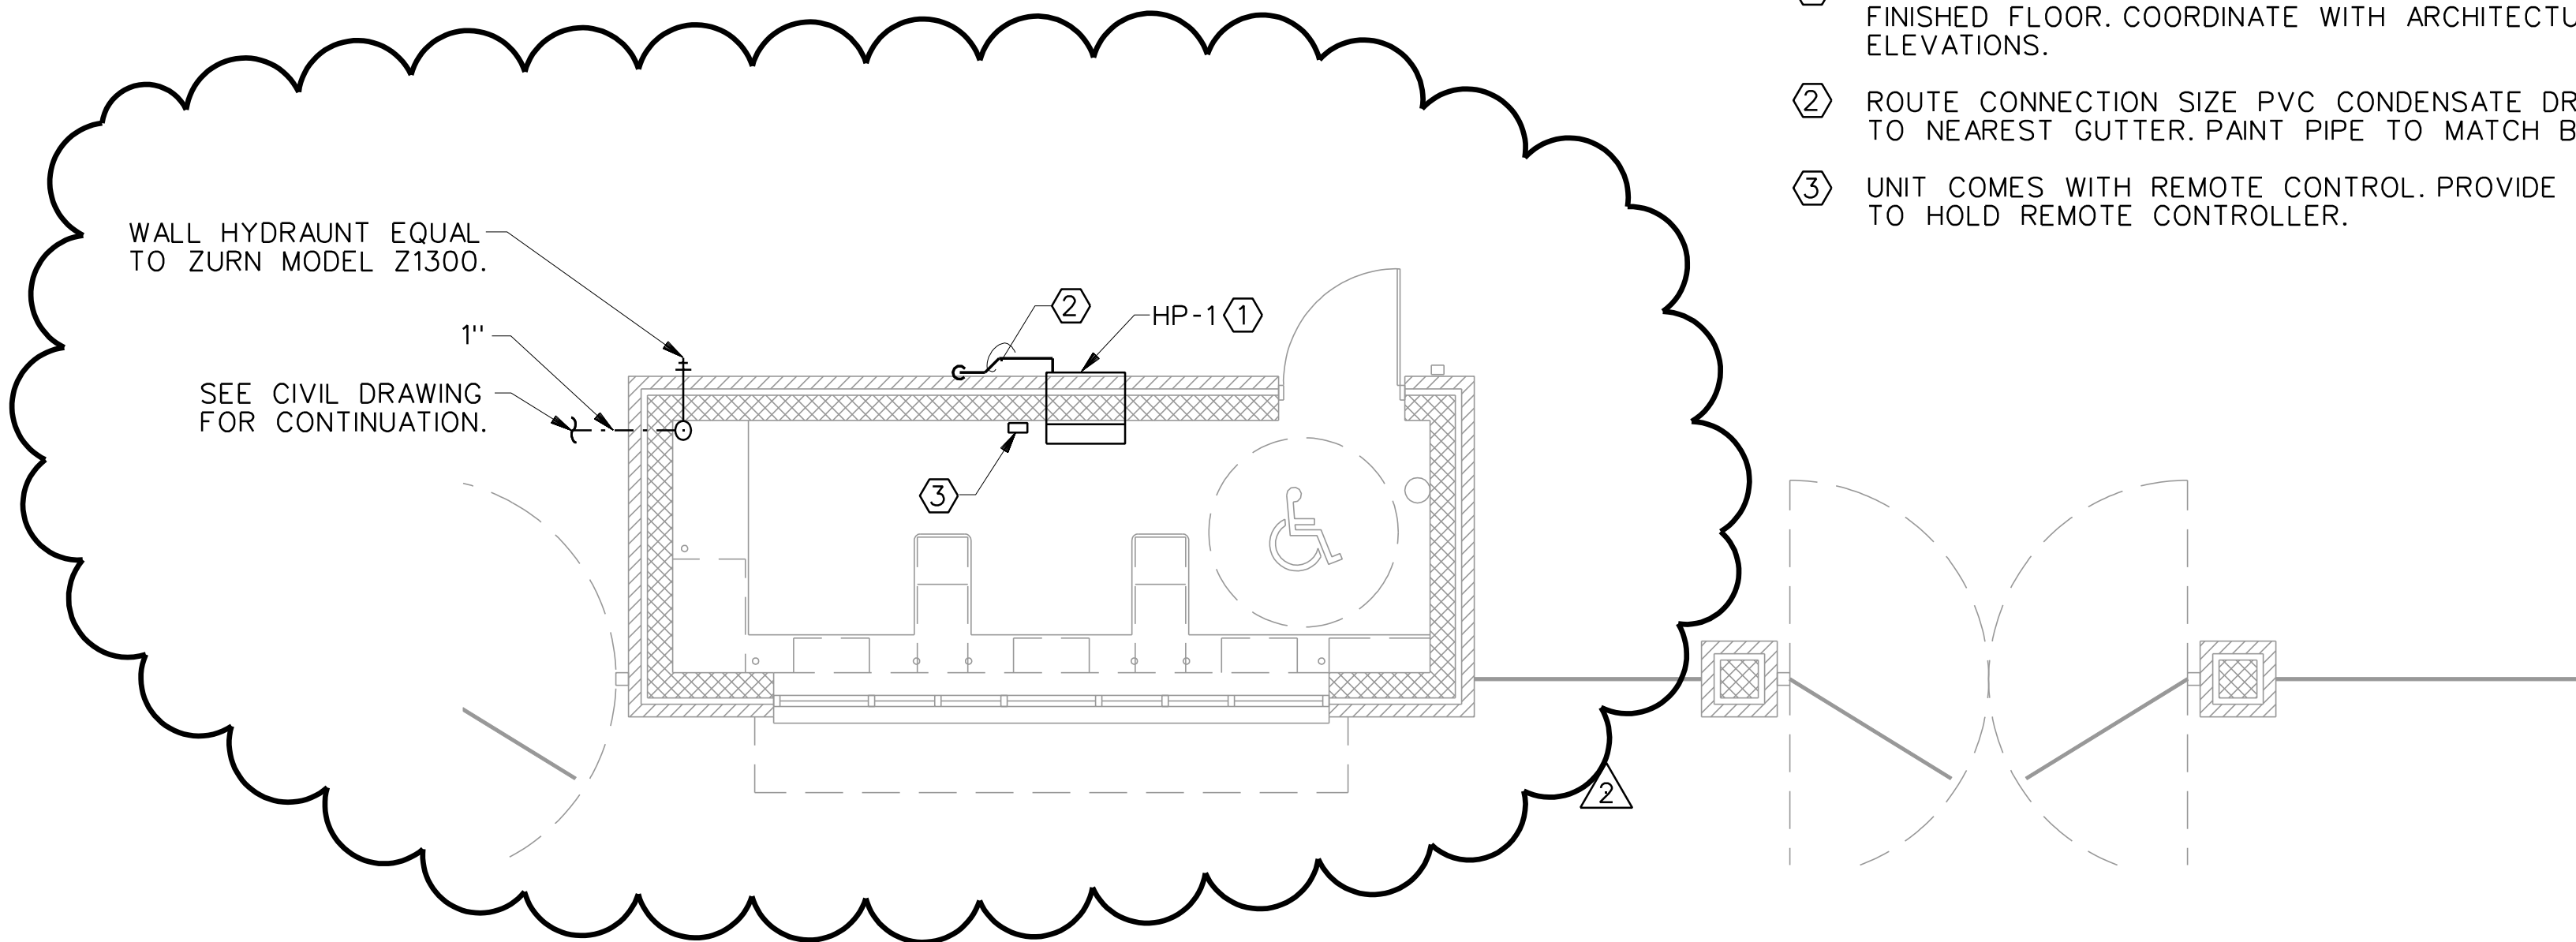

MECHANICAL - SOUTH GATE FLOOR PLAN

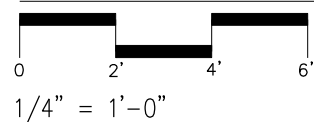

ARCHITECTURE
ENGINEERING
PLANNING
INTERIORS

HART FREELAND ROBERTS, INC.
7101 Executive Center Drive
Suite 300
Brentwood, TN 37024
615.370.8500 phone
615.370.8530 fax
www.hfrdesign.com web
Nashville, Tennessee
Jackson, Tennessee
Kansas City, Missouri
Louisville, Kentucky

ADD#2 5-16-12



HALE STADIUM RENOVATIONS
NORTH AND SOUTH ENTRIES
TENNESSEE STATE UNIVERSITY
JOHN A MERRITT BLVD
NASHVILLE, TN
SBC# 166/001-02-2011

PROJ. NO.: 2011171

DATE: 25 APRIL 2012


MECHANICAL-
FLOOR PLANS

M
1.01

TBS PANEL SCHEDULE										CONNECTED LOAD (KVA):		SYSTEM AVAILABLE FAULT CURRENT:	
120 /240 VOLT, 1 PHASE, 3 WIRE, 10 KA INT. RATING										6.75			
60 AMP X MCB MLO SURFACE X FLUSH										REMARKS:			
NOTE! UNLESS OTHERWISE NOTED ALL BREAKERS TO BE 20A, 1P. WITH *12 CONDUCTORS. EXCEPT WHERE BRANCH CIRCUIT IS IN EXCESS OF 90 LINEAR FEET CONDUCTORS TO BE *10 AND OVER 175 LINEAR FEET CONDUCTORS TO BE *8.													
DESCRIPTION	KVA PER PHASE		CKT NO	BREAKER AMP/POLE	A	B	BREAKER		CKT NO	KVA PER PHASE		DESCRIPTION	
	A	B					POLE	AMP		A	B		
LTG - TICKET BOOTH	.15		1						2	.36		REC. - TICKET BOOTH	
LTG - EXTERIOR		.32	3						4	.54		REC. - TICKET BOOTH	
LTG - EXTERIOR	.60		5						6	.36		REC. - EXTERIOR	
PHOTOCELL		.20	7				2	20	8	1.75		HP-1	
SPARE			9				↓	↓	10	1.75		↓	
			11						12			SPARE	
			13						14			↓	
			15						16	.36		REC. - EXTERIOR	
			17						18	.36		REC. - EXTERIOR	
			19						20			SPARE	
			21						22				
			23						24				
			25						26				
			27						28				
			29						30				
			31						32				
			33						34				
			35						36				
			37						38				
			39						40				
			41						42				
TOTALS:												TOTALS	

TBN PANEL SCHEDULE										CONNECTED LOAD (KVA):		SYSTEM AVAILABLE FAULT CURRENT:		
120 /240 VOLT, 1 PHASE, 3 WIRE, 10 KA INT. RATING										5.43				
60 AMP X MCB MLO SURFACE X FLUSH										REMARKS:				
NOTE! UNLESS OTHERWISE NOTED ALL BREAKERS TO BE 20A., 1P. WITH #12 CONDUCTORS. EXCEPT WHERE BRANCH CIRCUIT IS IN EXCESS OF 90 LINEAR FEET CONDUCTORS TO BE #10 AND OVER 175 LINEAR FEET CONDUCTORS TO BE #8.														
DESCRIPTION	KVA PER PHASE		CKT NO	BREAKER AMP/POLE	A	B	BREAKER POLE AMP		CKT NO	KVA PER PHASE		DESCRIPTION		
	A	B								A	B			
LTC - TICKET BOOTH	.15		1		•	•			2	.36		REC. - TICKET BOOTH		
LTC - EXTERIOR		.32	3		•	•			4	.54		REC. - TICKET BOOTH		
SPARE			5		•	•			6	.18		REC. - EXTERIOR		
PHOTOCELL		.2	7		•	•	2	20	8	1.75		HP-1		
SPARE			9		•	•	↓	↓	10	1.75		↓		
			11		•	•			12			SPARE		
			13		•	•			14			↓		
			15		•	•			16	.36		REC. - EXTERIOR		
			17		•	•			18	.36		REC. - EXTERIOR		
			19		•	•			20			SPARE		
			21		•	•			22					
			23		•	•			24					
			25		•	•			26					
			27		•	•			28					
			29		•	•			30					
			31		•	•			32					
			33		•	•			34					
			35		•	•			36					
			37		•	•			38					
			39		•	•			40					
			41		•	•			42					
TOTALS:													TOTALS	

ELECTRICAL LEGEND		
SYMBOL	DESCRIPTION	MOUNTING HEIGHT TO CENTERLINE UON
	CONDUIT CONCEALED IN FLOOR, WALL OR CEILING	
	CONDUIT CONCEALED BELOW GRADE ON SITE PLAN	
	CONDUIT EXPOSED ON WALL OR CEILING	
	HOMERUN CONDUIT	
	CONDUIT TURNING UP	
	CONDUIT TURNING DOWN	
	SURFACE MOUNTED WALL LIGHT FIXTURE ON NORMAL BRANCH CIRCUIT	
	WALL BRACKET FIXTURE CONNECTED TO NORMAL BRANCH CIRCUIT	
	THERMAL MOTOR SWITCH-(FBE)	48"
	MOTION SENSOR SWITCH - DUAL TECHNOLOGY	48"
	THERMAL MOTOR SWITCH, WITH PILOT LIGHT (FBE)	48"
	THERMAL MOTOR SWITCH, WEATHERPROOF -(FBE)	48"
	FACTORY WIRED CONTROLLER OR EQUIPMENT CONNECTION, FBO.(DISCONNECTS FBE AS REQUIRED)	
	MOTOR CONTROLLER OR CONTACTOR	
	COMBINATION MOTOR STARTER DISCONNECT	
	DISCONNECT SWITCH, NON-FUSIBLE	
	DISCONNECT SWITCH, FUSIBLE	
	DISCONNECT SWITCH, NON-FUSIBLE NEMA-3R	
	DISCONNECT SWITCH, FUSIBLE NEMA-3R	
	MOTOR CONNECTION WITH APPROXIMATE HORSE-POWER SHOWN	
	JUNCTION BOX	
	PULL BOX	
	PANELBOARD	
	MAIN SWITCHBOARD	
	ENCLOSED CIRCUIT BREAKER	
	SINGLE RECEPTACLE, AMPERAGE, VOLTAGE, NEMA CONFIGURATION AS REQUIRED BY EQUIP. SUPPLIER OR AS NOTED	18"
	120V. DUPLEX RECEPTACLE (IVORY)	18"
	120V. DUPLEX RECEPTACLE ABOVE COUNTER (IVORY)	AS SPECIFIED
	120V. DUPLEX RECEPTACLE FOR TV POWER (IVORY) * COORDINATE MOUNTING HEIGHT WITH T001.	AS NOTED
	120V. QUADRAPLEX RECEPTACLE-(IVORY)	18"
	120V. QUADRAPLEX RECEPTACLE-(IVORY)	AS SPECIFIED
	SINGLE RECEPTACLE-TWISTLOCK TYPE (120V.-20A. UNLESS OTHERWISE SPECIFIED)	18"
	GROUND FAULT TYPE RECEPTACLE-(IVORY)	AS SPECIFIED
	GROUND FAULT RECEPTACLE WEATHERPROOF	AS SPECIFIED
ABBREVIATIONS		
AFF	ABOVE FINISHED FLOOR	
AFG	ABOVE FINISHED GRADE	
FBE	FURNISHED & INSTALLED BY ELECTRICAL CONTRACTOR	
FBO	FURNISHED BY OTHERS, INSTALLED BY ELECTRICAL CONTRACTOR	
GND	GROUND	
UON	UNLESS OTHERWISE NOTED	
WP	WEATHER PROOF, NEMA 3R	

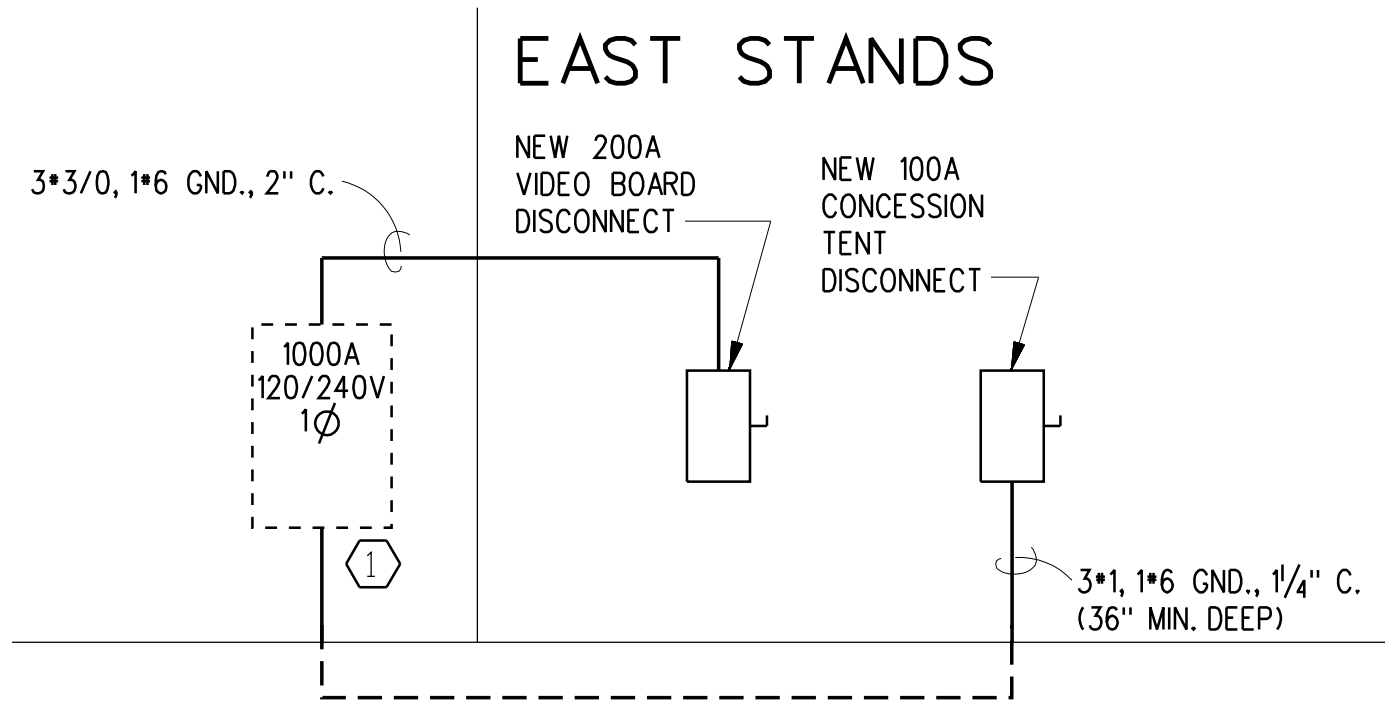


PARTIAL RISER DIAGRAM

NO SCALE


ELECTRICAL NOTES:

1. PROVIDE NEW 200A/2P AND 100A/1P BREAKER IN EXISTING PANEL. EXISTING PANEL IS A WESTINGHOUSE CDP STYLE PANELBOARD. MATCH BREAKER AIC RATING WITH THAT OF PANEL. REMOVE EXISTING SET OF CONDUCTORS CURRENTLY CUT OFF IN PANELBOARD.

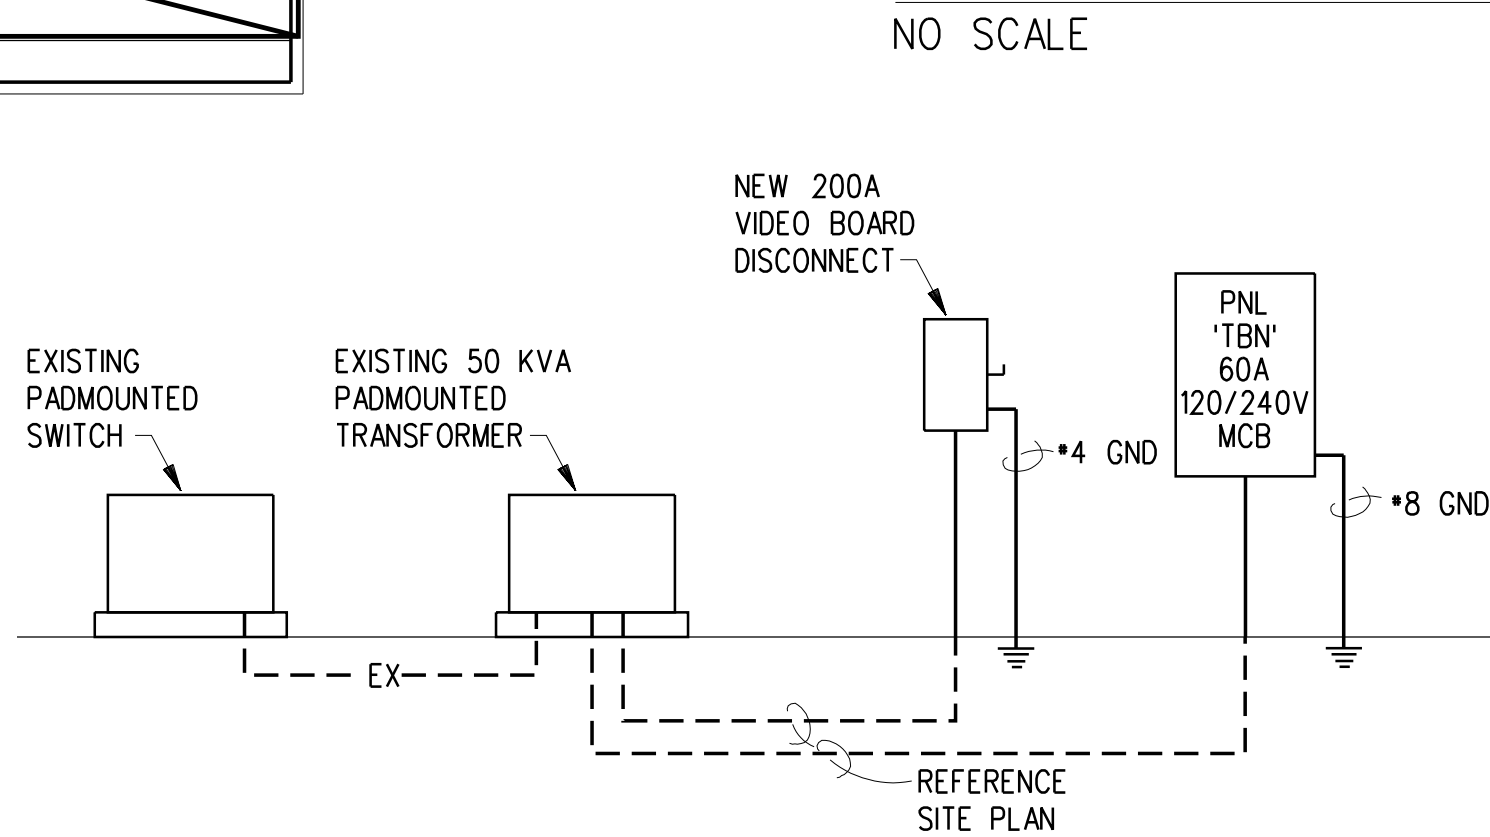

NORTH RISER DIAGRAM

NO SCALE

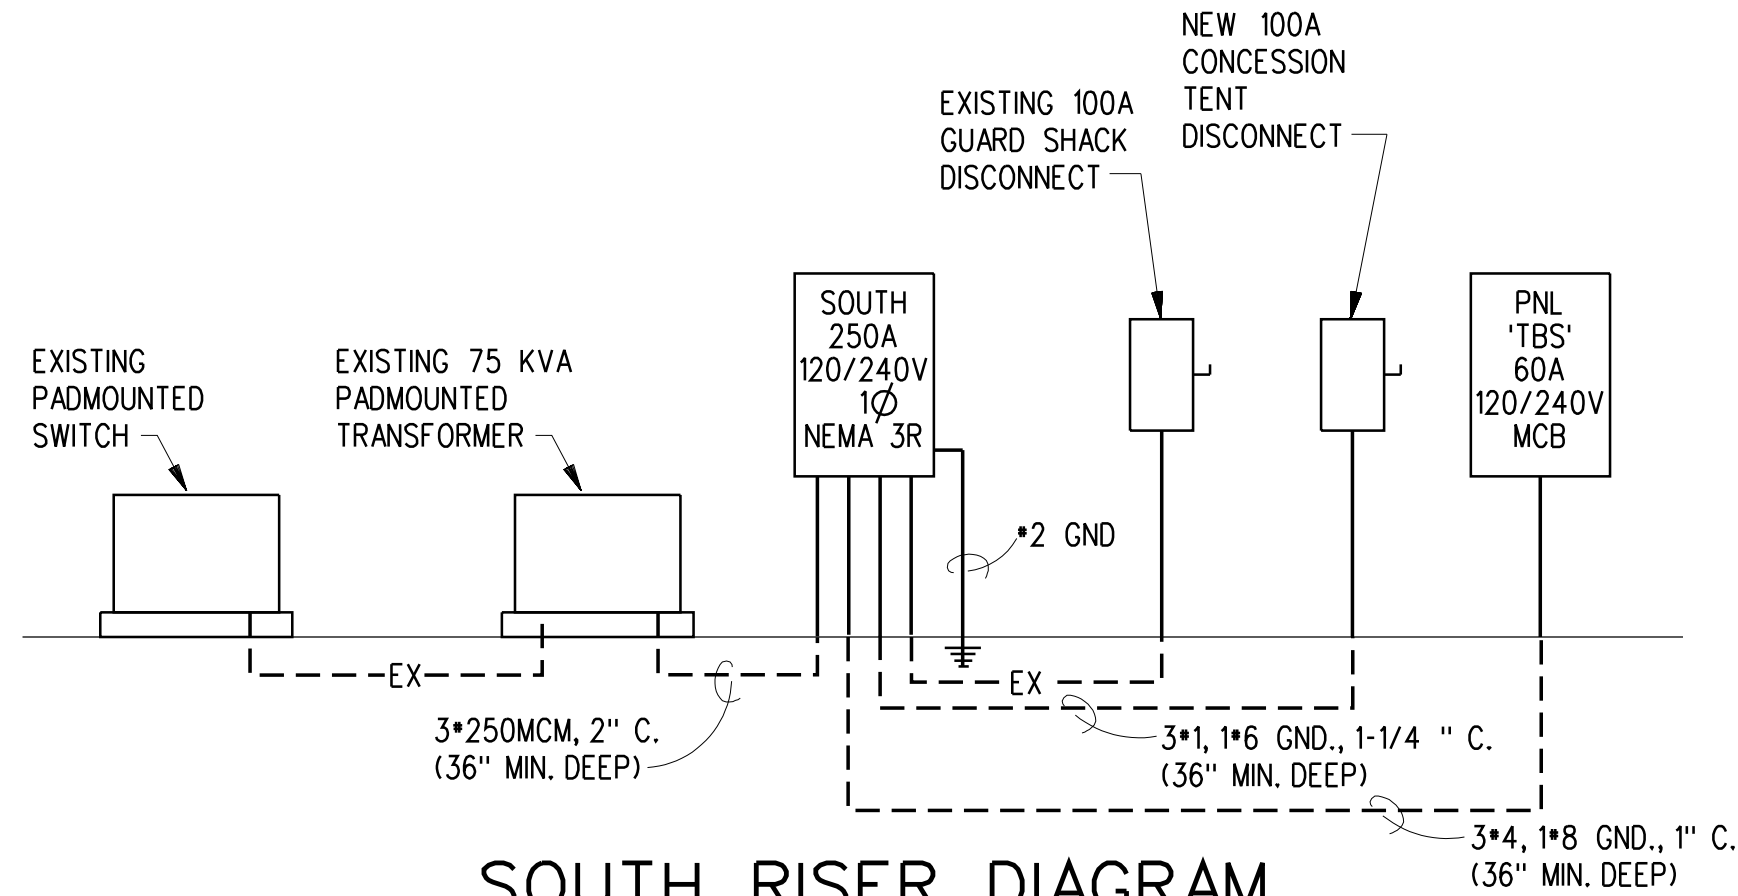

SOUTH RISER DIAGRAM

NO SCALE



ARCHITECTURE
ENGINEERING
PLANNING
INTERIORS

HART FREELAND ROBERTS, INC.
7101 Executive Center Drive
Suite 300
Brentwood, TN 37024

615.370.8500 phone
615.370.8530 fax
www.hfrdesign.com web

Nashville, Tennessee
Jackson, Tennessee
Kansas City, Missouri
Louisville, Kentucky




ADD#2 5-16-12


HALE STADIUM RENOVATIONS
NORTH AND SOUTH ENTRIES
TENNESSEE STATE UNIVERSITY
JOHN A MERRITT BLVD
NASHVILLE, TN
SBC# 166/001-02-2011

PROJ. NO.: 2011171

DATE: 25 APRIL 2012

ELECTRICAL-
LEGEND

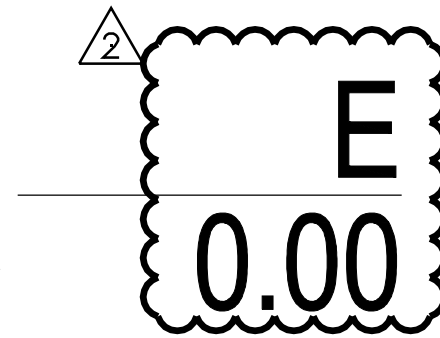

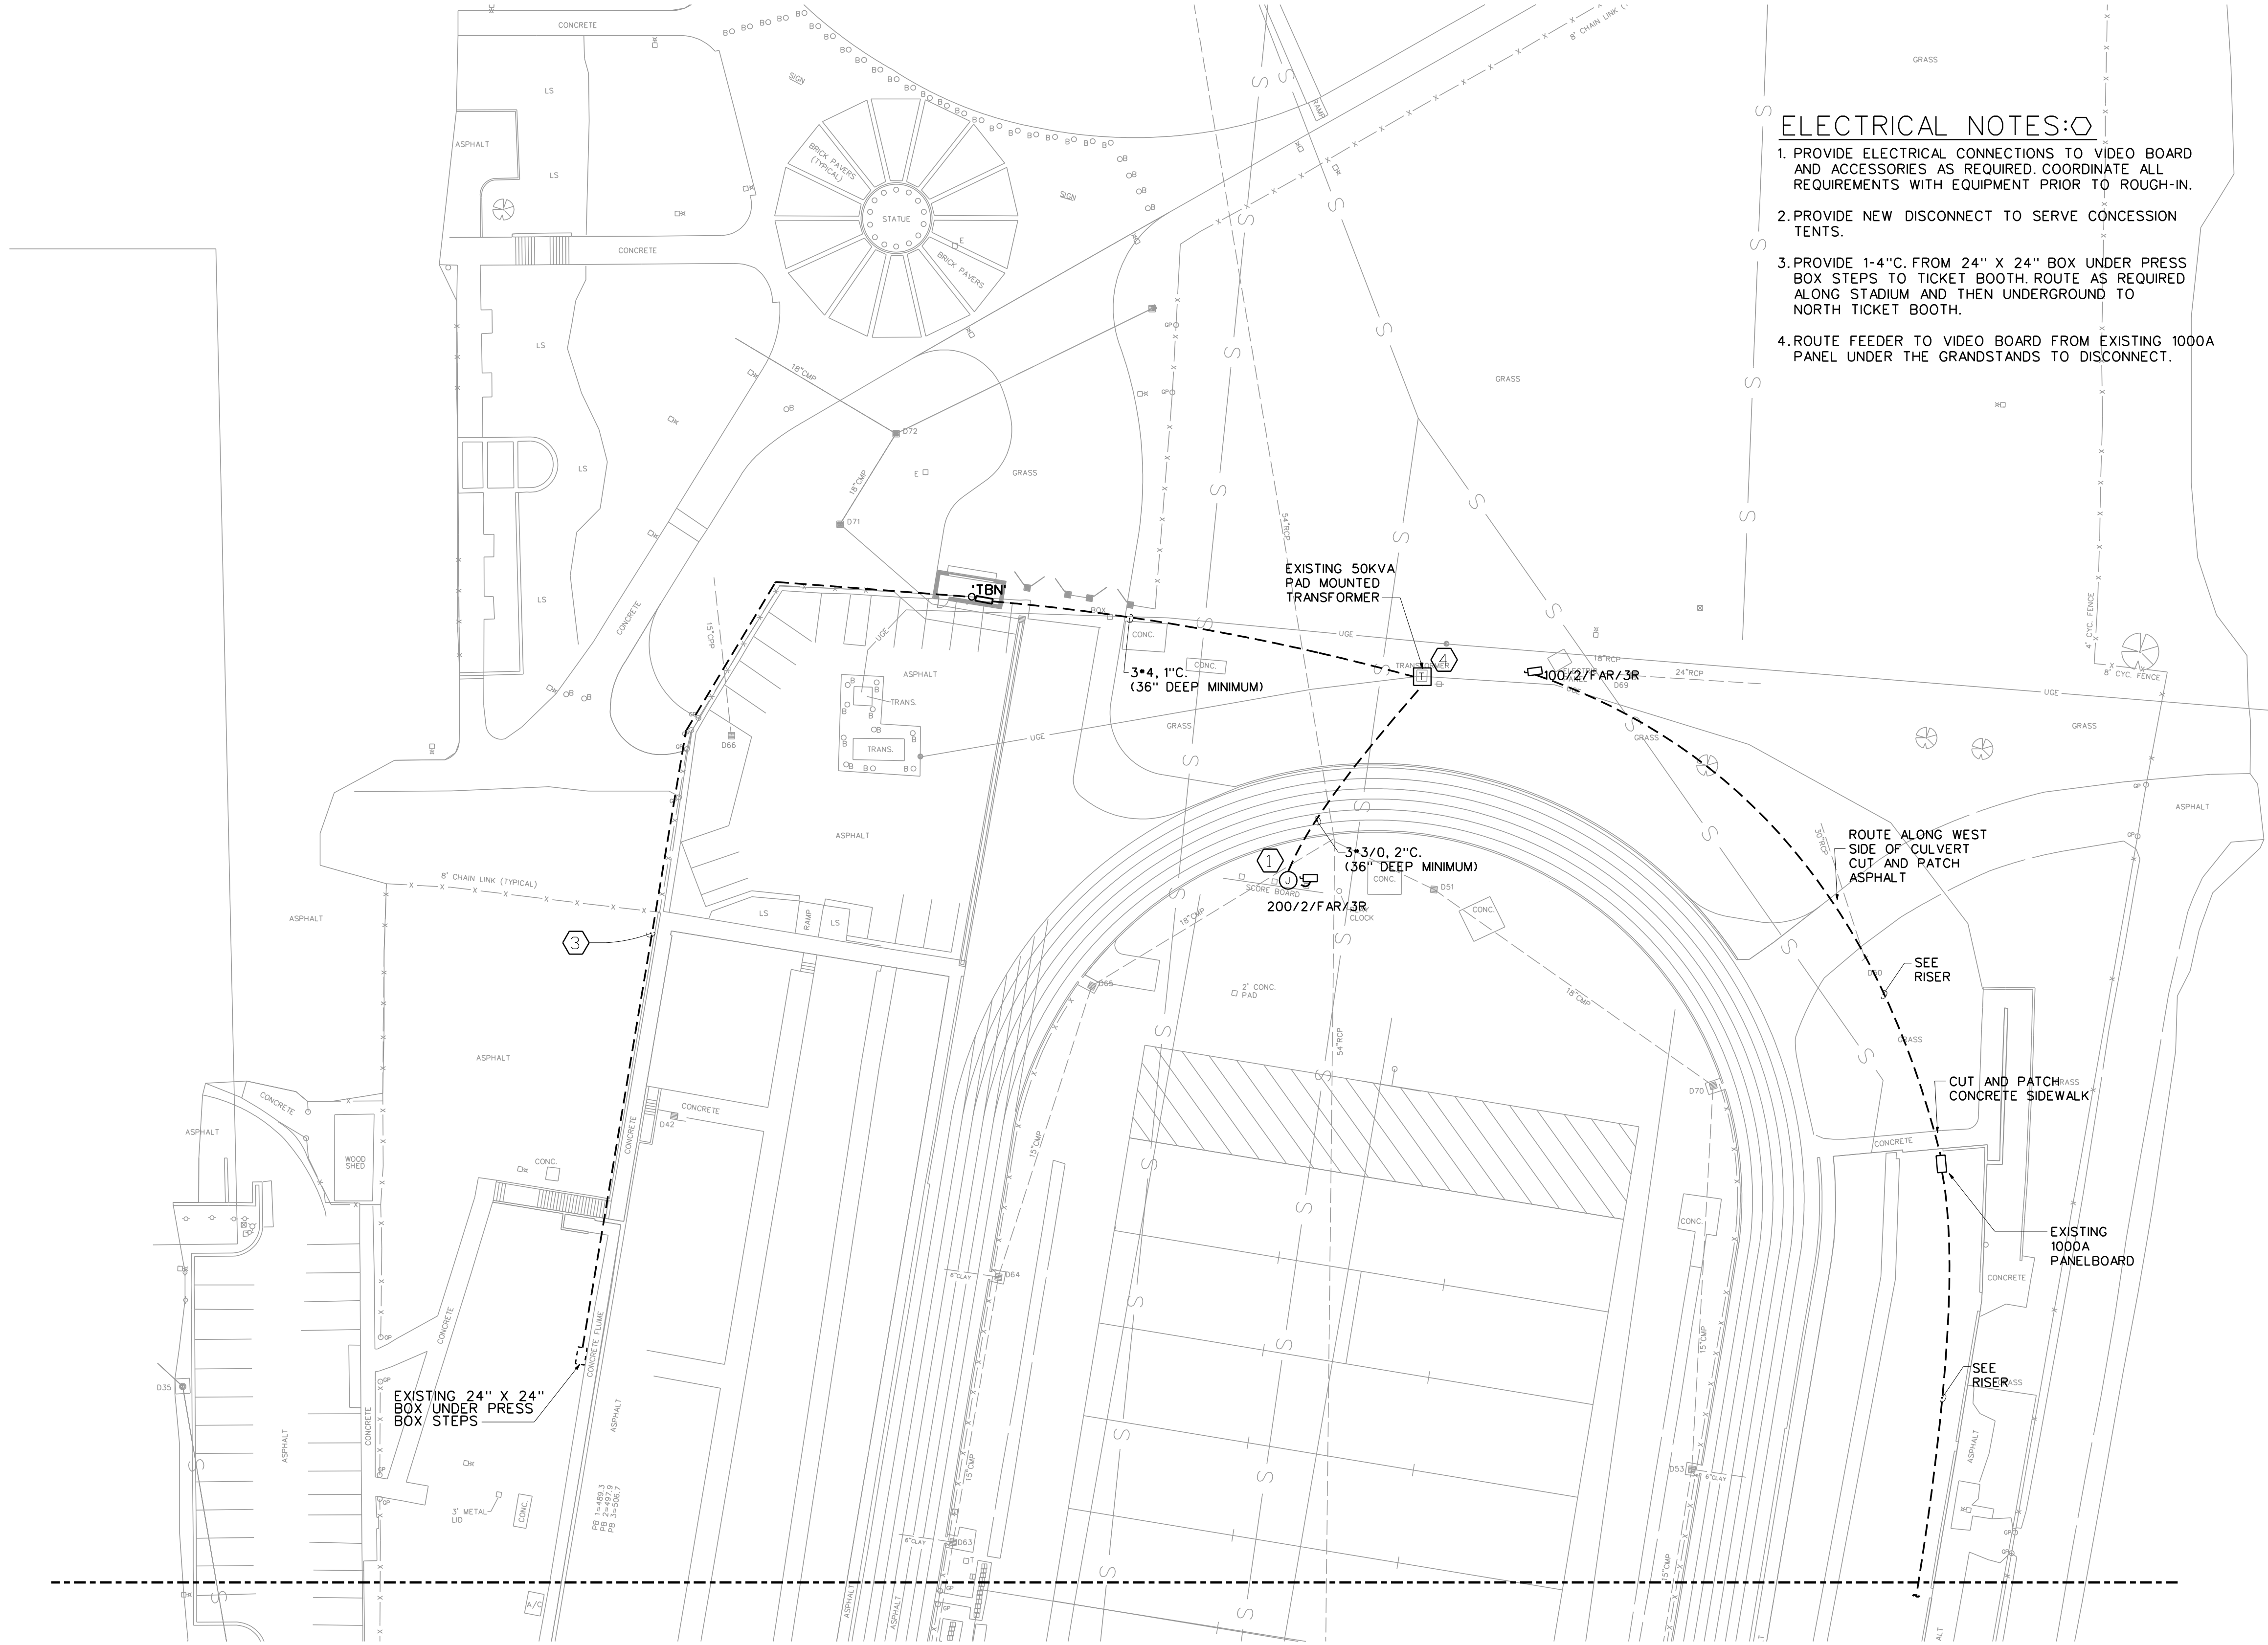

ELECTRICAL - SITE PLAN

SCALE: 1"=30'-0"




ARCHITECTURE
ENGINEERING
PLANNING
INTERIORS

HART FREELAND ROBERTS, INC.
7101 Executive Center Drive
Suite 300
Brentwood, TN 37024

615.370.8500 phone
615.370.8530 fax
www.hfrdesign.com web

Nashville, Tennessee
Jackson, Tennessee
Kansas City, Missouri
Louisville, Kentucky

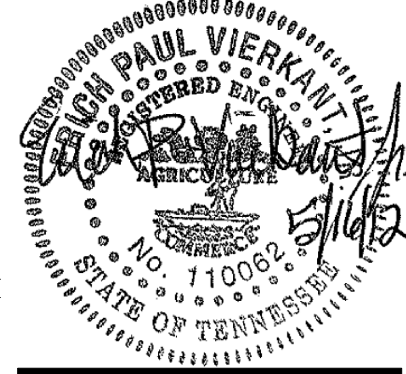

ADD#2 5-16-12

HALE STADIUM RENOVATIONS
NORTH AND SOUTH ENTRIES
TENNESSEE STATE UNIVERSITY
JOHN A MERRITT BLVD
NASHVILLE, TN
SBC# 166/001-02-2011

PROJ. NO.: 2011171

DATE: 25 APRIL 2012

ELECTRICAL -
SITE PLAN



© COPYRIGHT --- ALL RIGHTS RESERVED. NO PORTION(S) OF THIS DOCUMENT MAY BE REPRODUCED WITHOUT THE EXPRESSED WRITTEN CONSENT OF HART FREELAND ROBERTS, INC.




ARCHITECTURE
ENGINEERING
PLANNING
INTERIORS

HART FREELAND ROBERTS, INC.
7101 Executive Center Drive
Suite 300
Brentwood, TN 37024

615.370.8500 phone
615.370.8530 fax
www.hfrdesign.com web

Nashville, Tennessee
Jackson, Tennessee
Kansas City, Missouri
Louisville, Kentucky

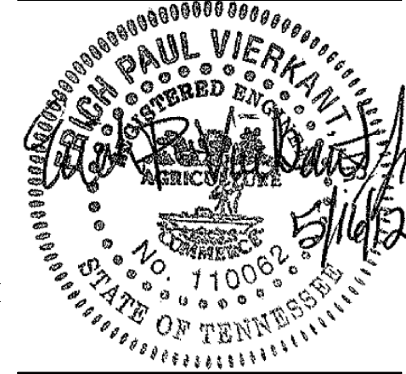

ADD#2 5-16-12


HALE STADIUM RENOVATIONS
NORTH AND SOUTH ENTRIES
TENNESSEE STATE UNIVERSITY
JOHN A MERRITT BLVD
NASHVILLE, TN
SBC# 166/001-02-2011

PROJ. NO.: 2011171

DATE: 25 APRIL 2012

LIGHTING-
FLOOR PLANS


E
1.01

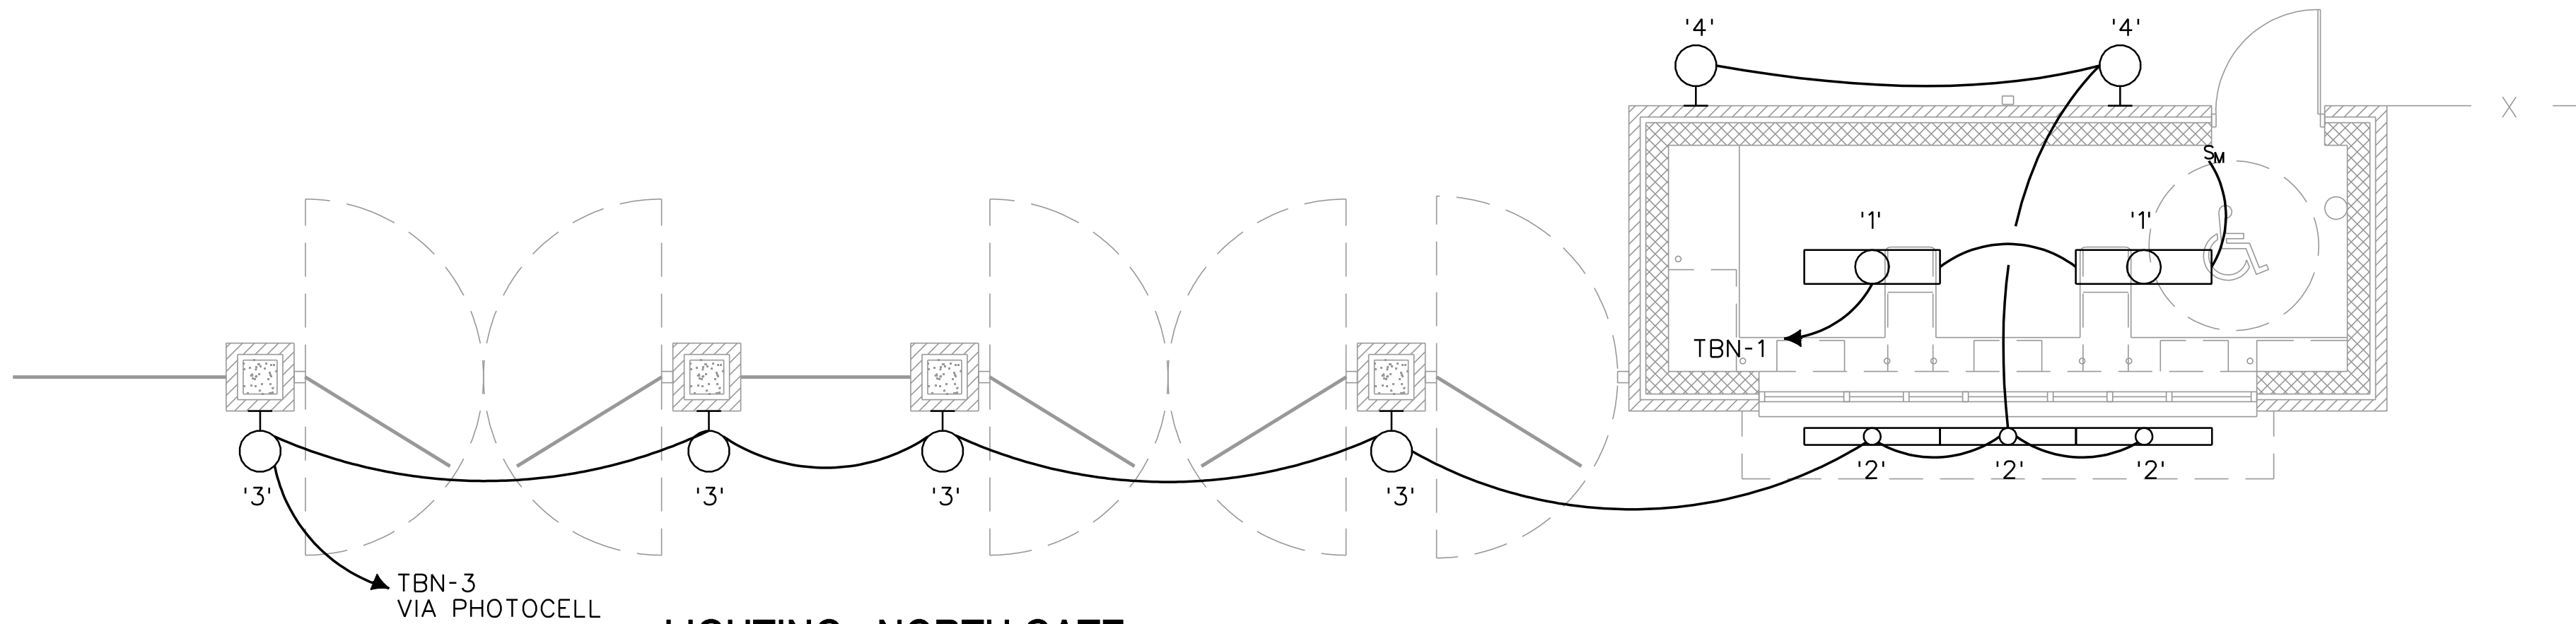

LIGHTING - NORTH GATE
FLOOR PLAN

0 2 4 8
1/4" = 1'-0"


FIXTURE SCHEDULE					
TYPE	MANUFACTURER	CATALOG NUMBER	NUMBER & SIZE LAMPS	MOUNT	REMARKS
1	LSI	EG32W32SS010UE	2-32WT8	SURFACE	SURFACE MOUNT LIGHT-END FEED
2	LSI	FC232SS0IBUE	2-32WT8	SURFACE	UPLIGHT-LOCATE REMOTE BALLAST INSIDE TICKET BOOTH
3	KENALL	RHL720CMBPIA2-26QDV	2-26WCFL	SURFACE	COLUMN LIGHT
	KIM	WMD360-3/120B	LED	SURFACE	WALL-BACK
E1A	KIM	FM/CCS173/PT/ 60L5K3/BL/ PRA14-5125FM/BL	LED	POLE	CAMPUS STANDARD PEDESTRIAN POLE

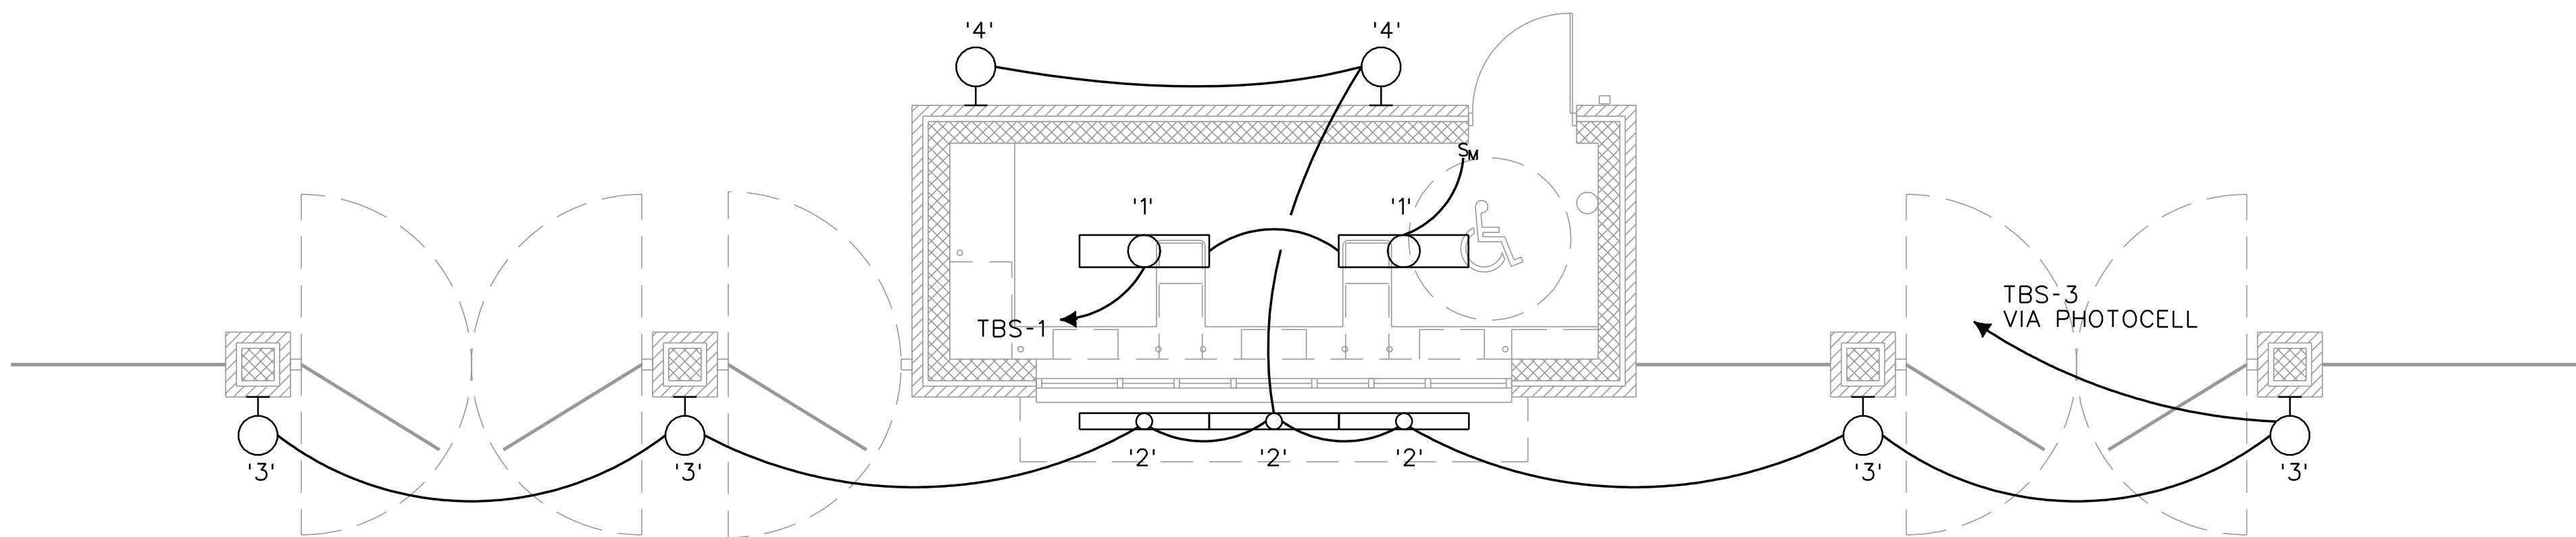

LIGHTING - SOUTH GATE
FLOOR PLAN

0 2 4 6
1/4" = 1'-0"

© COPYRIGHT --- ALL RIGHTS RESERVED. NO PORTION(S) OF THIS DOCUMENT MAY BE REPRODUCED WITHOUT THE EXPRESSED WRITTEN CONSENT OF HART FREELAND ROBERTS, INC.

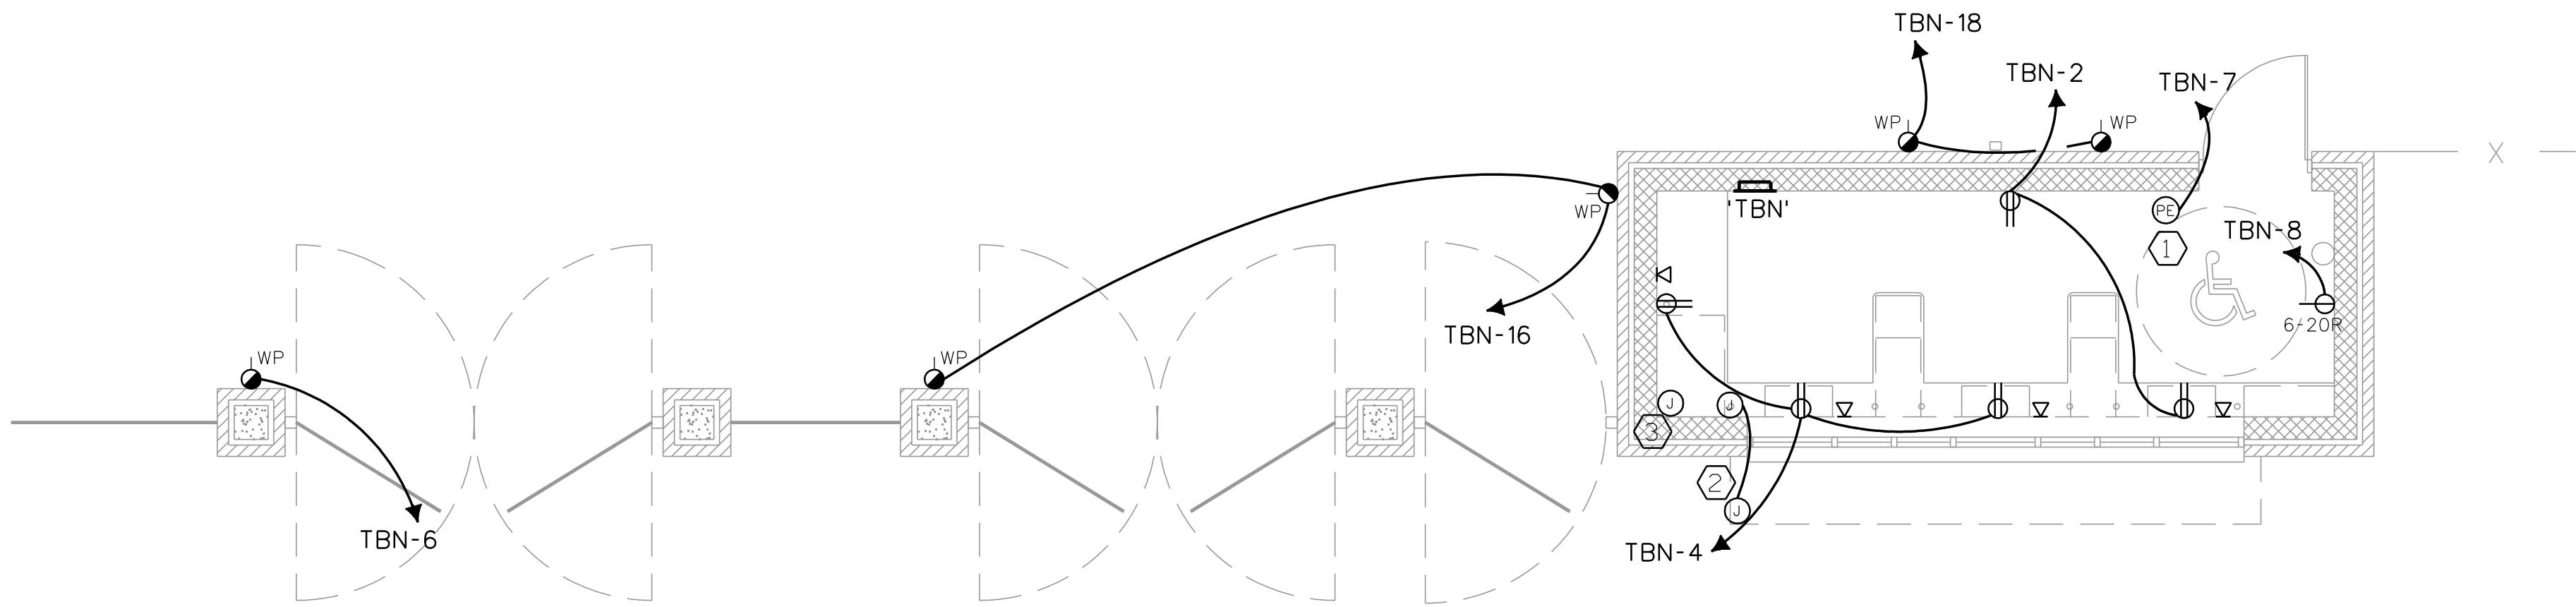


POWER & SYSTEMS - NORTH GATE
FLOOR PLAN

0 2 4 6
1/4" = 1'-0"

ELECTRICAL NOTES:

1. LOCATE PHOTOCELL ON ROOF FACING NORTH.
2. PROVIDE JUNCTION BOX IN CANOPY FOR OWNER PROVIDED SECURITY CAMERA. STUB 1" C. INTO TICKET BOOTH.
3. PROVIDE JUNCTION BOX FOR OWNER PROVIDED SECURITY CAMERA.

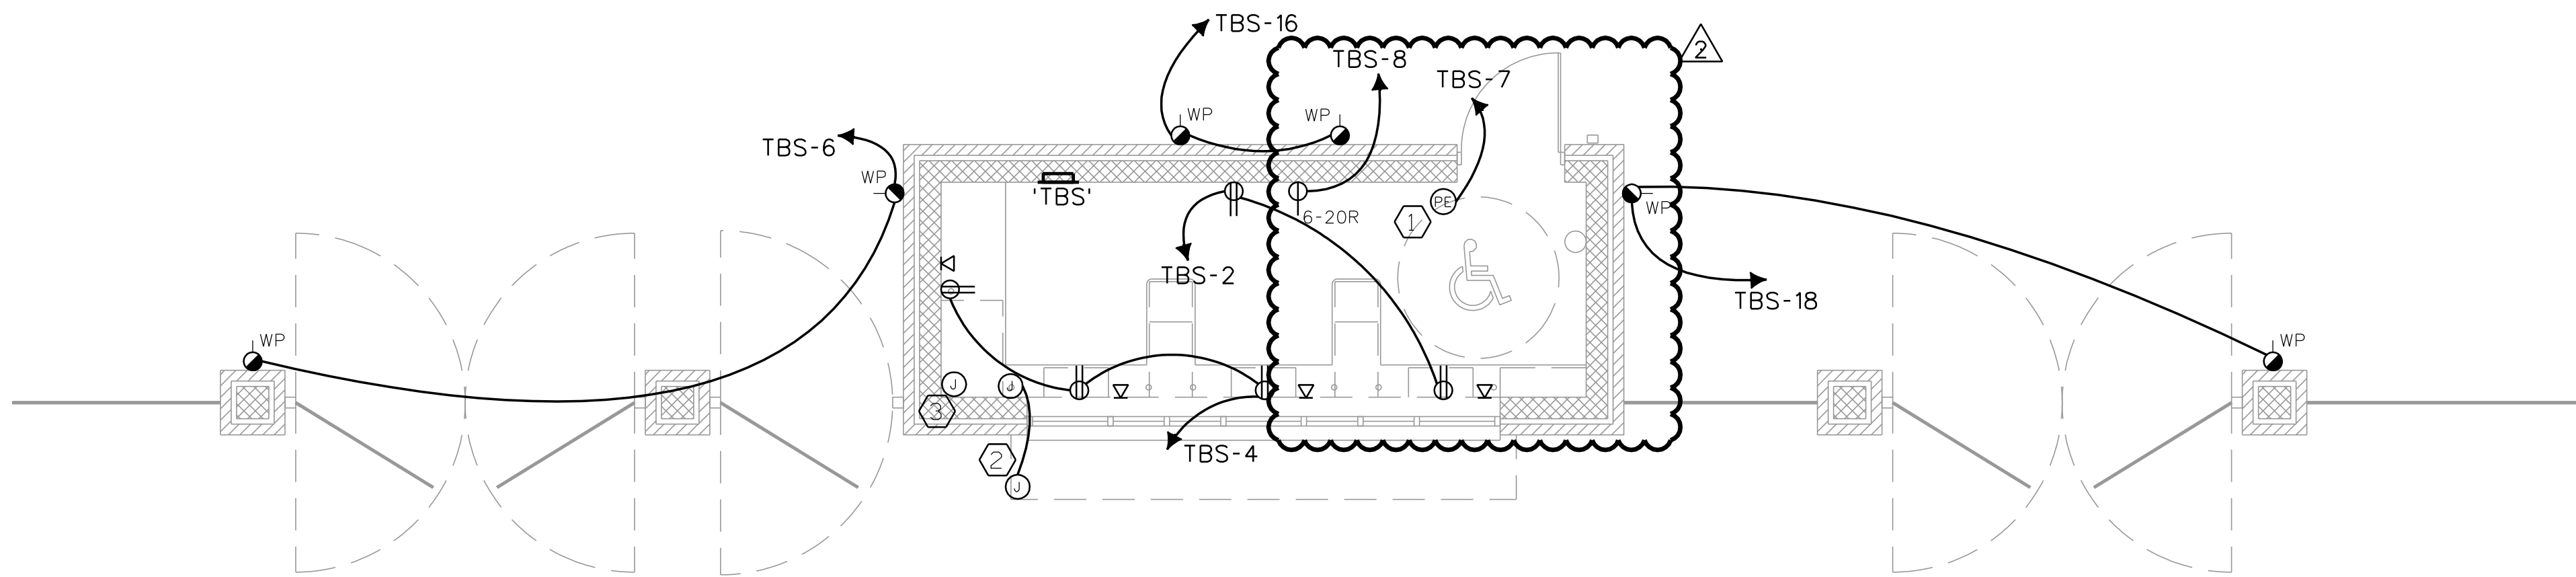

POWER & SYSTEMS - SOUTH GATE
FLOOR PLAN

0 2 4 6
1/4" = 1'-0"



I.C. Thomason Associates, Inc.
CONSULTING ENGINEERS
2950 KRAFT DRIVE, SUITE 500
NASHVILLE, TENNESSEE 37204
PHONE (615) 346-3400
FAX (615) 346-3550
ICT PROJECT No. 110477




**ARCHITECTURE
ENGINEERING
PLANNING
INTERIORS**

HART FREELAND ROBERTS, INC.
7101 Executive Center Drive
Suite 300
Brentwood, TN 37024

615.370.8500 phone
615.370.8530 fax
www.hfrdesign.com web

Nashville, Tennessee
Jackson, Tennessee
Kansas City, Missouri
Louisville, Kentucky

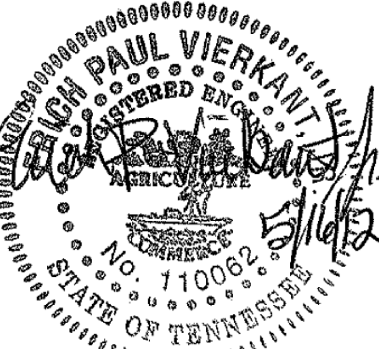

ADD#2 5-16-12

**HALE STADIUM RENOVATIONS
NORTH AND SOUTH ENTRIES
TENNESSEE STATE UNIVERSITY**
JOHN A MERRITT BLVD
NASHVILLE, TN
SBC# 166/001-02-2011

PROJ. NO.: 2011171

DATE: 25 APRIL 2012

**POWER &
SYSTEMS-
FLOOR PLANS**

**E
2.01**